
AMBIT LAND SURVEYING
P. O. Box 42
Bassett, WI. 53101

PLAT OF SURVEY

PHONE 262-537-4874
FAX 262-537-4221

OF

Unit 18-07 in GENEVA NATIONAL CONDOMINIUM NO. 18, located in the West Half of the Northeast Quarter and in the East Half of the Northwest Quarter and in the Northeast Quarter of the Southwest Quarter and the Northwest Quarter of the Southeast Quarter of Section 29, Township 2 North, Range 17 East of the 4th Principal Meridian, Town of Geneva, Walworth County, Wisconsin.

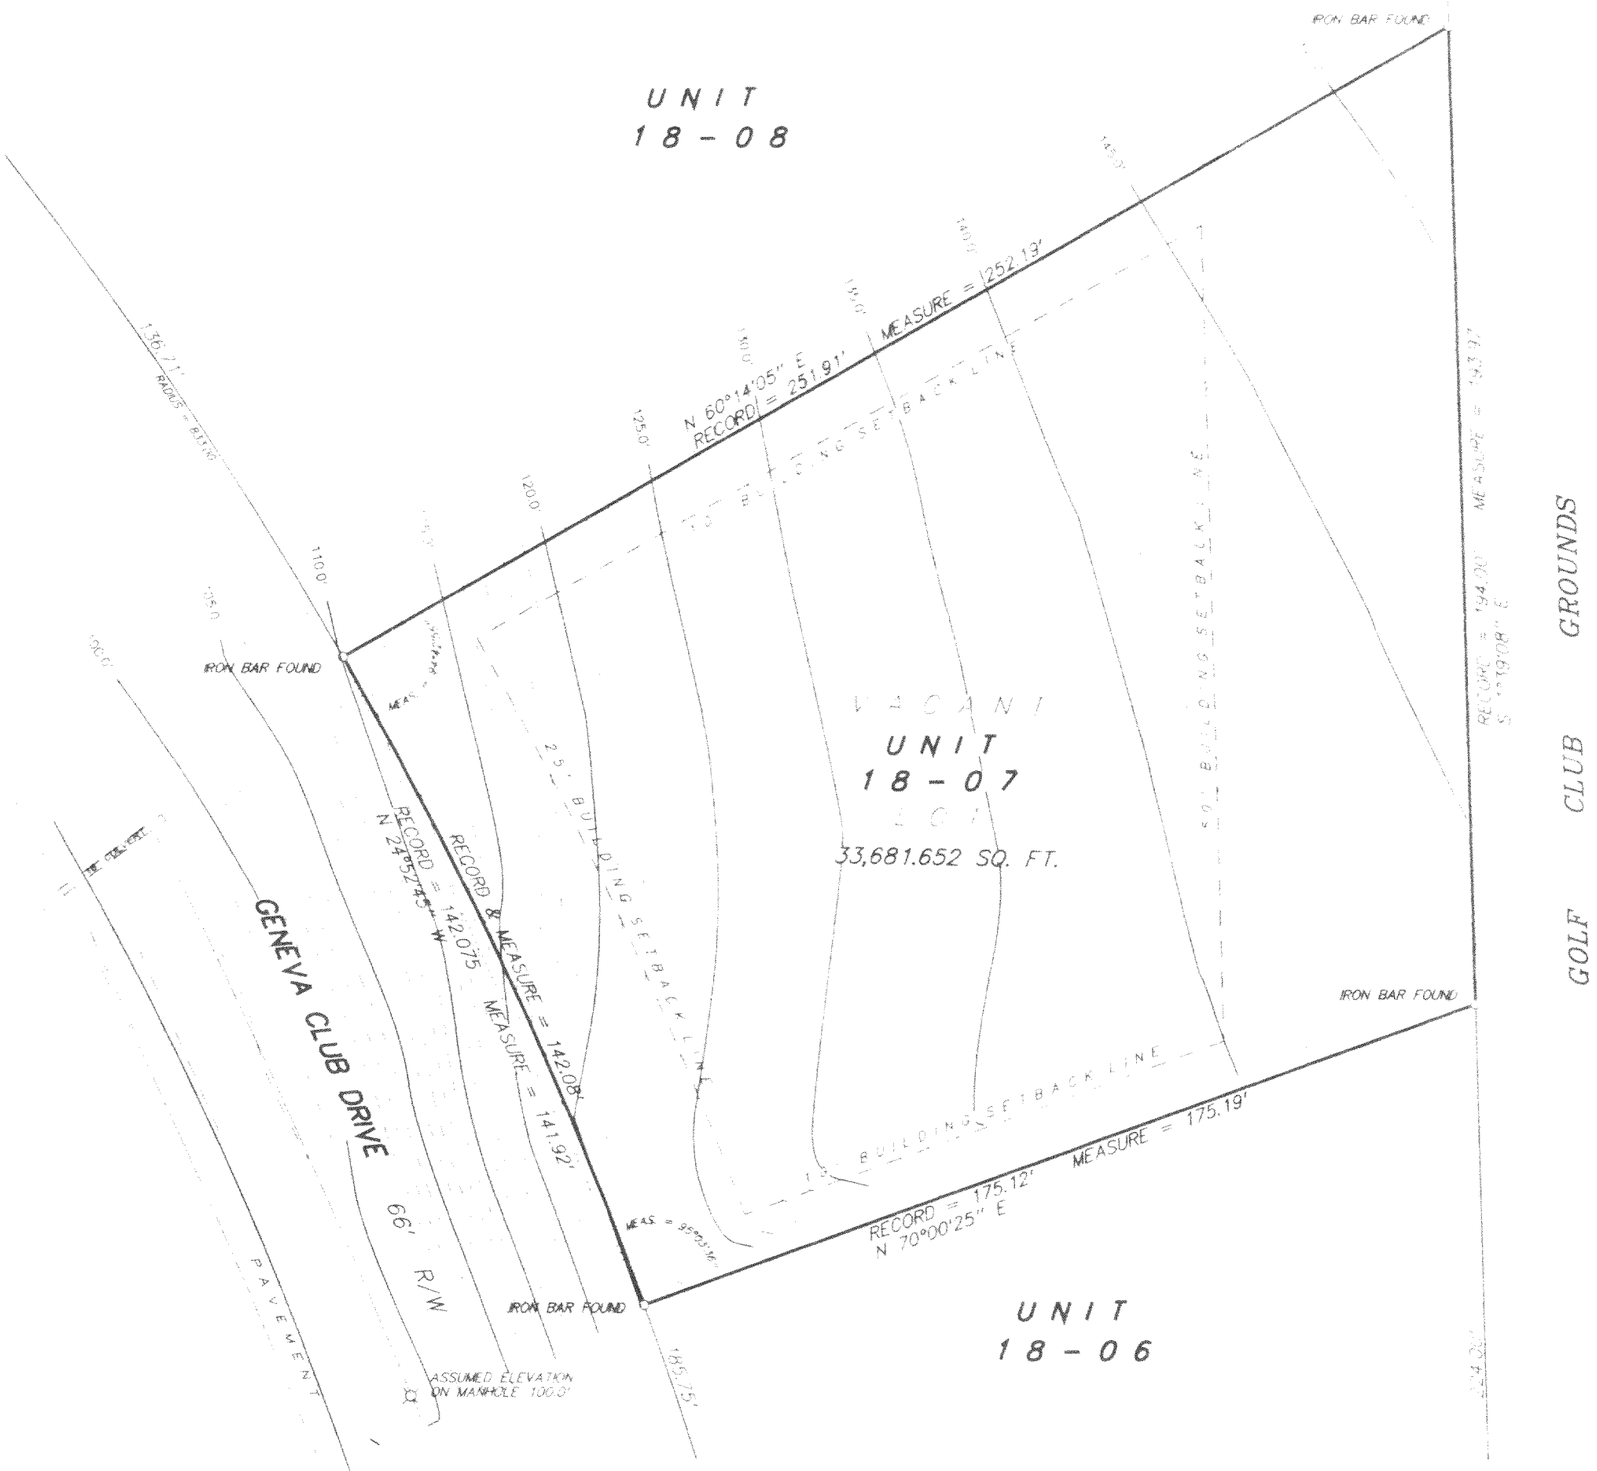

SCALE 1 inch = 30 feet
ORDERED BY D. Bark / Keefe Real Estate
JOB NO. 03099

RECEIVED
JUN - 5 2003
KW

I hereby certify that I have surveyed the above described property and the above plat is a true representation thereof and shows the size and location of the property, its exterior boundaries, the location and dimensions of all visible structures thereon, boundary fences, apparent easements and roadways and visible encroachments, if any.

This survey is made for the exclusive use of the present owners of the property, and also those who purchase, mortgage, or guarantee the title thereto within one year from the date hereof.

Dated at Bassett, Wisconsin this _____ day of _____, 2003

Mark A. Bolender
Wisconsin Registered Land Surveyor S - 1784

JGN18-7

217-2573