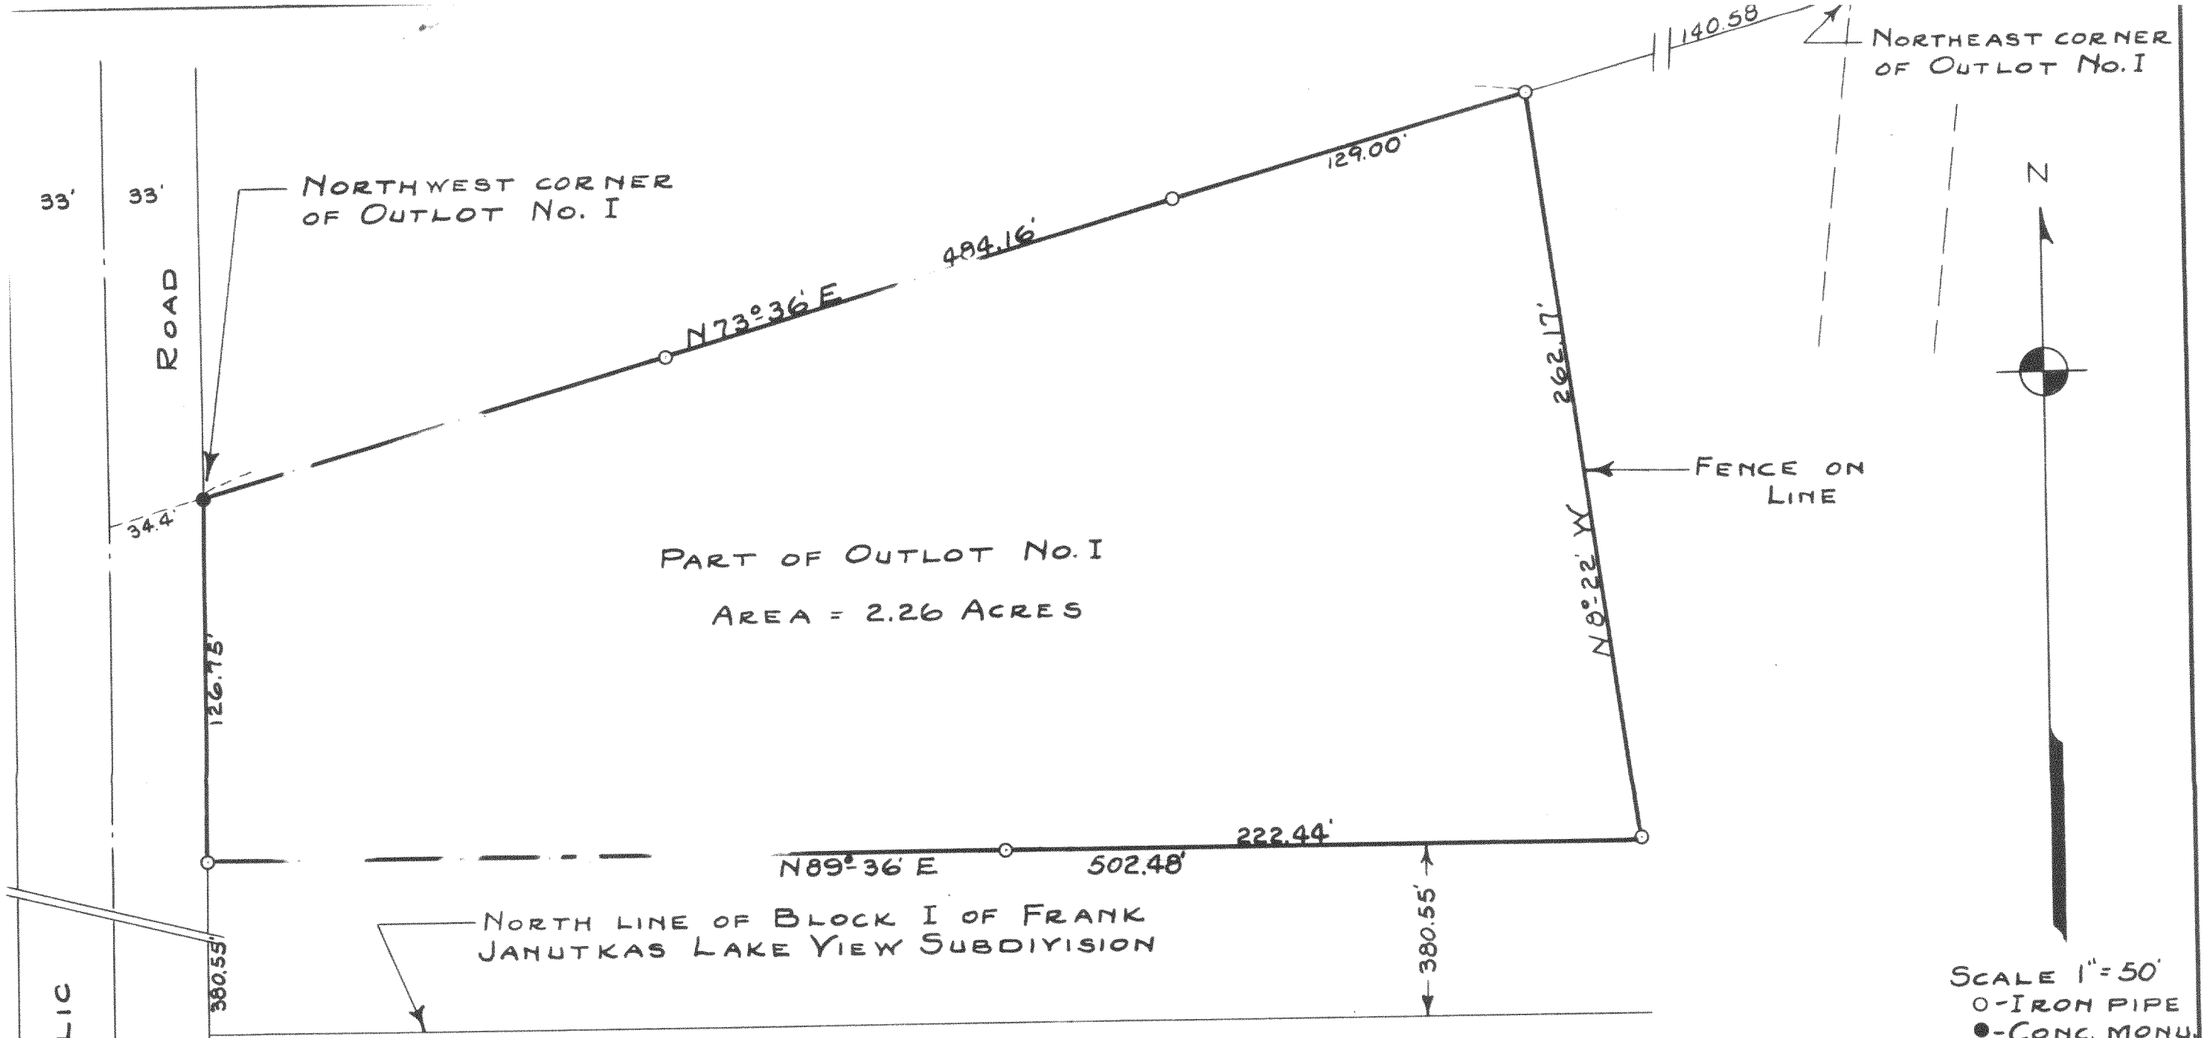


PLAT OF SURVEY OF PART OF OUTLOT No. I OF FRANK JANUTKAS LAKE VIEW SUBDIVISION, LOCATED IN SECTION 31, T2N R17E OF WALWORTH COUNTY WISCONSIN.

Nov. 1944 JLA-V-13

Lloyd L. Jensen
COUNTY SURVEYOR

217-26.1