
PREPARED FOR;
MIKRUT BUILDERS
N3402 CLUBHOUSE DR.
LAKE GENEVA WI 53147

PLAT OF SURVEY

-OF-

J.K. SURVEYING INC.
N3705 WILLOWBEND LANE
LAKE GENEVA, WI, 53147
262-248-3697

LOTS 11662 - 11670 AND 11689 - 11690 BLOCK 210 OF LAKE COMO BEACH SUBDIVISION;
LOCATED IN TOWN 2 NORTH, RANGE 17 EAST, WALWORTH COUNTY, WISCONSIN

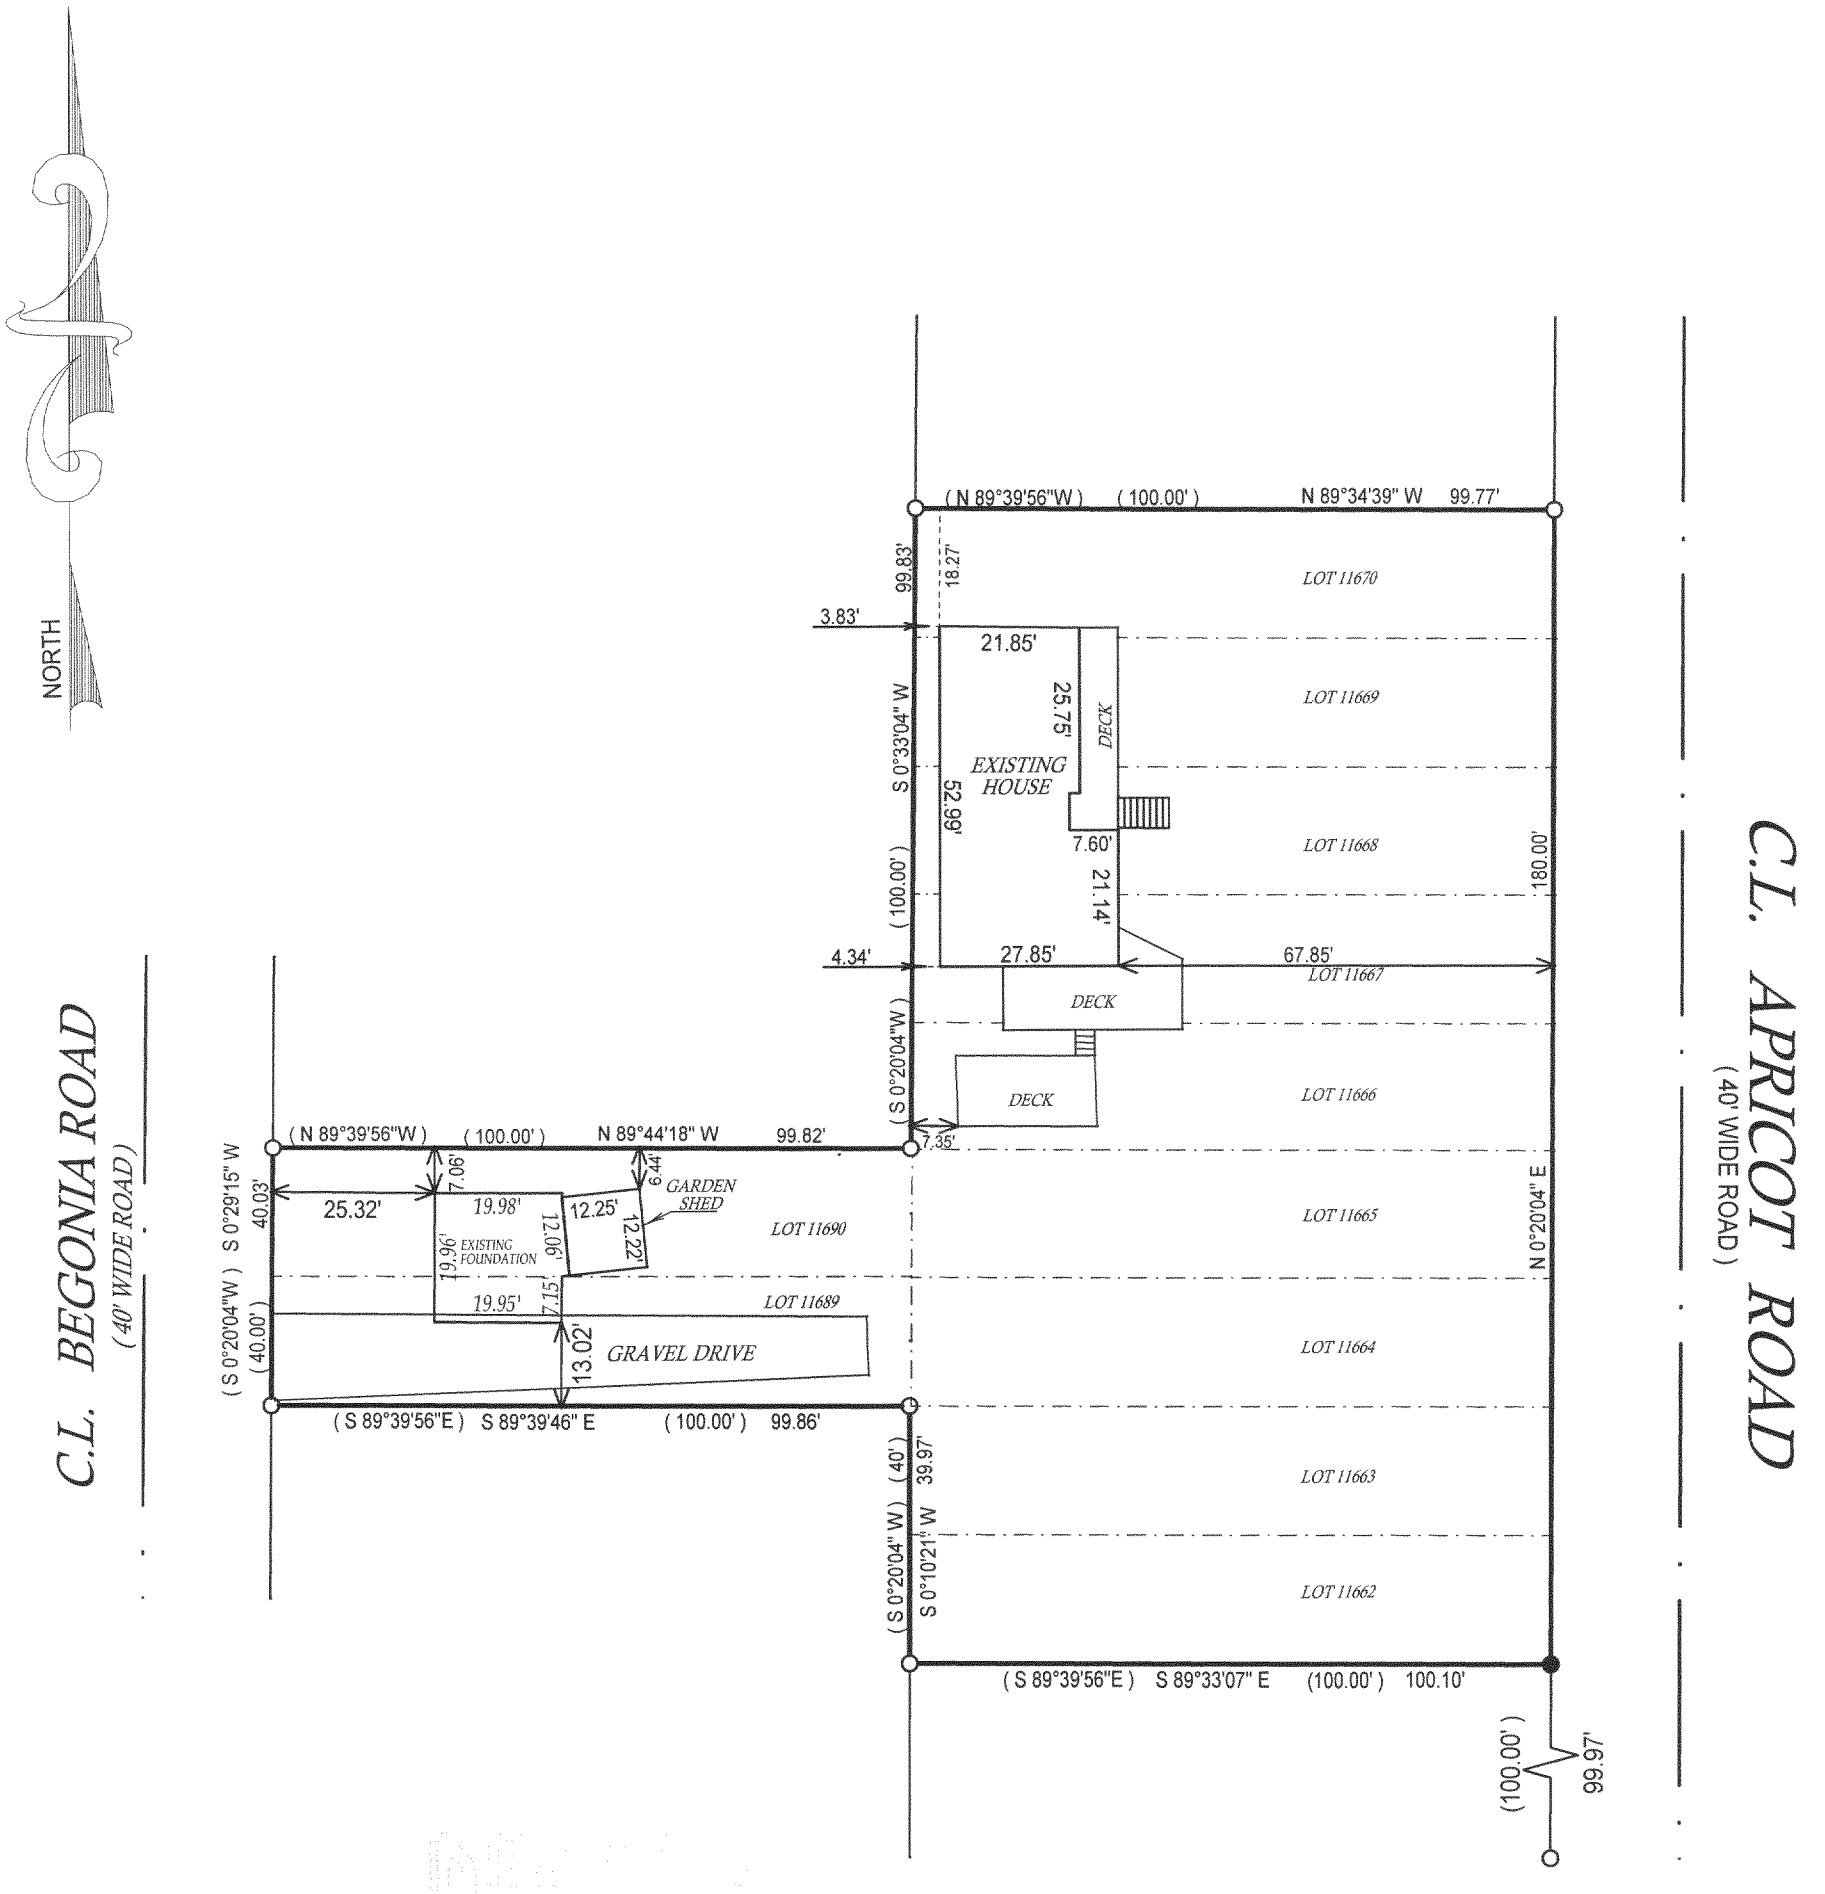

( ) = recorded as
□ = found iron bar
○ = found iron pipe
● = set iron pipe
■ = set iron bar
SCALE 1" = 30'
JOB # 02-429
TAX ID # JLCB 02536 - 02543

DATE OF LAST REVISION 06 / 03 / 03
REVISED 10-3-02

COMPARE LEGAL DESCRIPTION ABOVE AND DRAWING WITH DEED. FOR BUILDING RESTRICTIONS AND EASEMENTS NOT SHOWN,REFER TO DEED, ABSTRACT SOURCES AND LOCAL MUNICIPAL CODES. NOTIFY THE SURVEYOR IMMEDIATELY OF ANY DISCREPANCY.

"I hereby certify that the above described property was surveyed under my supervision and that the above map is a true representation thereof and shows the size and location of all visible structures, apparent easements and encroachments if any."
This survey is made for the present owners of the property, and those who purchase, mortgage, or guarentee the title thereto, within one year from the date hereof.

DATED THIS 29 TH, DAY OF AUGUST 20 02

WISCONSIN
JEFFERY L. KIMPS
2436
LAKE GENEVA, WIS.
LAND SURVEYOR

JEFFREY L. KIMPS S - 2436
Wisconsin Registered Land Surveyor
(original if signed in red)

OCT - 3

ORP

217-2690