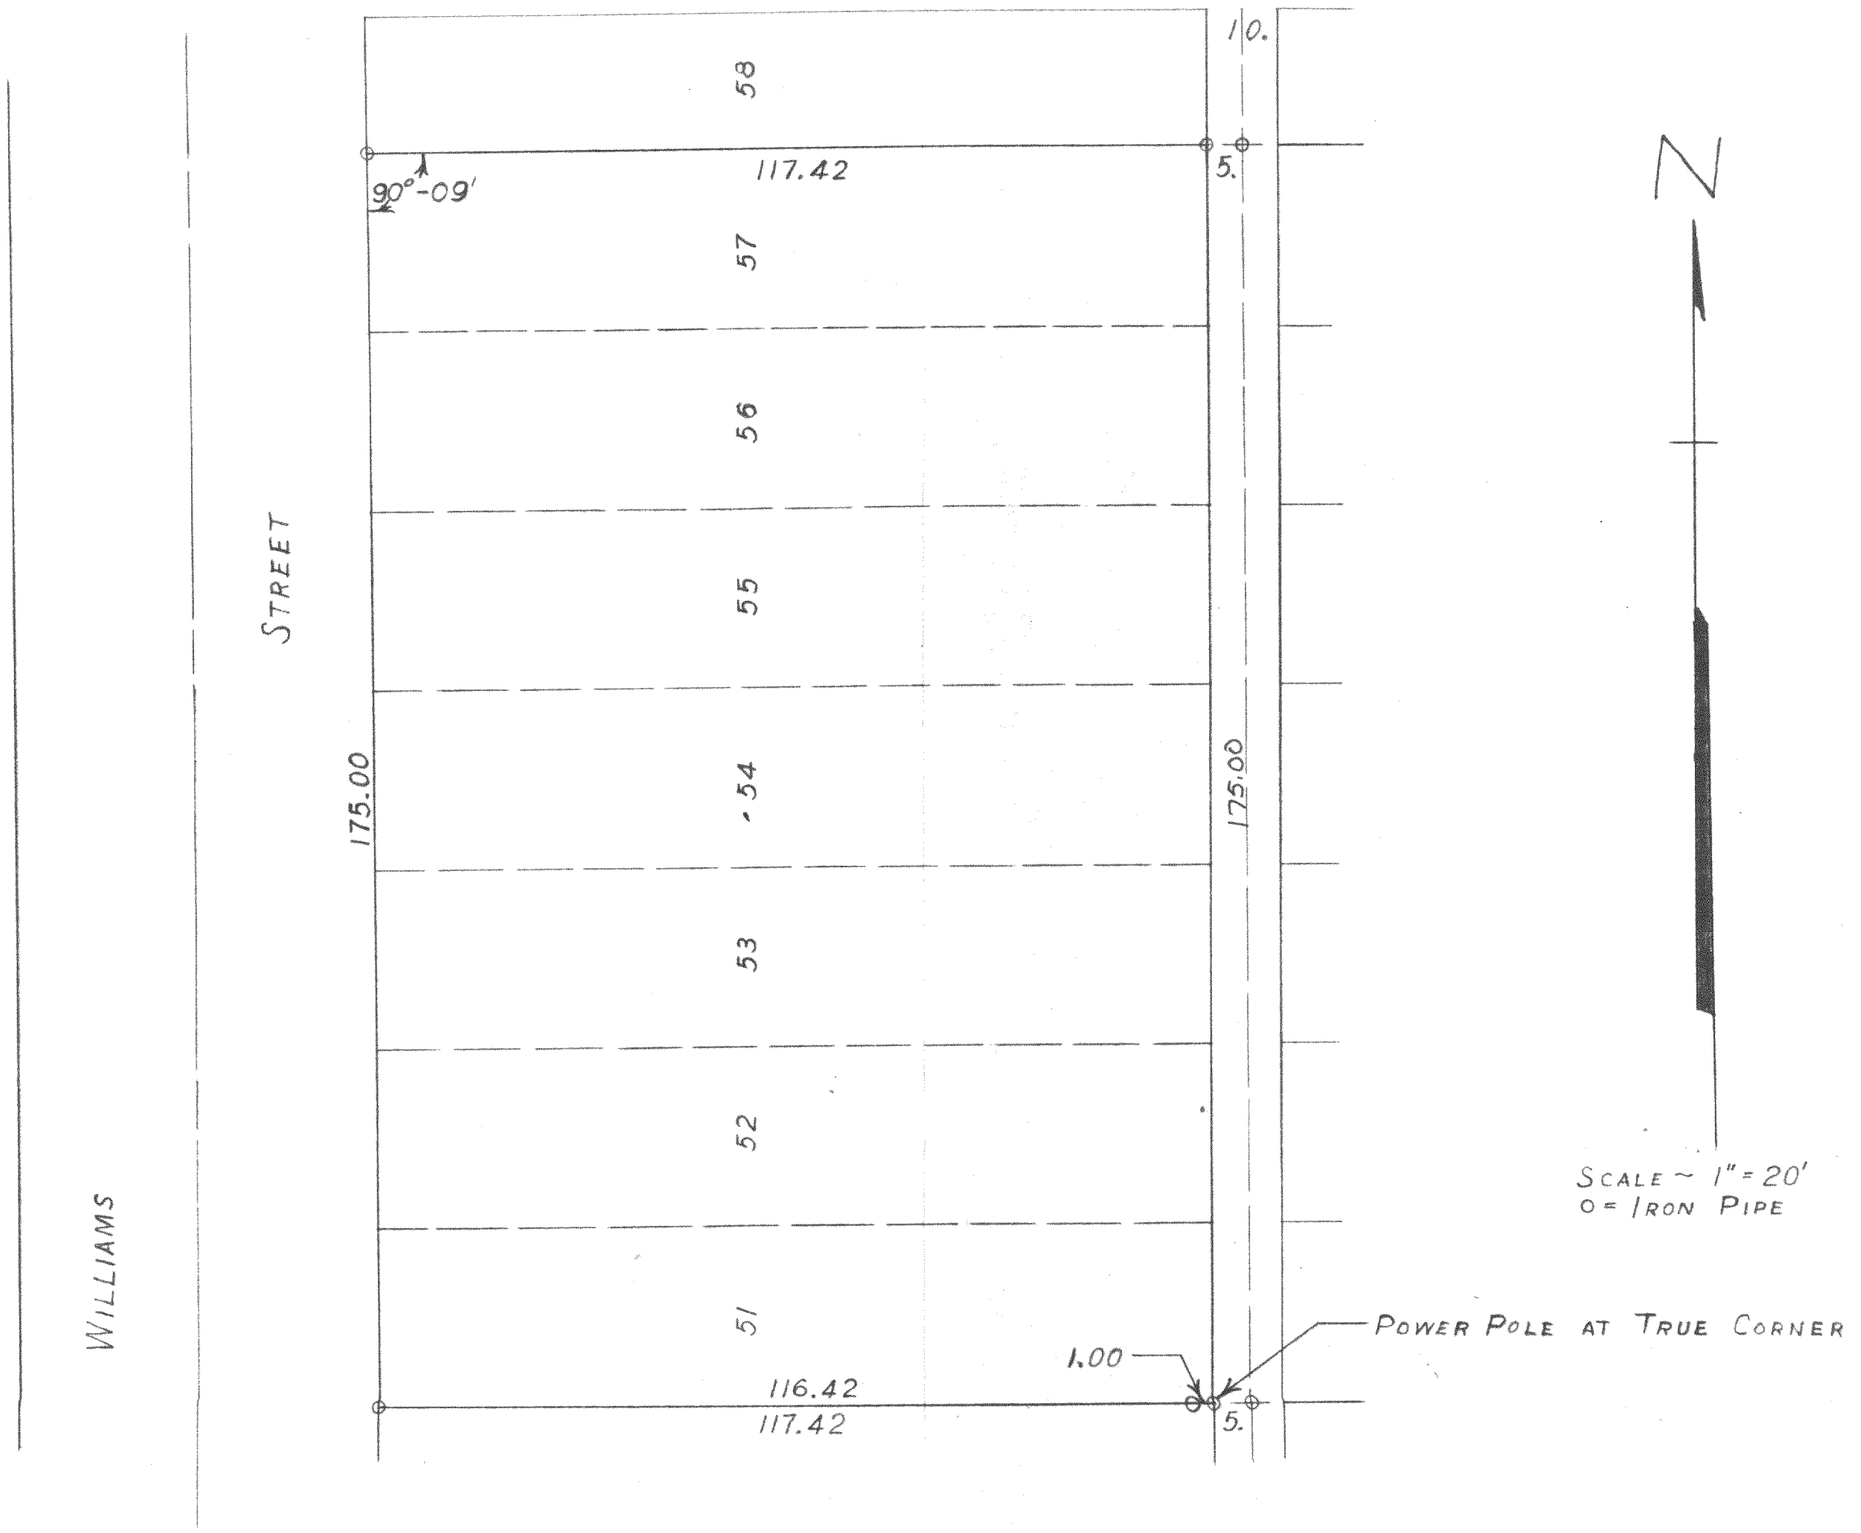


PLAT OF SURVEY OF LOTS 51 – 57 INCLUSIVE OF THE GUMMOW ADDITION, ~~CITY OF~~ Town of Geneva
~~LAKE~~ GENEVA, WALWORTH COUNTY, WISCONSIN
MAY 15, 1956

George T. Dunham
GEORGE T. DUNHAM, SURVEYOR
DELAVAN, WISCONSIN

217-27D