
ABERNATHY and ASSOCIATES
Kenneth B. Abernathy Jr.
Wisconsin Registered Land Surveyor S-1594

W4056 BRAY RD.
ELKHORN, WI. 53121
PHONE: (262) 723-4260 (OFFICE)
(262) 723-7209 (FAX)
Email: abernathy@elknet.net

PLAT OF SURVEY

Legal Description
Lot 3 and Lot 4 of Block 2 of Hawthorne Hills Subdivision, Located in part of the Northwest 1/4 and part of the Southwest 1/4 of Section 26, Town 2 North, Range 17 East, Town of Geneva, County of Walworth, State of Wisconsin.

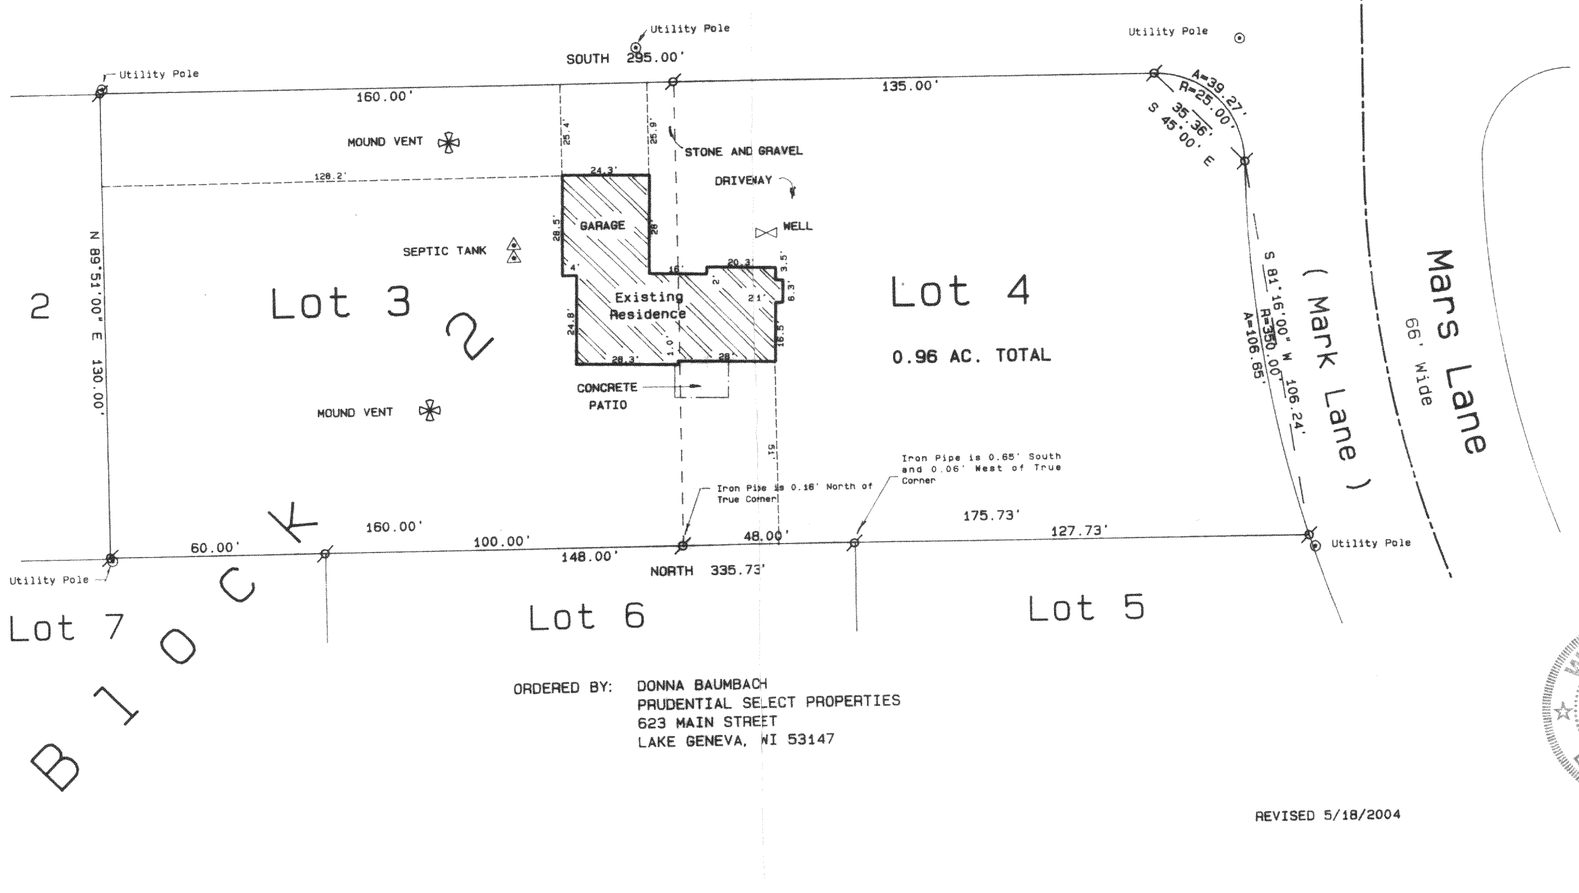

ORDERED BY: DONNA BAUMBACH
PRUDENTIAL SELECT PROPERTIES
623 MAIN STREET
LAKE GENEVA, WI 53147

REVISED 5/18/2004

Legend

- FOUND IRON PIPE
- FOUND IRON ROD
- FOUND BRASS CAPPED MONUMENT
- FOUND CONCRETE MONUMENT
- \+ CHISEL CUT IN CONCRETE
- SET IRON ROD, 24" LONG, WEIGHING 1.5 LBS./LINEAL FT., 3/4" DIA.
- SET IRON ROD, 30" LONG, WEIGHING 4.5 LBS./LINEAL FT., 1-11/16" DIA.
- (xx) RECORDED AS DIMENSION
- —x—x— EXISTING FENCE

WISCONSIN KENNETH B. ABERNATHY, JR. S-1594 ELKHORN WI LAND SURVEYOR

SCALE: 1" = 30 FEET

I hereby certify that the above described property has been surveyed by me or under my direction and that the above map is a true representation thereof and shows the size and location of the property, its exterior boundaries, the location of all visible structures and dimensions of all principal buildings thereon, boundary fences, apparent easements, roadways and visible encroachments, if any.
This survey is made for the use of the present owners of the property, and also those who purchase, mortgage, or guarantee the title thereto within one year from date hereof.

Kenneth B. Abernathy

KENNETH B. ABERNATHY, JR.
WISCONSIN REGISTERED LAND SURVEYOR,
S-1594

Date: MAY 6, 1993 Job No. 93.213

RECEIVED AUG 5 2004

DESIGN PRODUCTS 093121

217-2844

JHH-11