
PREPARED FOR:
DAN PORTER
W. 3828 LOCUST DR.
LAKE GENEVA, WI 53147

PLAT OF SURVEY

- OF -

LOTS 4794 THRU 4801, BLOCK 84 OF LAKE COMO BEACH SUBDIVISION, LOCATED IN THE TOWN OF GENEVA, WALWOTH COUNTY, WISCONSIN.

J.K. SURVEYING INC.
N3705 WILLOWBEND LANE
LAKE GENEVA, WI 53147
(262) 248-3697

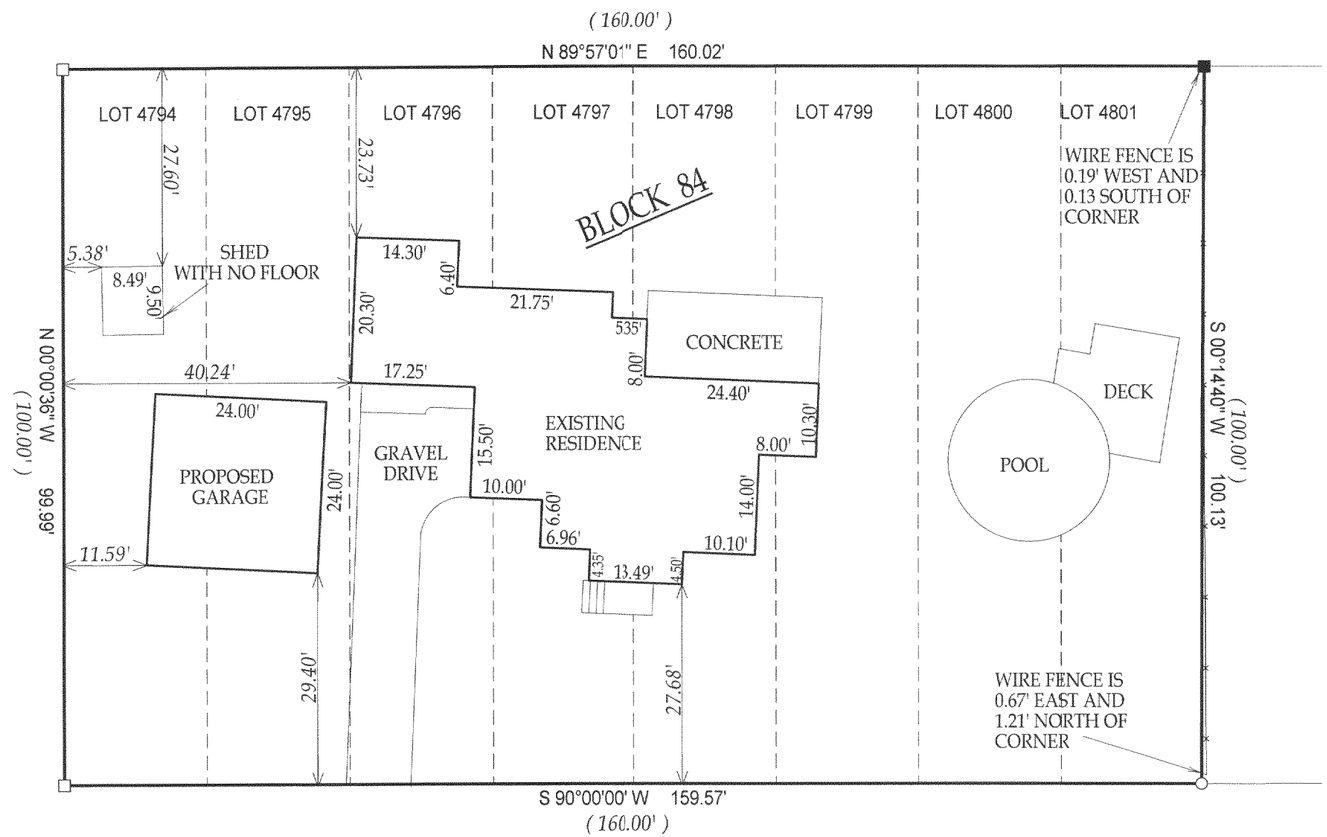

LOCUST DRIVE

(40' WIDE)

( ) = RECORDED AS
□ *= FOUND IRON BAR*
○ *= FOUND IRON PIPE*
■ *= SET IRON BAR*
● *= SET IRON PIPE*
SCALE: 1" = 20'
JOB #: 04-245
TAX ID #: JLCB 00955

NOTE: BEARINGS ARE ASSUMED

COMPARE LEGAL DESCRIPTION ABOVE AND DRAWING WITH DEED. FOR BUILDING RESTRICTIONS AND EASEMENTS NOT SHOWN,REFER TO DEED, ABSTRACT SOURCES AND LOCAL MUNICIPAL CODES. NOTIFY THE SURVEYOR IMMEDIATELY OF ANY DISCREPANCY.

"I hereby certify that I have surveyed the above described property and that the above map, to the best of my knowledge and belief, is a true representation thereof and shows the size and location of all visible structures, apparent easements and encroachments if any."
This survey is made for the present owners of the property, and those who purchase, mortgage, or guarantee the title thereto, within one year from the date hereof.

RECEIVED
AUG 13 2004
KW

WISCONSIN
JEFFREY L. KIMPS
2436
LAKE GENEVA, WIS.
LAND SURVEYOR

JEFFREY L KIMPS S - 2436
Wisconsin Registered Land Surveyor
(original if signed in red)

DATED THIS 11TH DAY OF MAY, 2004

217-2855