**AMBIT LAND SURVEYING**
P. O. Box 42
Bassett, WI. 53101

# PLAT OF SURVEY

PHONE 262-537-4874
FAX 262-537-4221

## OF

*Lots 1003 thru 1006 and Lots 1022 thru 1026, all in Block 17 of LAKE COMO BEACH SUBDIVISION, being a subdivision located in Sections 21, 22, 27, 28 and 29, all in Township 2 North, Range 17 East of the 4th Principal Meridian, Walworth County, Wisconsin.*

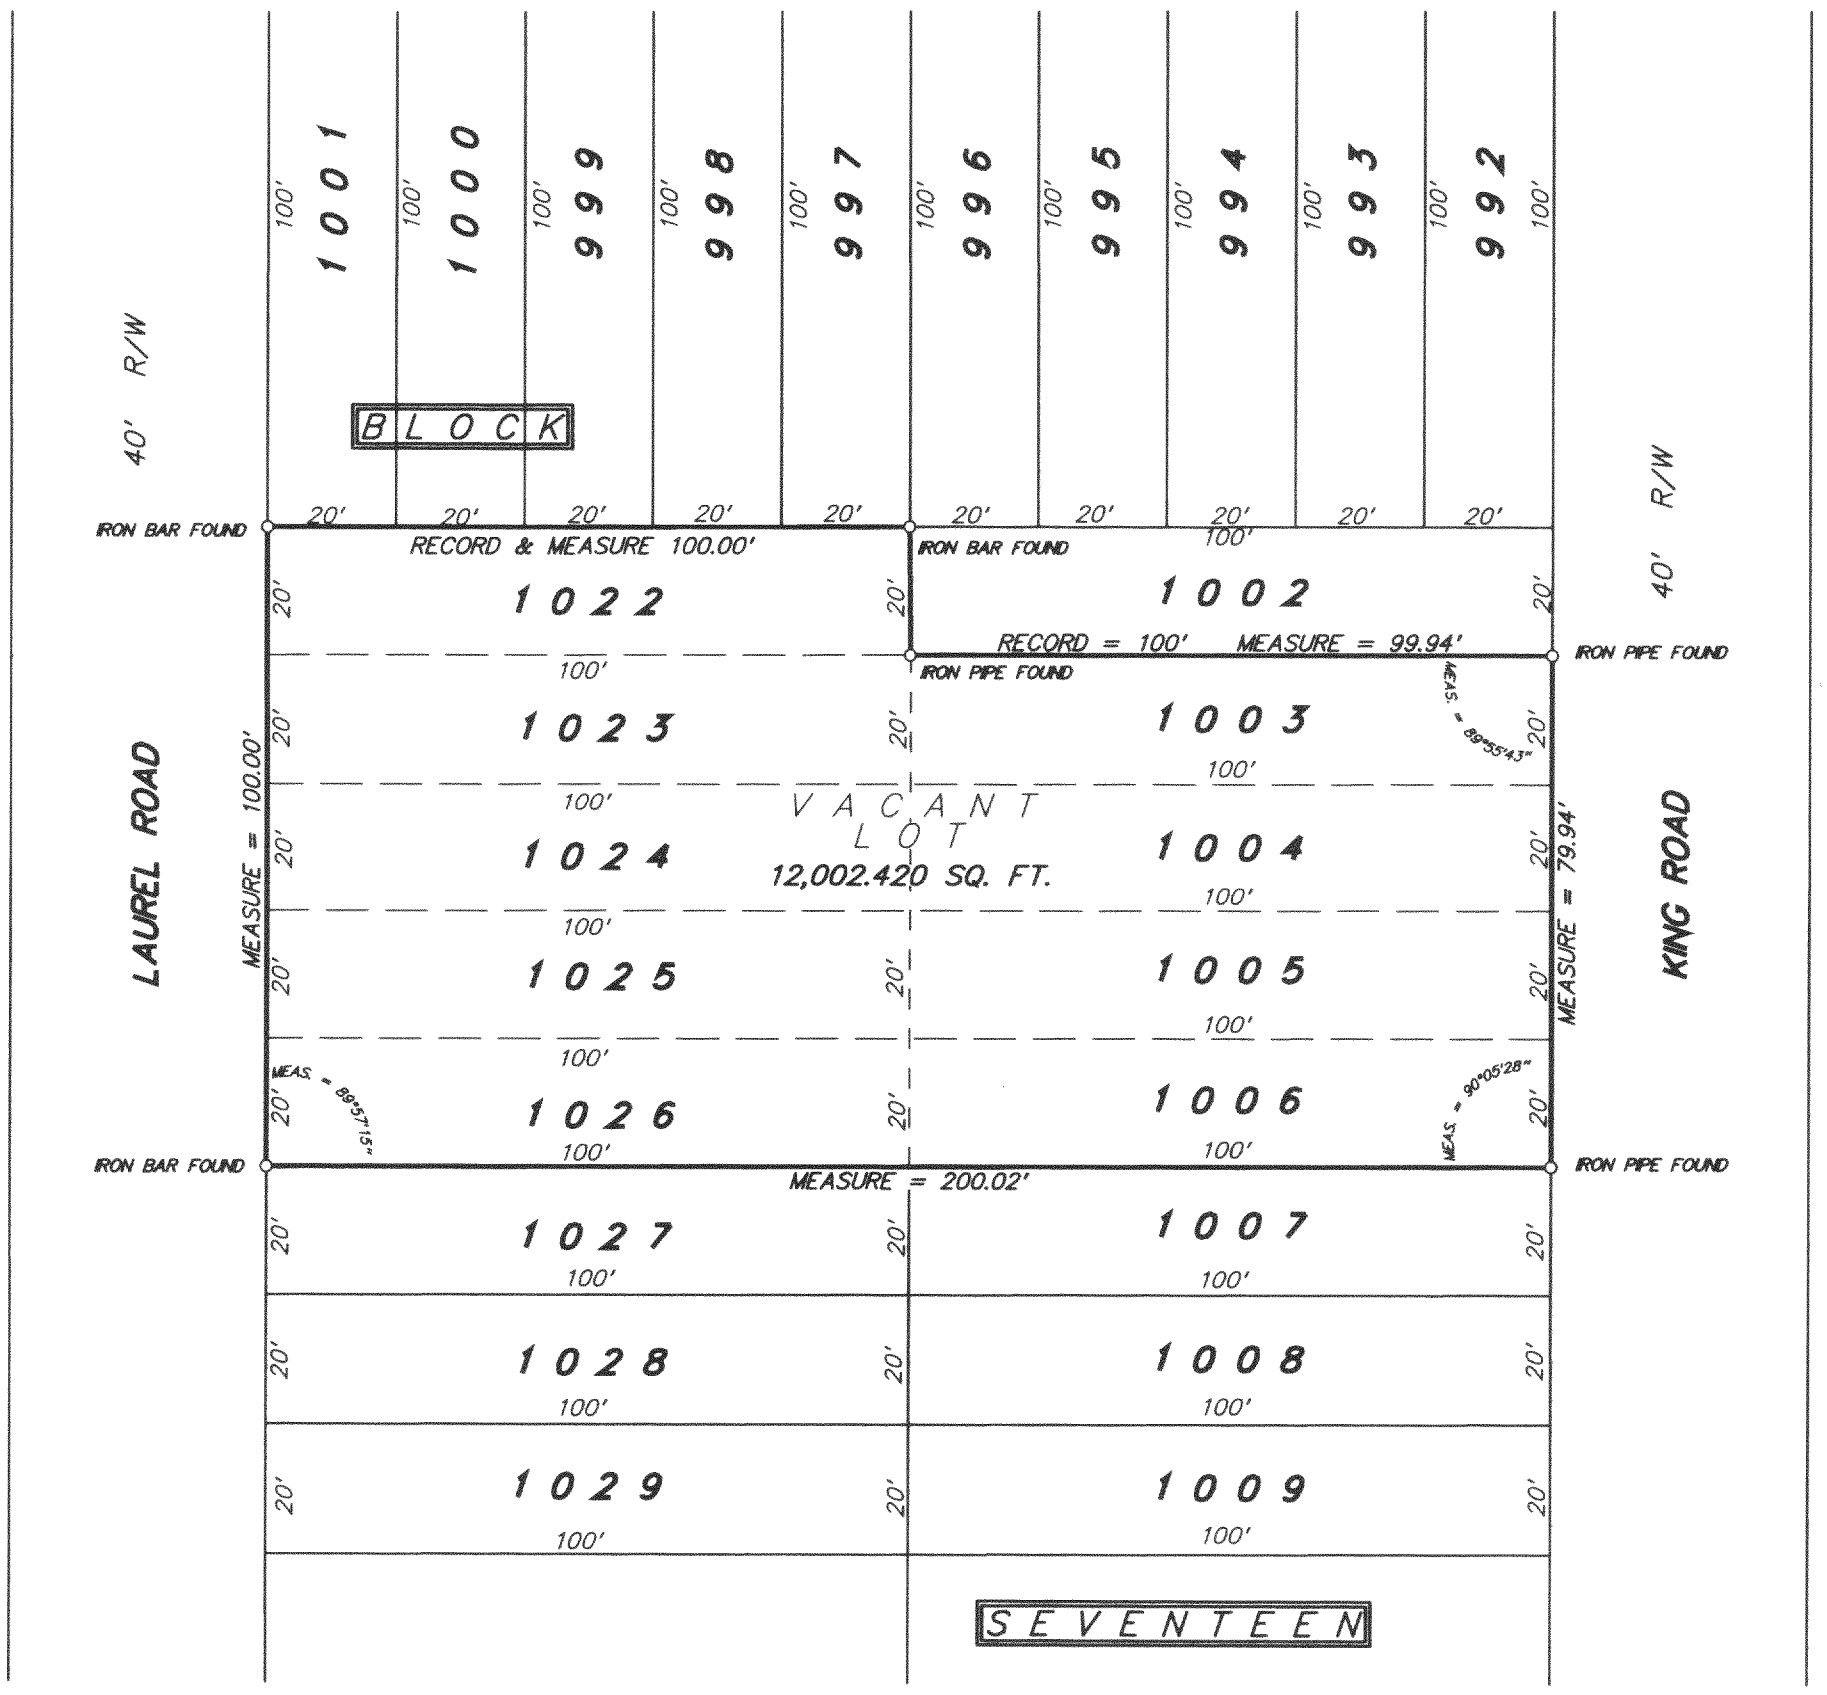


SCALE 1 inch = 30 feet
ORDERED BY S. Vennum
JOB NO. 0 4 0 1 8

I hereby certify that I have surveyed the above described property and the above plat is a true representation thereof and shows the size and location of the property, its exterior boundaries, the location and dimensions of all visible structures thereon, boundary fences, apparent easements and roadways and visible encroachments, if any.

This survey is made for the exclusive use of the present owners of the property, and also those who purchase, mortgage, or guarantee the title thereto within one year from the date hereof.

Dated at Bassett, Wisconsin this _____ day of _____ 2004.

Mark A. Bolender
Wisconsin Registered Land Surveyor S - 1784

RECEIVED
JAN 18 2005

JLCB-121

217-2973