


WORK ORDERED BY
JEFF LETZTER
2410 MEHRING AVENUE
JOHNSBURG, IL 60050

FARRIS, HANSEN & ASSOCIATES, INC.
Engineering, Architecture, Surveying
7 Ridgway Court P.O. Box 437
ELKHORN, WISCONSIN 53121
Office: (414) 723-2098
Fax: (414) 723-5886

REVISIONS
06/24/2004
ADD TOPO.
FEATURES

PROJECT NO.	3269.33-06
DATE:	05-18-04
SHEET NO.	1 OF 1

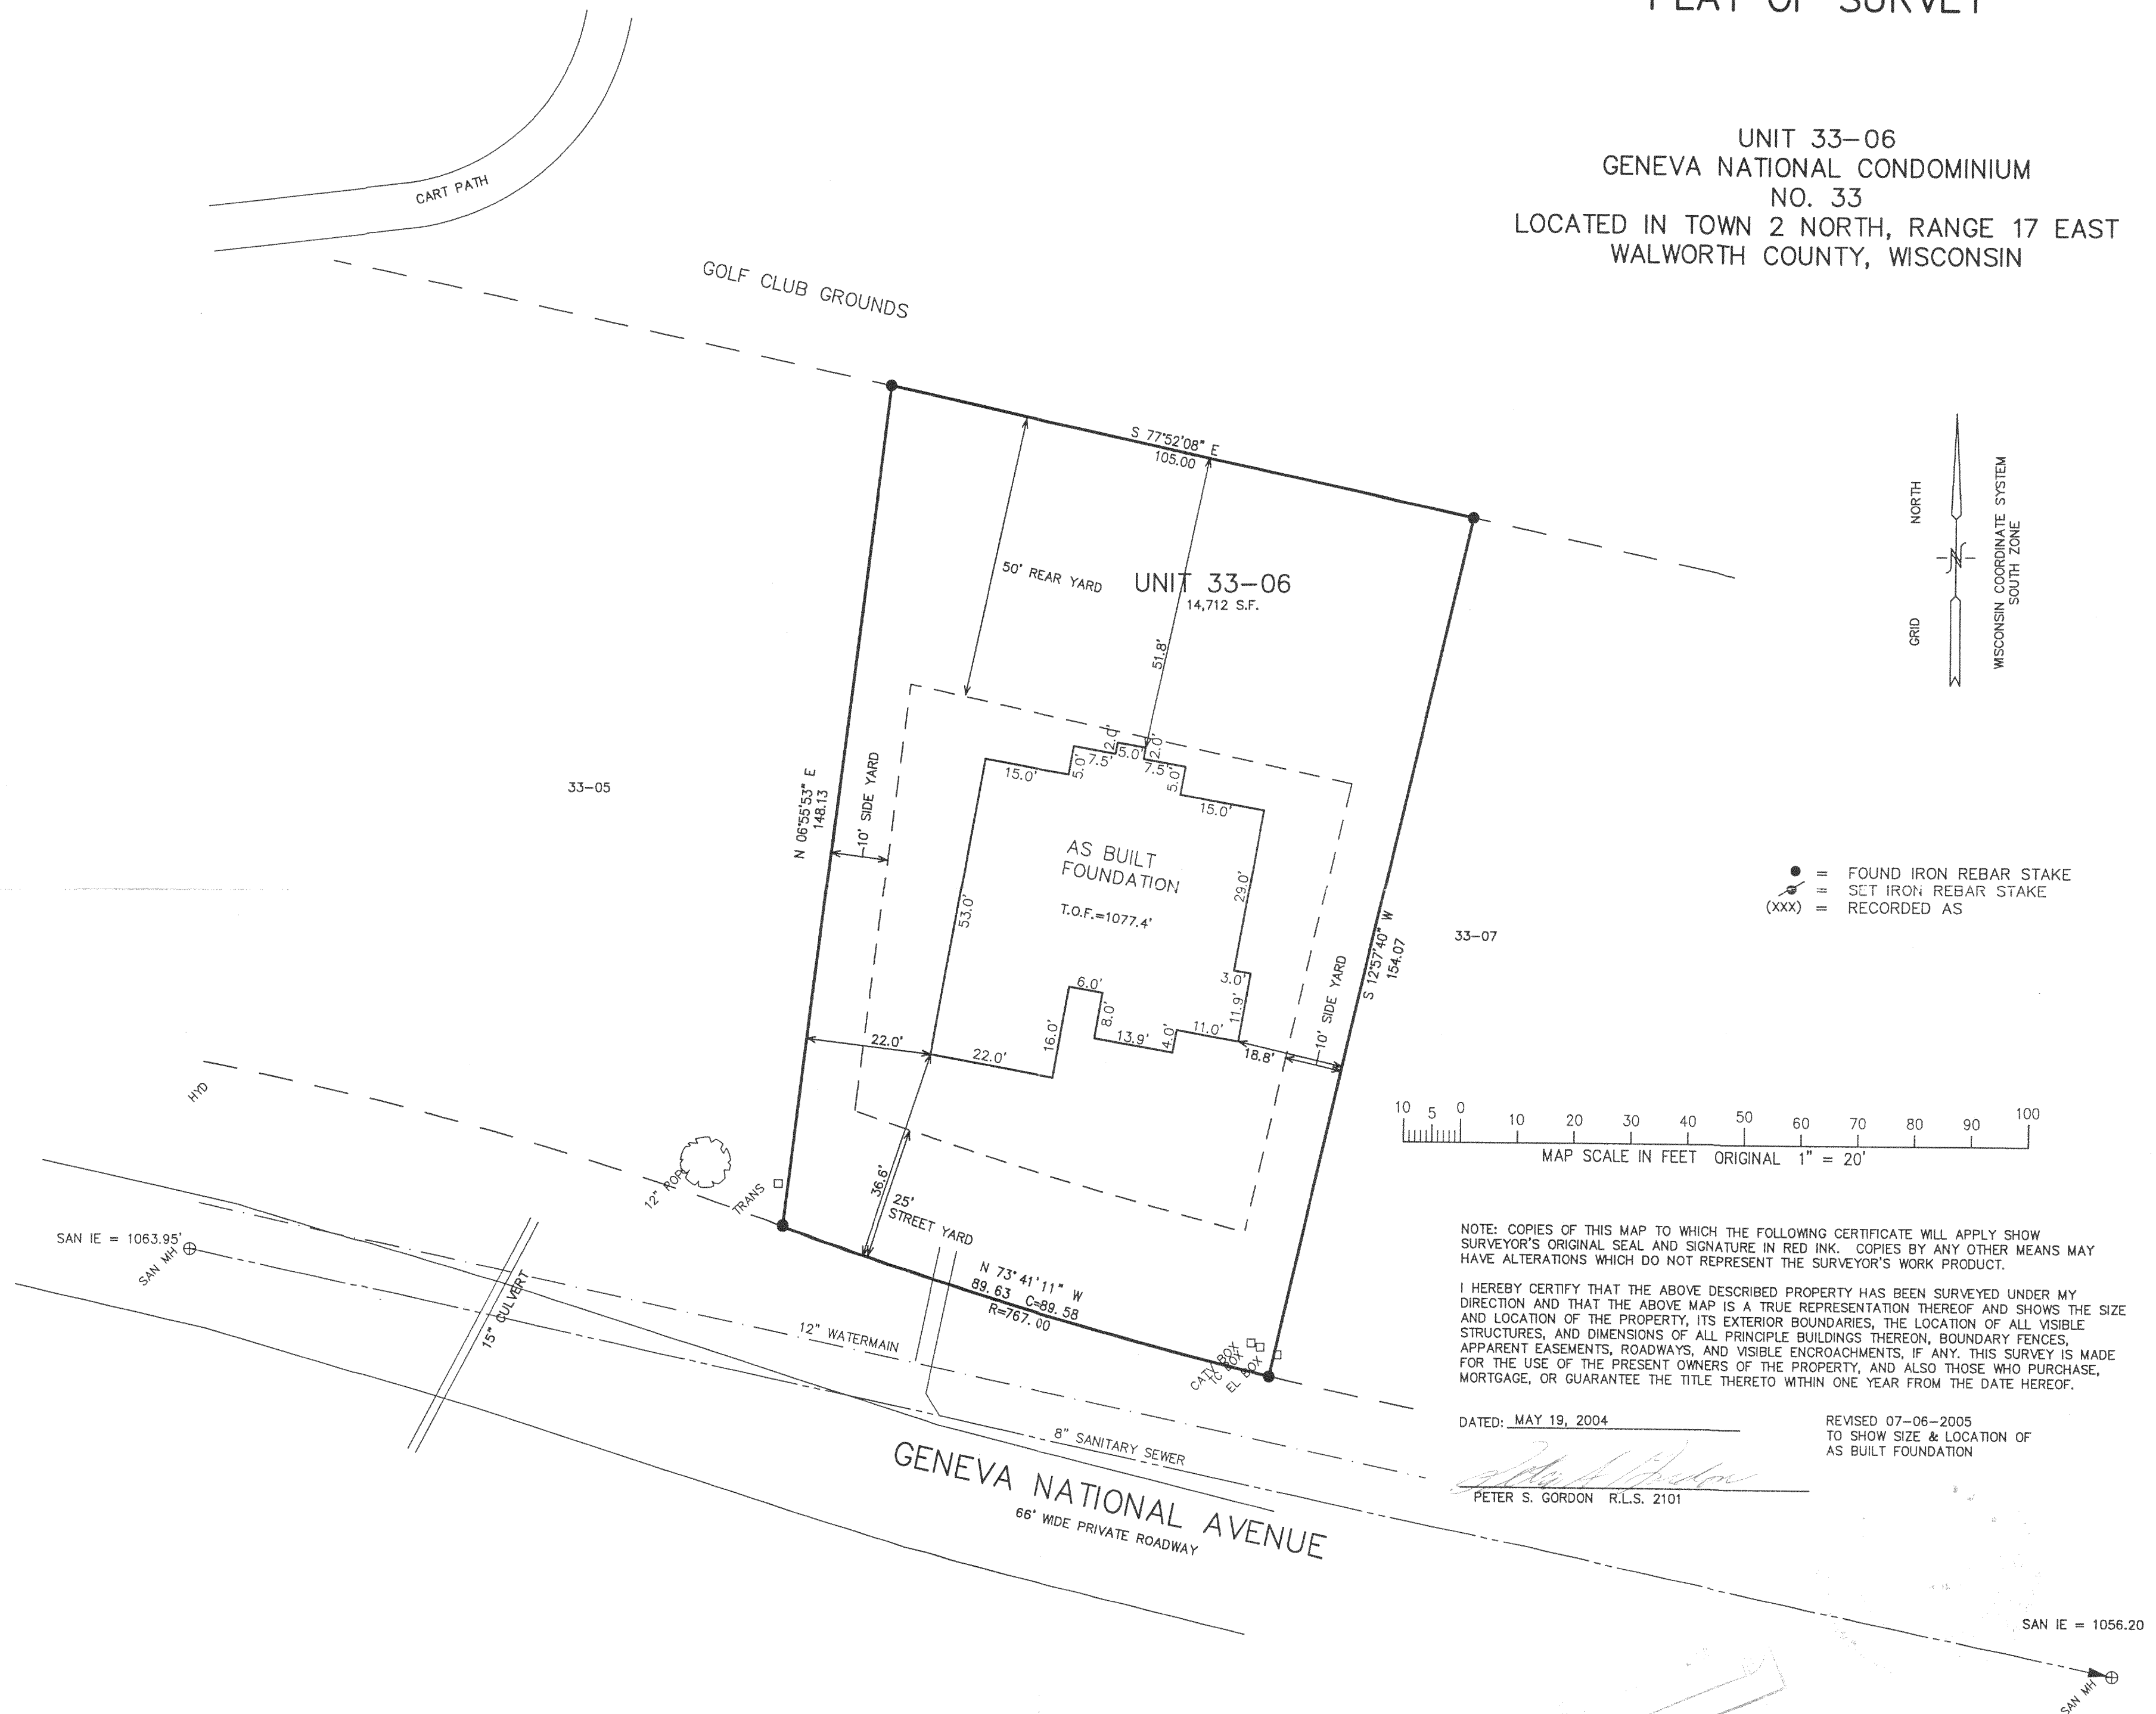






7611 330006