


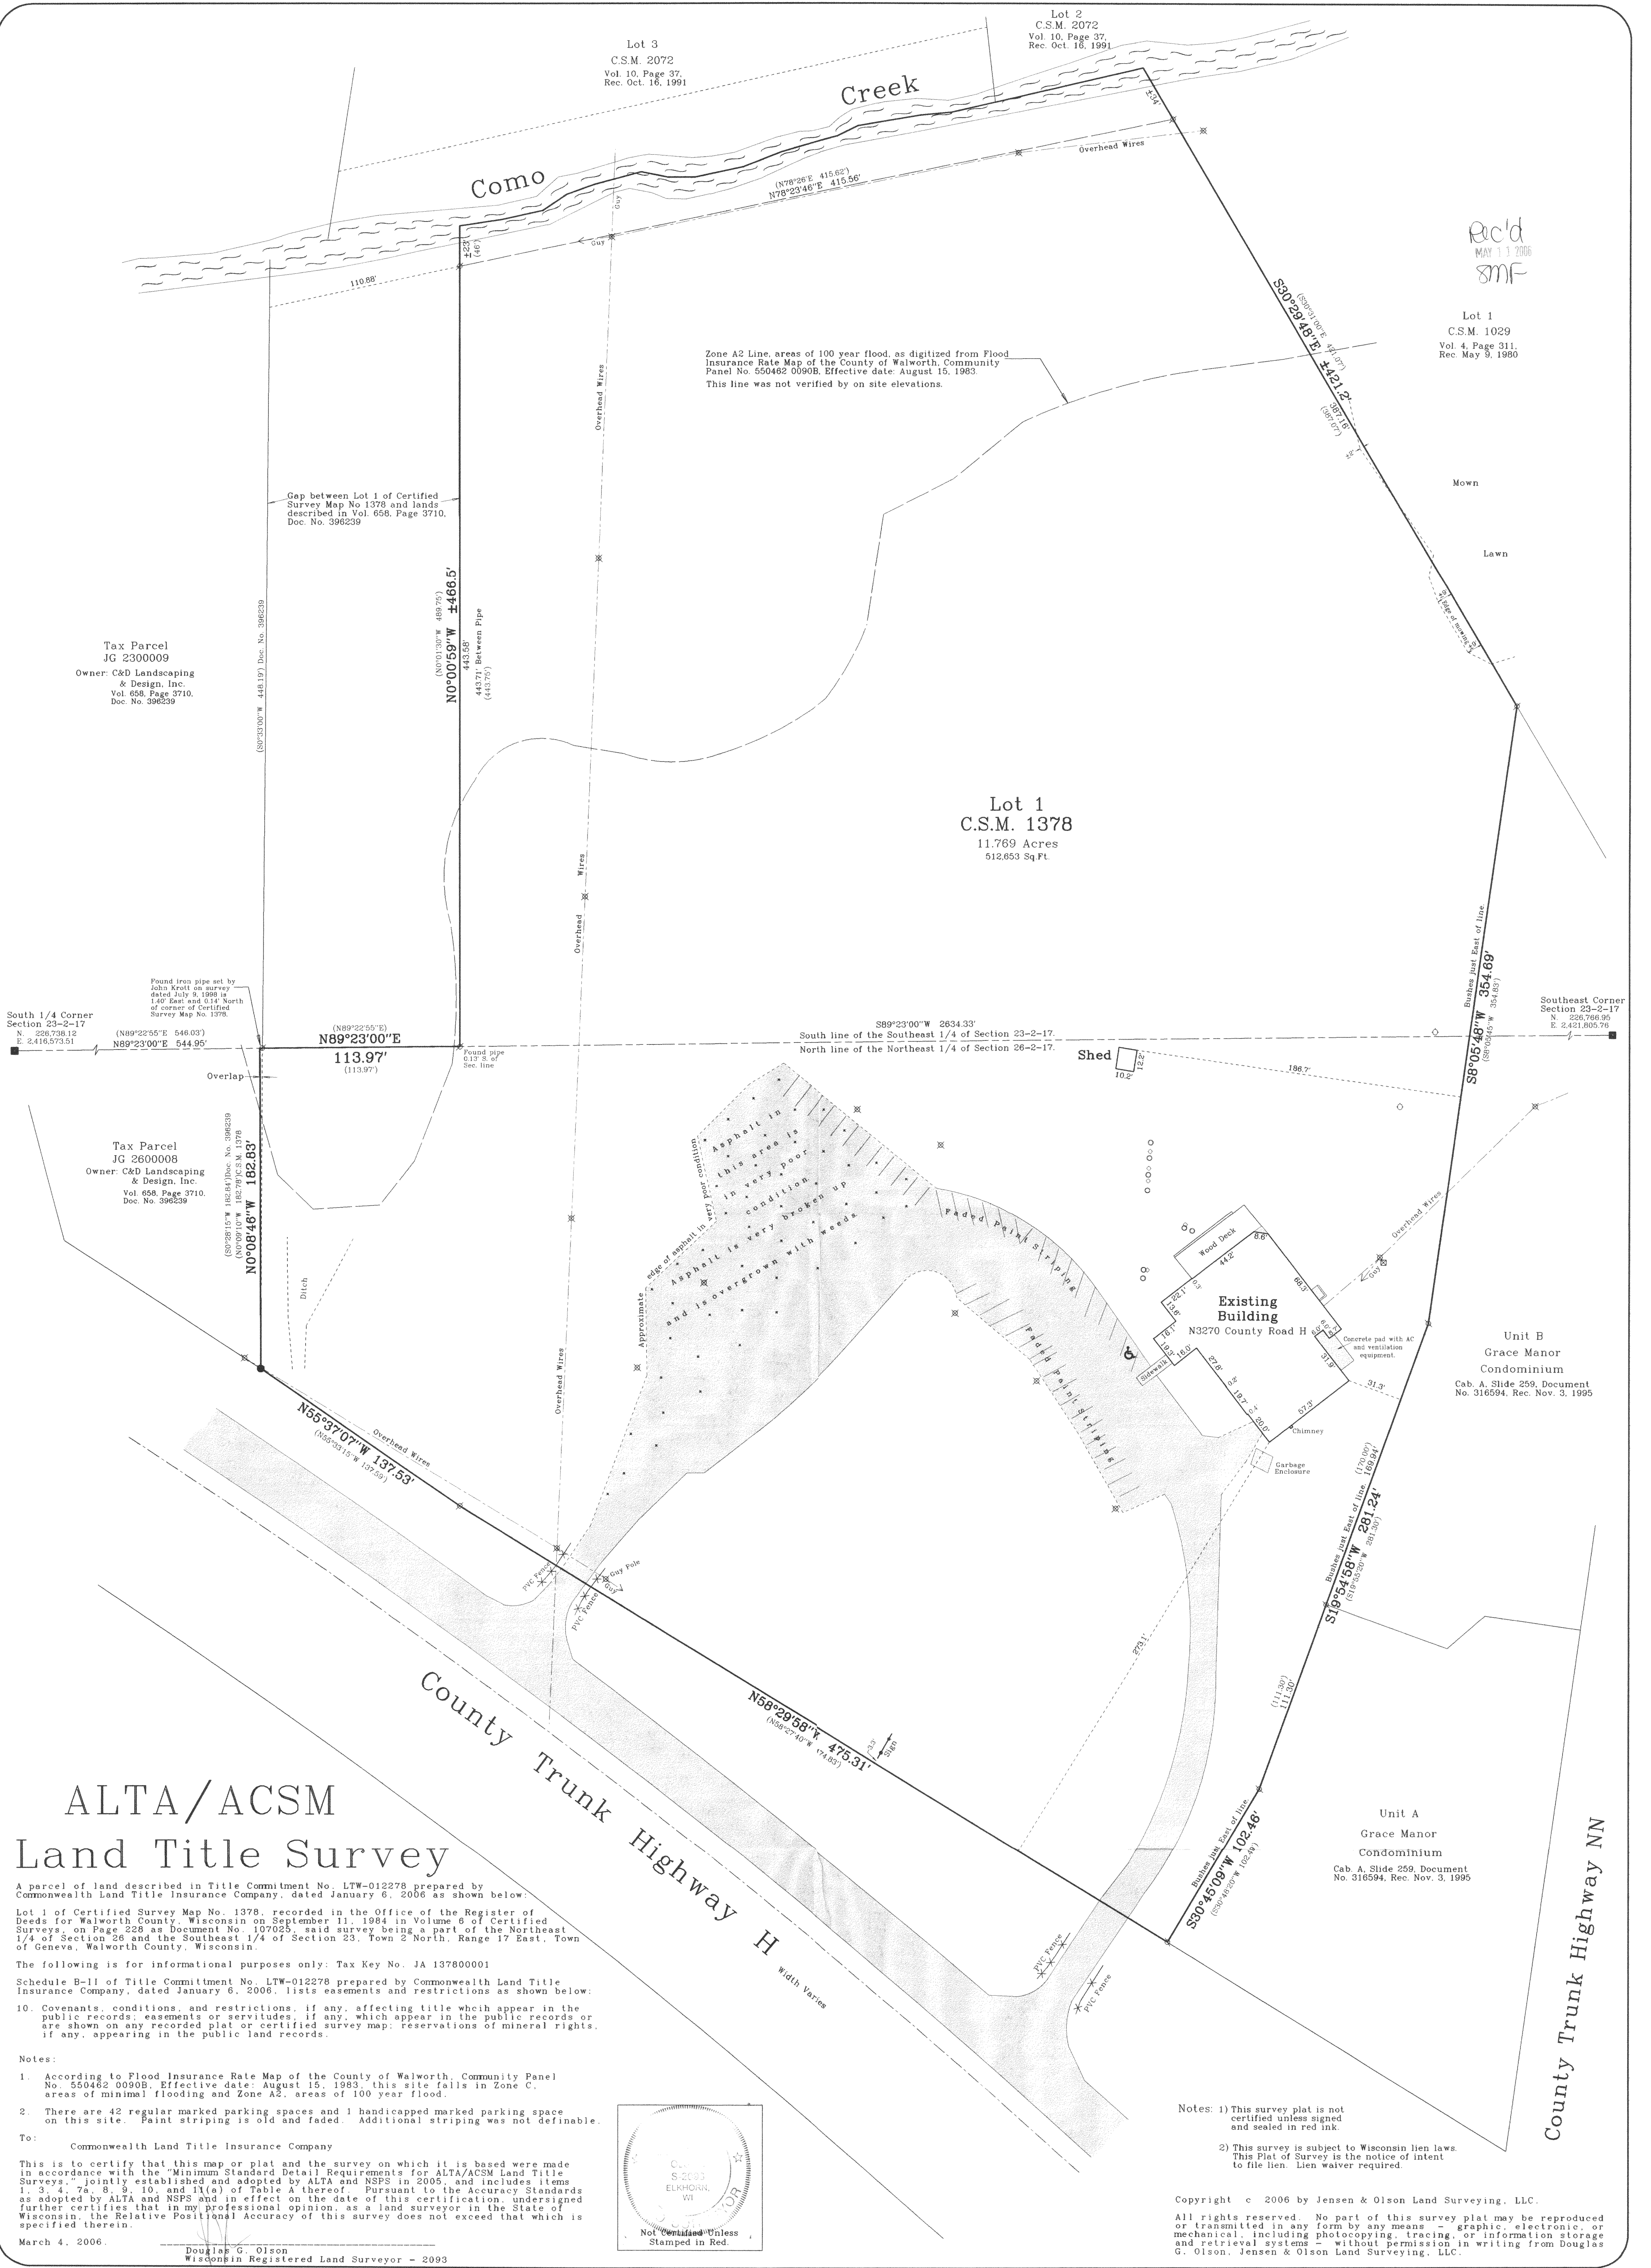

JA1378 - 1

217 - 3252