
PLAT OF SURVEY
AS–BUILT MAPPING

UNIT 3–40
GENEVA NATIONAL CONDOMINIUM
NO. 3
LOCATED IN TOWN 2 NORTH, RANGE 17 EAST
WALWORTH COUNTY, WISCONSIN

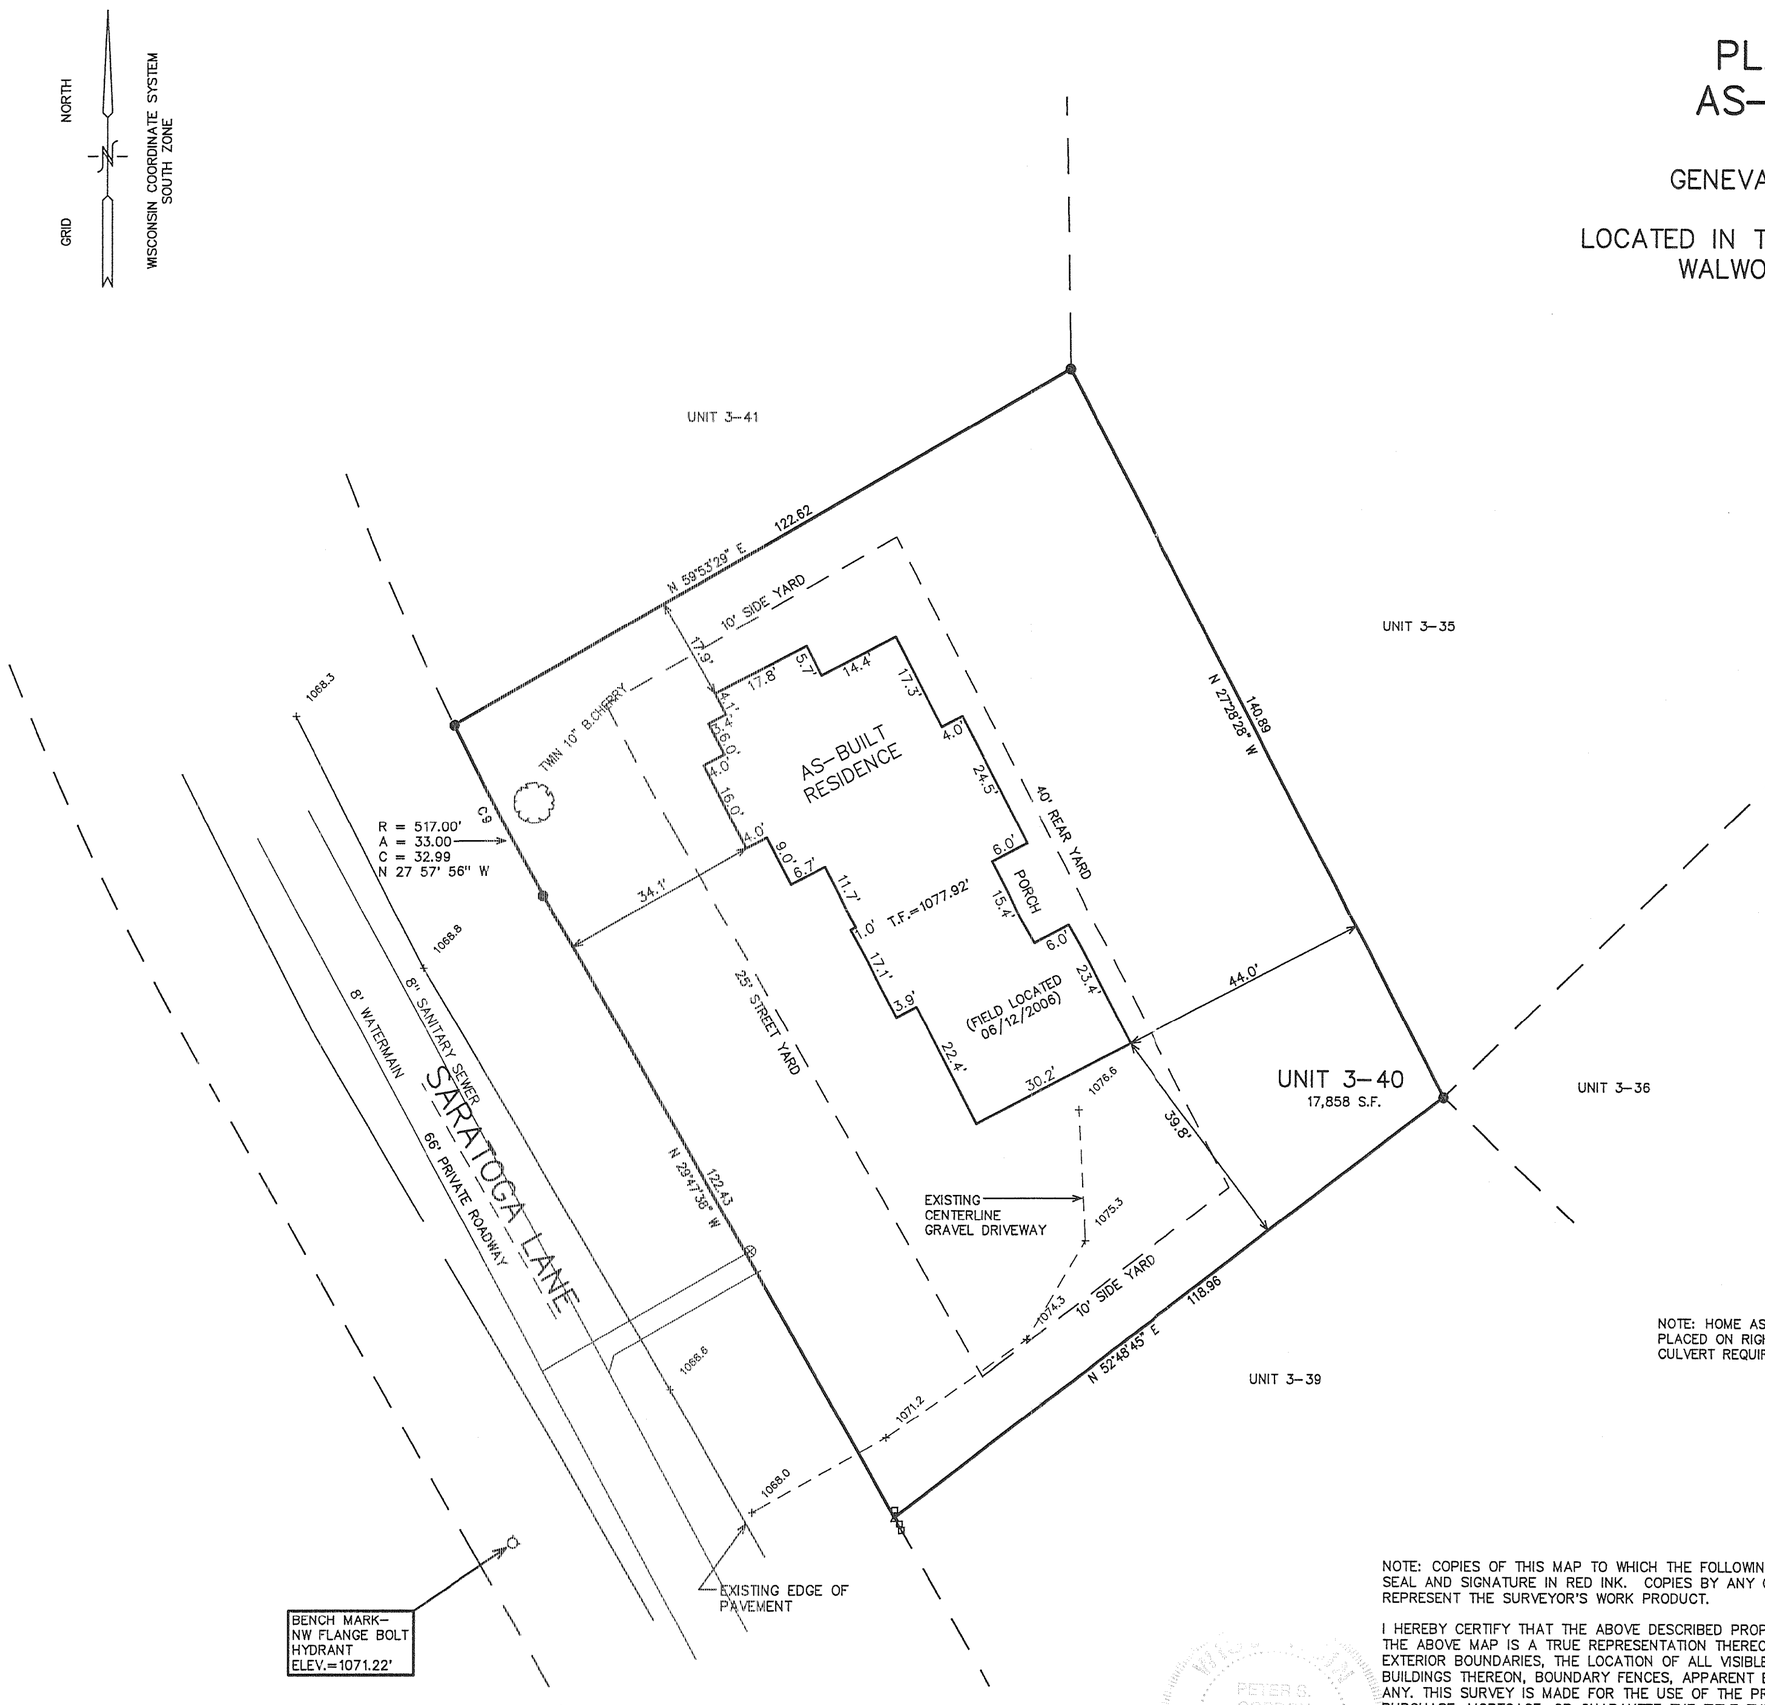

LEGEND

- ● = FOUND IRON REBAR STAKE
- △ = FOUND STEEL PIN W/CAP
- ⊗ = WATER SERVICE LOCATED
- ☼ = HYDRANT LOCATED
- ○ = MANHOLE LOCATED
- □ = TRANSFORMER LOCATED
- ▫ = UTILITY BOX LOCATED
- (XXX) = RECORDED AS

NOTE: HOME AS–BUILT 1.1' HIGHER THAN PLANNED AND DRIVEWAY PLACED ON RIGHT SIDE OF LOT WITH STEEPER ENTRY SLOPES WITH CULVERT REQUIRED.

RECEIVED
JUL 10 2006

NOTE: COPIES OF THIS MAP TO WHICH THE FOLLOWING CERTIFICATE WILL APPLY SHOW SURVEYOR'S ORIGINAL SEAL AND SIGNATURE IN RED INK. COPIES BY ANY OTHER MEANS MAY HAVE ALTERATIONS WHICH DO NOT REPRESENT THE SURVEYOR'S WORK PRODUCT.

I HEREBY CERTIFY THAT THE ABOVE DESCRIBED PROPERTY HAS BEEN SURVEYED UNDER MY DIRECTION AND THAT THE ABOVE MAP IS A TRUE REPRESENTATION THEREOF AND SHOWS THE SIZE AND LOCATION OF THE PROPERTY, ITS EXTERIOR BOUNDARIES, THE LOCATION OF ALL VISIBLE STRUCTURES, AND DIMENSIONS OF ALL PRINCIPLE BUILDINGS THEREON, BOUNDARY FENCES, APPARENT EASEMENTS, ROADWAYS, AND VISIBLE ENCROACHMENTS, IF ANY. THIS SURVEY IS MADE FOR THE USE OF THE PRESENT OWNERS OF THE PROPERTY, AND ALSO THOSE WHO PURCHASE, MORTGAGE, OR GUARANTEE THE TITLE THERETO WITHIN ONE YEAR FROM THE DATE HEREOF.

WISCONSIN PETER S. GORDON S-2101 ELKHORN, WI LAND SURVEYOR

DATED: FEBRUARY 23, 2006

PETER S. GORDON R.L.S. 2101

– WORK ORDERED BY –
DAVID AND MICHELLE CURRY
C/O McCORMACK + ETTEN/ARCHITECTS
400 BROAD STREET
LAKE GENEVA, WI 53147

FARRIS, HANSEN & ASSOCIATES, INC.
Engineering, Architecture, Surveying
7 Ridgway Court P.O. Box 437
ELKHORN, WISCONSIN 53121
Office: (262) 723–2098
Fax: (262) 723–5886

REVISIONS
10/20/98 – TOPOGRAPHY & TREE LOC. ADDED
03/10/2006– SITE, GRADING, DRAINAGE, & EROSION CONTROL PLAN
06/12/2006– TO SHOW SIZE AND LOCATION OF AS–BUILT RESIDENCE

PROJECT NO. 3269.3–40
DATE: 5/9/97
SHEET NO. 1 OF 1

SGN 3-40

217-3266