
PLAT OF SURVEY
TOPOGRAPHICAL MAPPING

LOTS 82 AND 83 OF CONSUMER'S COMPANY SUBDIVISION

AND VACATED LAKE COMO DRIVE AS DESCRIBED IN VOL. 632 OG PG. 3762 AND THE NORTH 70' OF THE CHICAGO AND NORTHWESTERN RAILROAD DESCRIBED IN VOL. 41 ON PG. 163 AND THE NORTHWESTERLY 15 FEET OF THE SOUTHEASTERLY 30 FEET OF THE CHICAGO AND NORTHWESTERN RAILROAD DESCRIBED IN VOL. 504 ON PG. 680
LOCATED IN PART OF THE SOUTHEAST 1/4 OF SECTION 32, TOWN 2 NORTH, RANGE 17 EAST, TOWN OF GENEVA, WALWORTH COUNTY, WISCONSIN

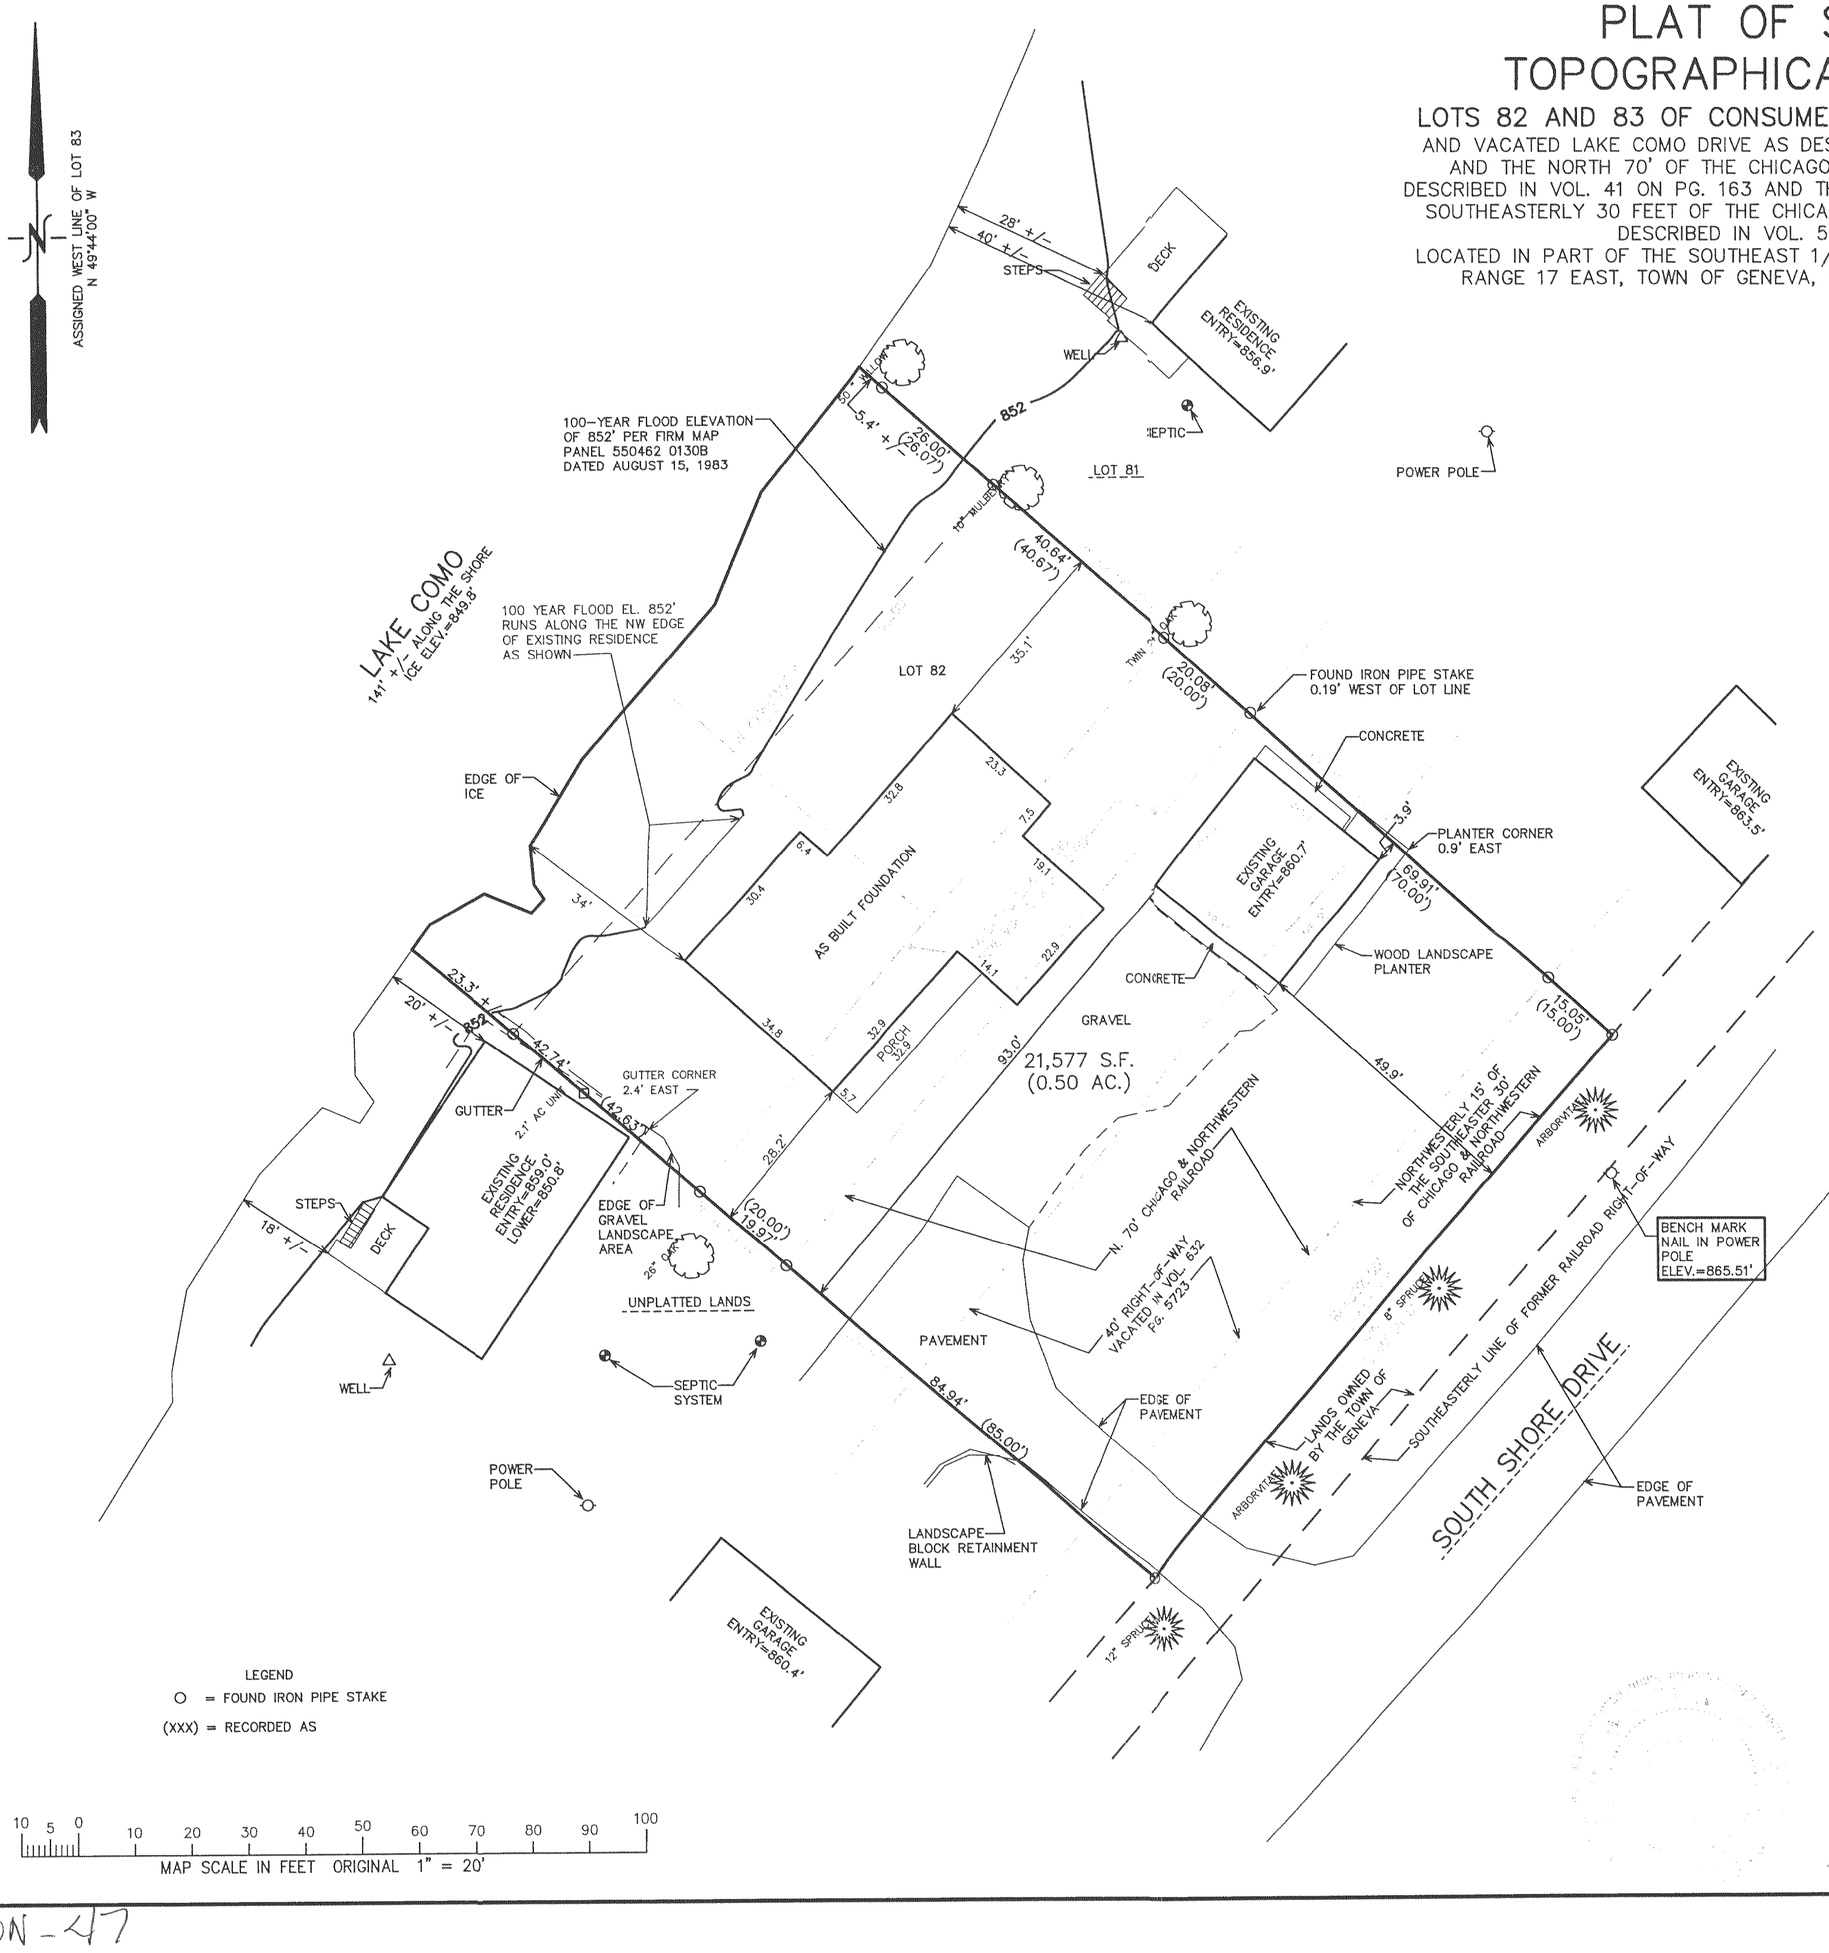

NOTE: COPIES OF THIS MAP TO WHICH THE FOLLOWING CERTIFICATE WILL APPLY SHOW THE SURVEYOR'S ORIGINAL SEAL AND SIGNATURE IN RED INK. COPIES BY ANY OTHER MEANS MAY HAVE ALTERATIONS WHICH DO NOT REPRESENT THE SURVEYOR'S WORK PRODUCT.

I HEREBY CERTIFY THAT THE ABOVE DESCRIBED PROPERTY HAS BEEN SURVEYED UNDER MY DIRECTION AND THAT THE ABOVE MAP IS A TRUE REPRESENTATION THEREOF AND SHOWS THE SIZE AND LOCATION OF THE PROPERTY AND ITS EXTERIOR BOUNDARIES. THIS SURVEY IS MADE FOR THE USE OF THE PRESENT OWNERS OF THE PROPERTY, AND ALSO THOSE WHO PURCHASE, MORTGAGE, OR GUARANTEE THE TITLE THERETO WITHIN ONE YEAR FROM THE DATE HEREOF.

DATED: MARCH 7, 2006

REVISED 11-10-2006
TO SHOW SIZE & LOCATION OF AS BUILT FOUNDATION

PETER S. GORDON R.L.S. 2101

- WORK ORDERED BY -
AUDREY BOSS
BOSS CONSTRUCTION MANAGEMENT CORP.
W8990 PINKS LANE
DELAVAN, WI 53115

FARRIS, HANSEN & ASSOCIATES, INC.
ENGINEERING - ARCHITECTURE - SURVEYING
7 RIDGWAY COURT P.O. BOX 437
ELKHORN, WISCONSIN 53121
OFFICE: (262) 723-2098 FAX: (262) 723-5886

REVISIONS
03-10-2006

PROJECT NO. 6999
DATE: 03/07/06
SHEET NO. 1 OF 1

11/10/2006 X:\Projects\6999\Dcad\ASBLT

JCON-47

217-3331