


PLAT OF SURVEY TOPOGRAPHICAL MAPPING

LOT 17 OF LAKE FOREST ESTATES
A SUBDIVISION LOCATED IN PART OF SECTIONS 26, 27, AND 35,
TOWN 2 NORTH, RANGE 17 EAST, WALWORTH COUNTY, WISCONSIN

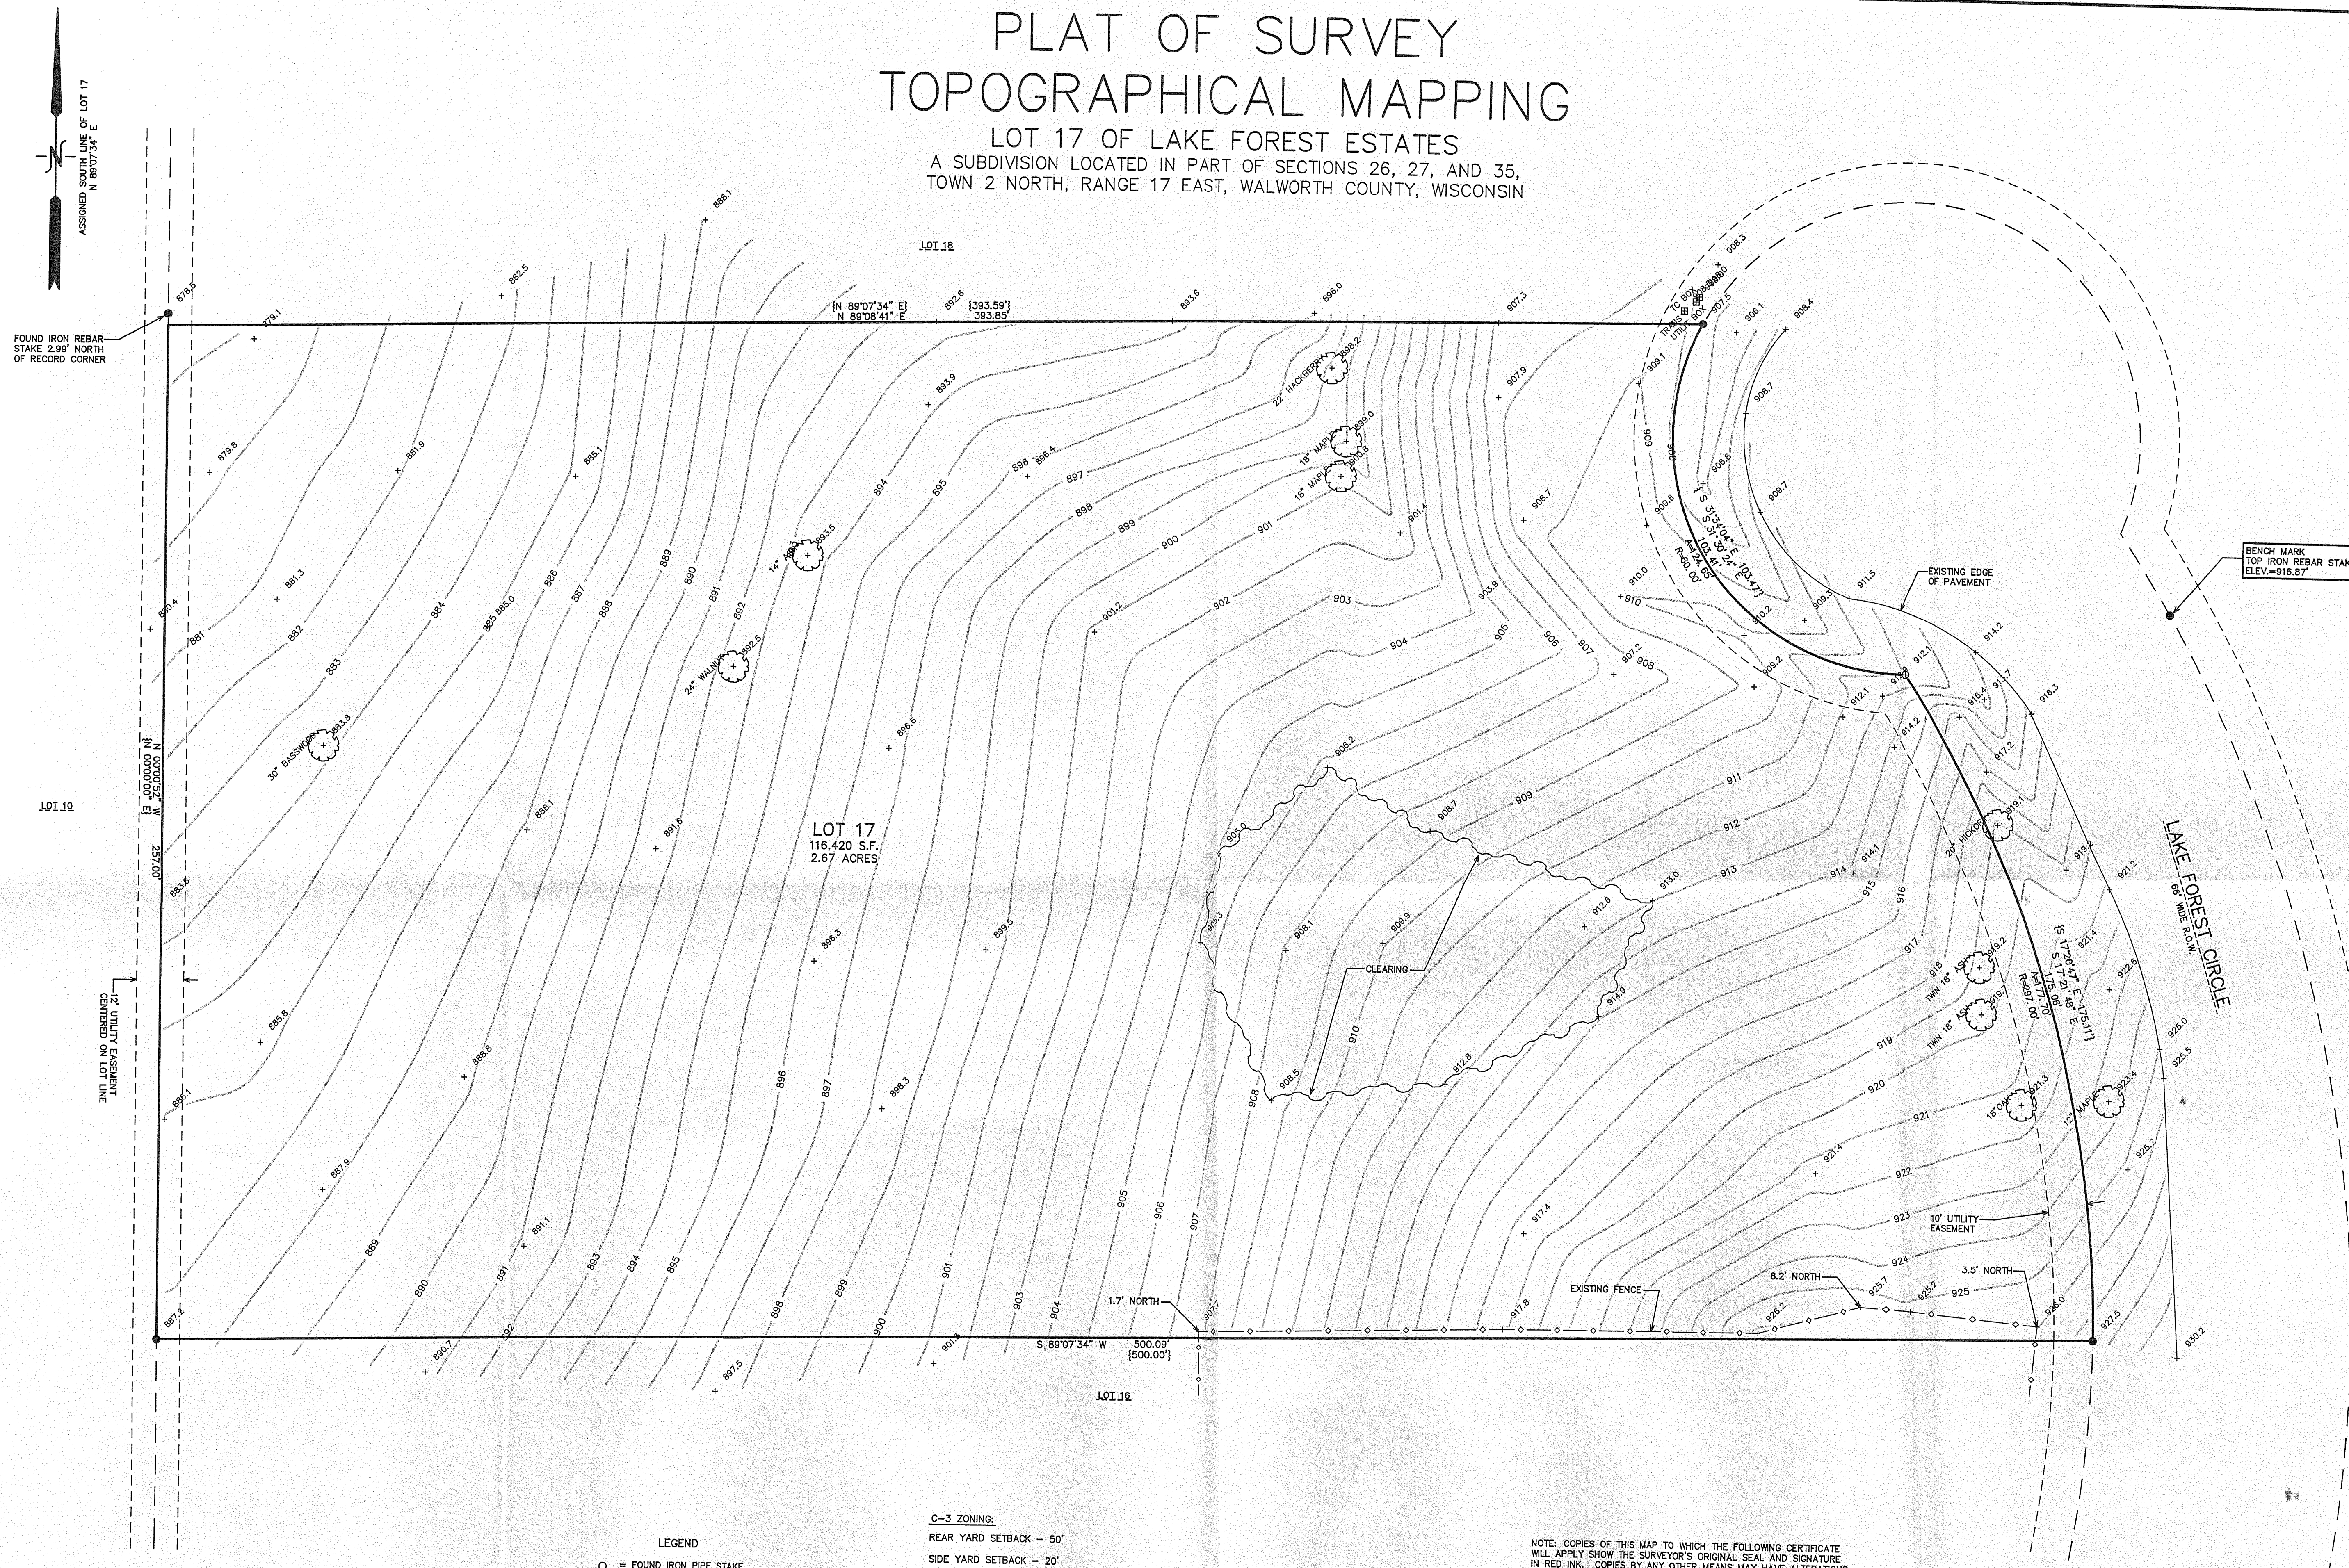

ASSIGNED SOUTH LINE OF LOT 17
N 89°07'34" E

FOUND IRON REBAR
STAKE 2.99' NORTH
OF RECORD CORNER

LOT 16

12' UTILITY EASEMENT
CENTERED ON LOT LINE

LOT 17
116,420 S.F.
2.67 ACRES

LOT 18

BENCH MARK
TOP IRON REBAR STAKE
ELEV. = 916.87'

LAKE FOREST CIRCLE

- LEGEND
- = FOUND IRON PIPE STAKE
 - = FOUND IRON REBAR STAKE
 - {XXX} = RECORDED AS




C-3 ZONING:
REAR YARD SETBACK - 50'
SIDE YARD SETBACK - 20'
STREET YARD SETBACK - 25'

NOTES: COPIES OF THIS MAP TO WHICH THE FOLLOWING CERTIFICATE
WILL APPLY SHOW THE SURVEYOR'S ORIGINAL SEAL AND SIGNATURE
IN RED INK. COPIES BY ANY OTHER MEANS MAY HAVE ALTERATIONS
WHICH DO NOT REPRESENT THE SURVEYOR'S WORK PRODUCT.

I HEREBY CERTIFY THAT THE ABOVE DESCRIBED PROPERTY HAS BEEN
SURVEYED UNDER MY DIRECTION AND THAT THE ABOVE MAP IS A TRUE
REPRESENTATION THEREOF AND SHOWS THE SIZE AND LOCATION OF
THE PROPERTY AND ITS EXTERIOR BOUNDARIES. THIS SURVEY IS
MADE FOR THE USE OF THE PRESENT OWNERS OF THE PROPERTY, AND
ALSO THOSE WHO PURCHASE, MORTGAGE, OR GUARANTEE THE TITLE
THEREIN WITHIN ONE YEAR FROM THE DATE HEREOF.

DATED: JANUARY 3, 2007

Peter S. Gordon
PETER S. GORDON R.L.S. 2101

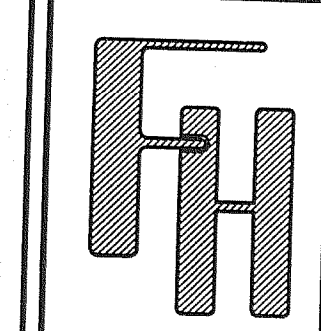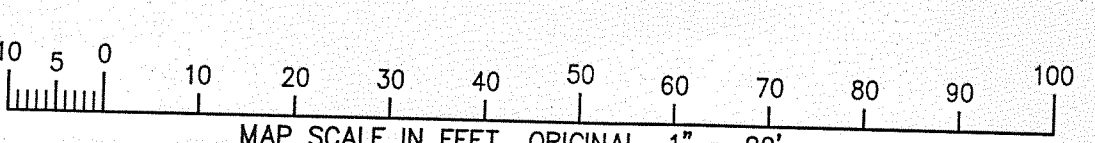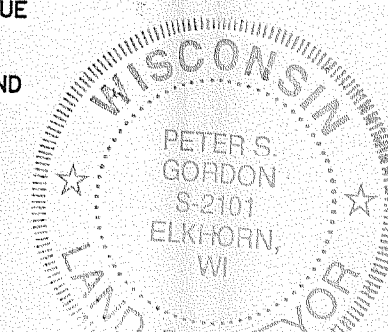

WORK ORDERED BY -
JOE BIDWELL
531 VALLEY VIEW DRIVE
FONTANA, WI 53125

FARRIS, HANSEN & ASSOCIATES, INC.
ENGINEERING - ARCHITECTURE - SURVEYING
7 RIDGWAY COURT P.O. BOX 437
ELKHORN, WISCONSIN 53121
OFFICE: (262) 723-2098 FAX: (262) 723-5866

REVISIONS

PROJECT NO.
4176.17
DATE
01/03/2007
SHEET NO.
1 OF 1

LFE-17

217-3352