PREPARED FOR:
ARLEIGH BOSTROM


PLAT OF SURVEY

-OF-

NORTH 1/2 OF LOT 11075 AND LOTS 11076 THRU 11082 IN BLOCK 200 OF LAKE COMO BEACH SUBDIVISION, LOCATED IN SECTION 29, TOWN 2 NORTH, RANGE 17 EAST, TOWN OF GENEVA, WALWORTH COUNTY, WISCONSIN.

PATHFINDER SURVEYING, INC.
W2888 KRUEGER ROAD UNIT "D"
LAKE GENEVA, WI 53147
(262) 248-3697

RECEIVED
FEB - 7 2007

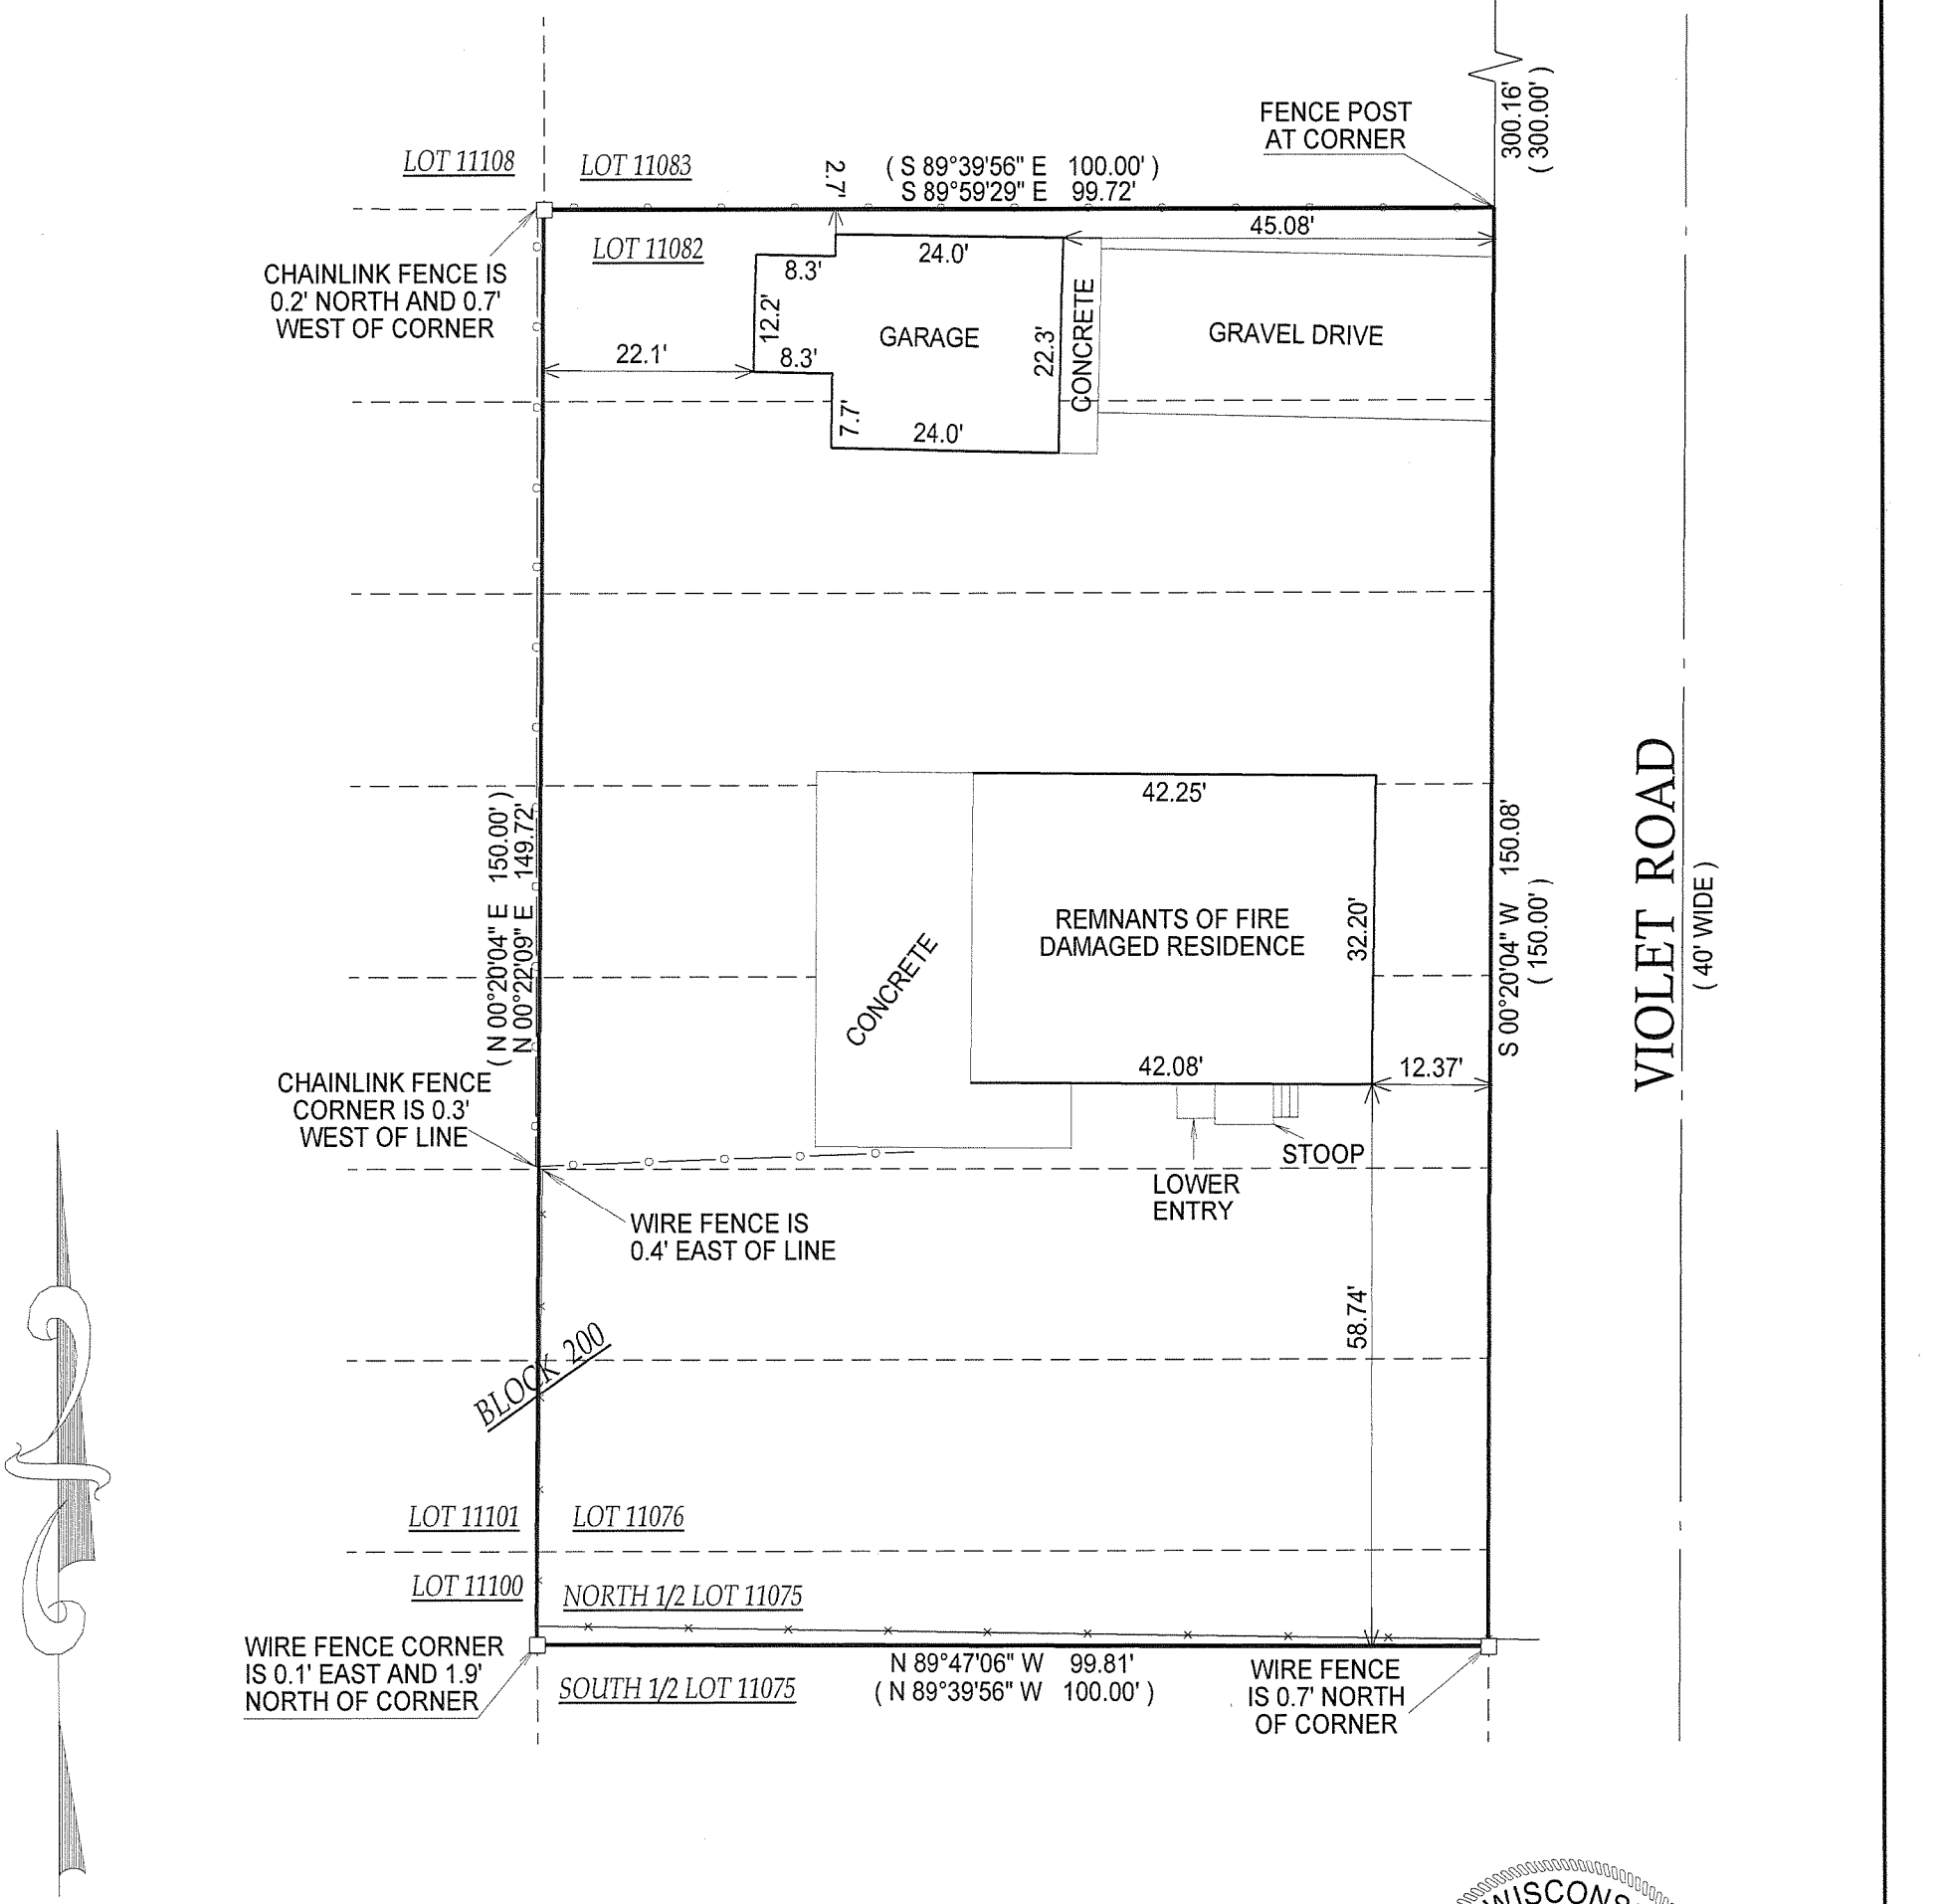

( ) = *RECORDED AS*

□ = *FOUND IRON BAR*

○ = *FOUND IRON PIPE*

■ = *SET IRON BAR*

● = *SET IRON PIPE*

SCALE: 1" = 20'

JOB #: 07-007

TAX ID #: JLCB 02414

NOTE: BASIS OF BEARING IS RECORD PLAT.

COMPARE LEGAL DESCRIPTION ABOVE AND DRAWING WITH DEED. FOR BUILDING RESTRICTIONS AND EASEMENTS NOT SHOWN,REFER TO DEED, ABSTRACT SOURCES AND LOCAL MUNICIPAL CODES. NOTIFY THE SURVEYOR IMMEDIATELY OF ANY DISCREPANCY.

"I hereby certify that the above described property was surveyed under my supervision and that the above map, to the best of my knowledge and belief, is a true representation thereof and shows the size and location of all visible structures, apparent easements and encroachments if any."
This survey is made for the present owners of the property, and those who purchase, mortgage, or guarentee the title thereto, within one year from the date hereof.

WISCONSIN
JEFFREY L. KIMPS 2436 LAKE GENEVA. WIS.
LAND SURVEYOR

JEFFREY L KIMPS S - 2436
Wisconsin Registered Land Surveyor
(original if signed in red)

DATED THIS 8th DAY OF JANUARY, 2007.

217-3362