
PREPARED FOR
KRUZAN CONSTRUCTION
2080 HAFFS RD.
GENOA CITY WI. 53128


PLAT OF SURVEY

- OF -

LOTS 7788 THRU 7794 BLOCK 133 OF LAKE COMO BEACH SUBDIVISION; LOCATED IN TOWN 2 NORTH, RANGE 17 EAST, WALWORTH COUNTY, WISCONSIN

PATHFINDER SURVEYING INC.
W2888 KRUEGER RD. UNIT "D"
LAKE GENEVA WI. 53147
(262) 248-3697

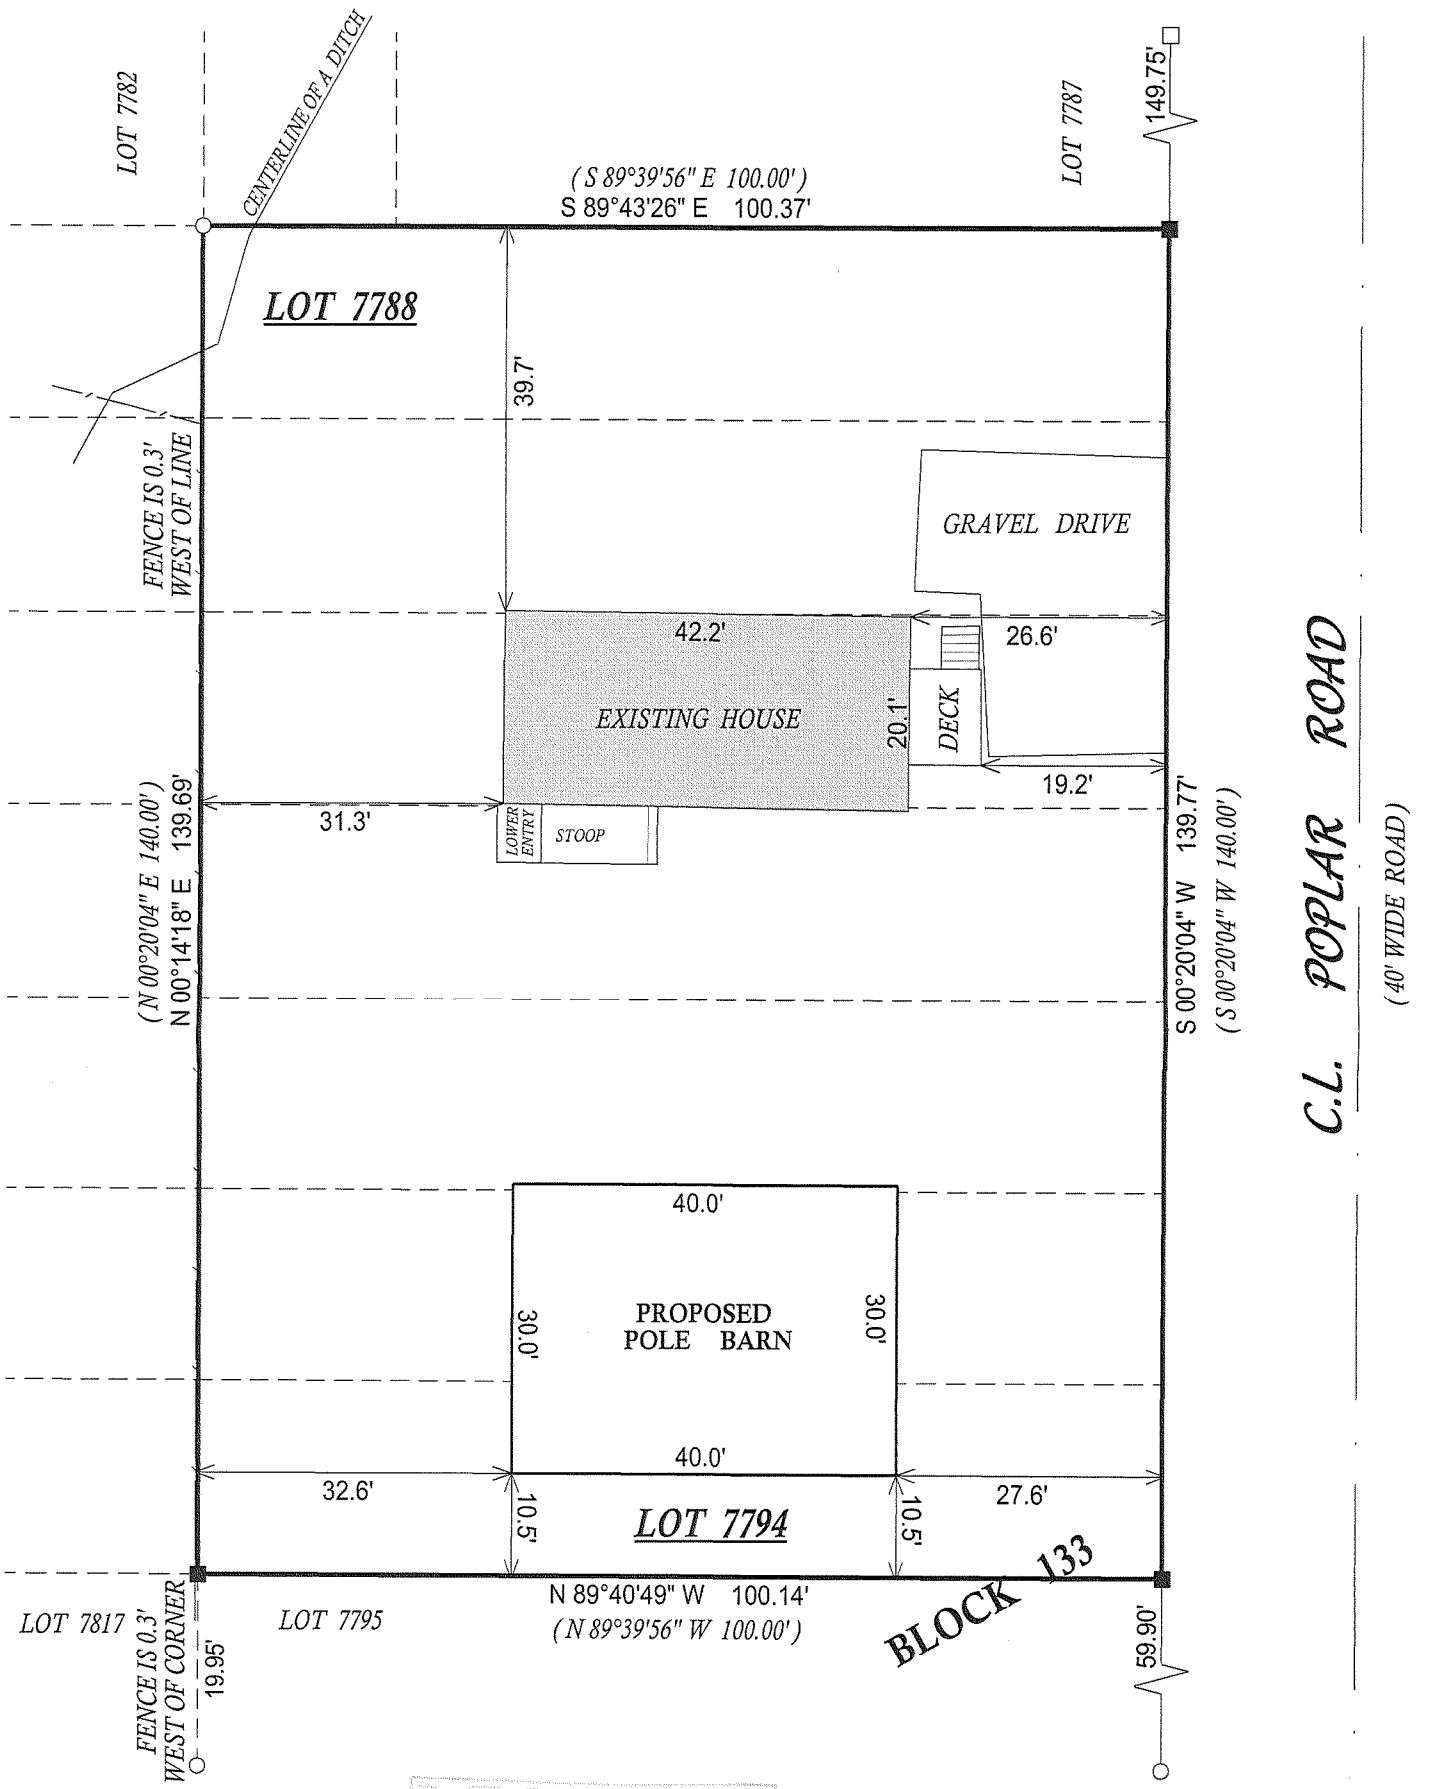

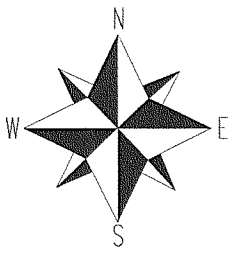

RECEIVED
MAY 30 2007

( )= recorded as

□ *= found iron bar*

○ *= found iron pipe*

● *= set iron pipe*

■ *= set iron bar*

SCALE 1" = 20'

JOB # 07-094

TAX ID # JLCB01657

NOTE: BEARINGS ARE REFRENCED TO THE RECORD PLAT

COMPARE LEGAL DESCRIPTION ABOVE AND DRAWING WITH DEED. FOR BUILDING RESTRICTIONS AND EASEMENTS NOT SHOWN,REFER TO DEED, ABSTRACT SOURCES AND LOCAL MUNICIPAL CODES. NOTIFY THE SURVEYOR IMMEDIATELY OF ANY DISCREPANCY.

"I hereby certify that I have surveyed the above described property and that the above map is a true representation thereof and shows the size and location of all visible structures, apparent easements and encroachments if any."
This survey is made for the present owners of the property, and those who purchase, mortgage, or guarentee the title thereto, within one year from the date hereof.

WISCONSIN
JOHN P.
KROTT
S-2258
LAKE GENEVA
WIS.
LAND SURVEYOR

JOHN KROTT S - 2258
Wisconsin Registered Land Surveyor
(original if signed in red)
DATED THIS THE 19th DAY OF MARCH 2007.

JLCB-16576

217-3394