PLAT OF SURVEY

UNIT 10–05
GENEVA NATIONAL CONDOMINIUM
NO. 10
LOCATED IN TOWN 2 NORTH, RANGE 17 EAST
WALWORTH COUNTY, WISCONSIN

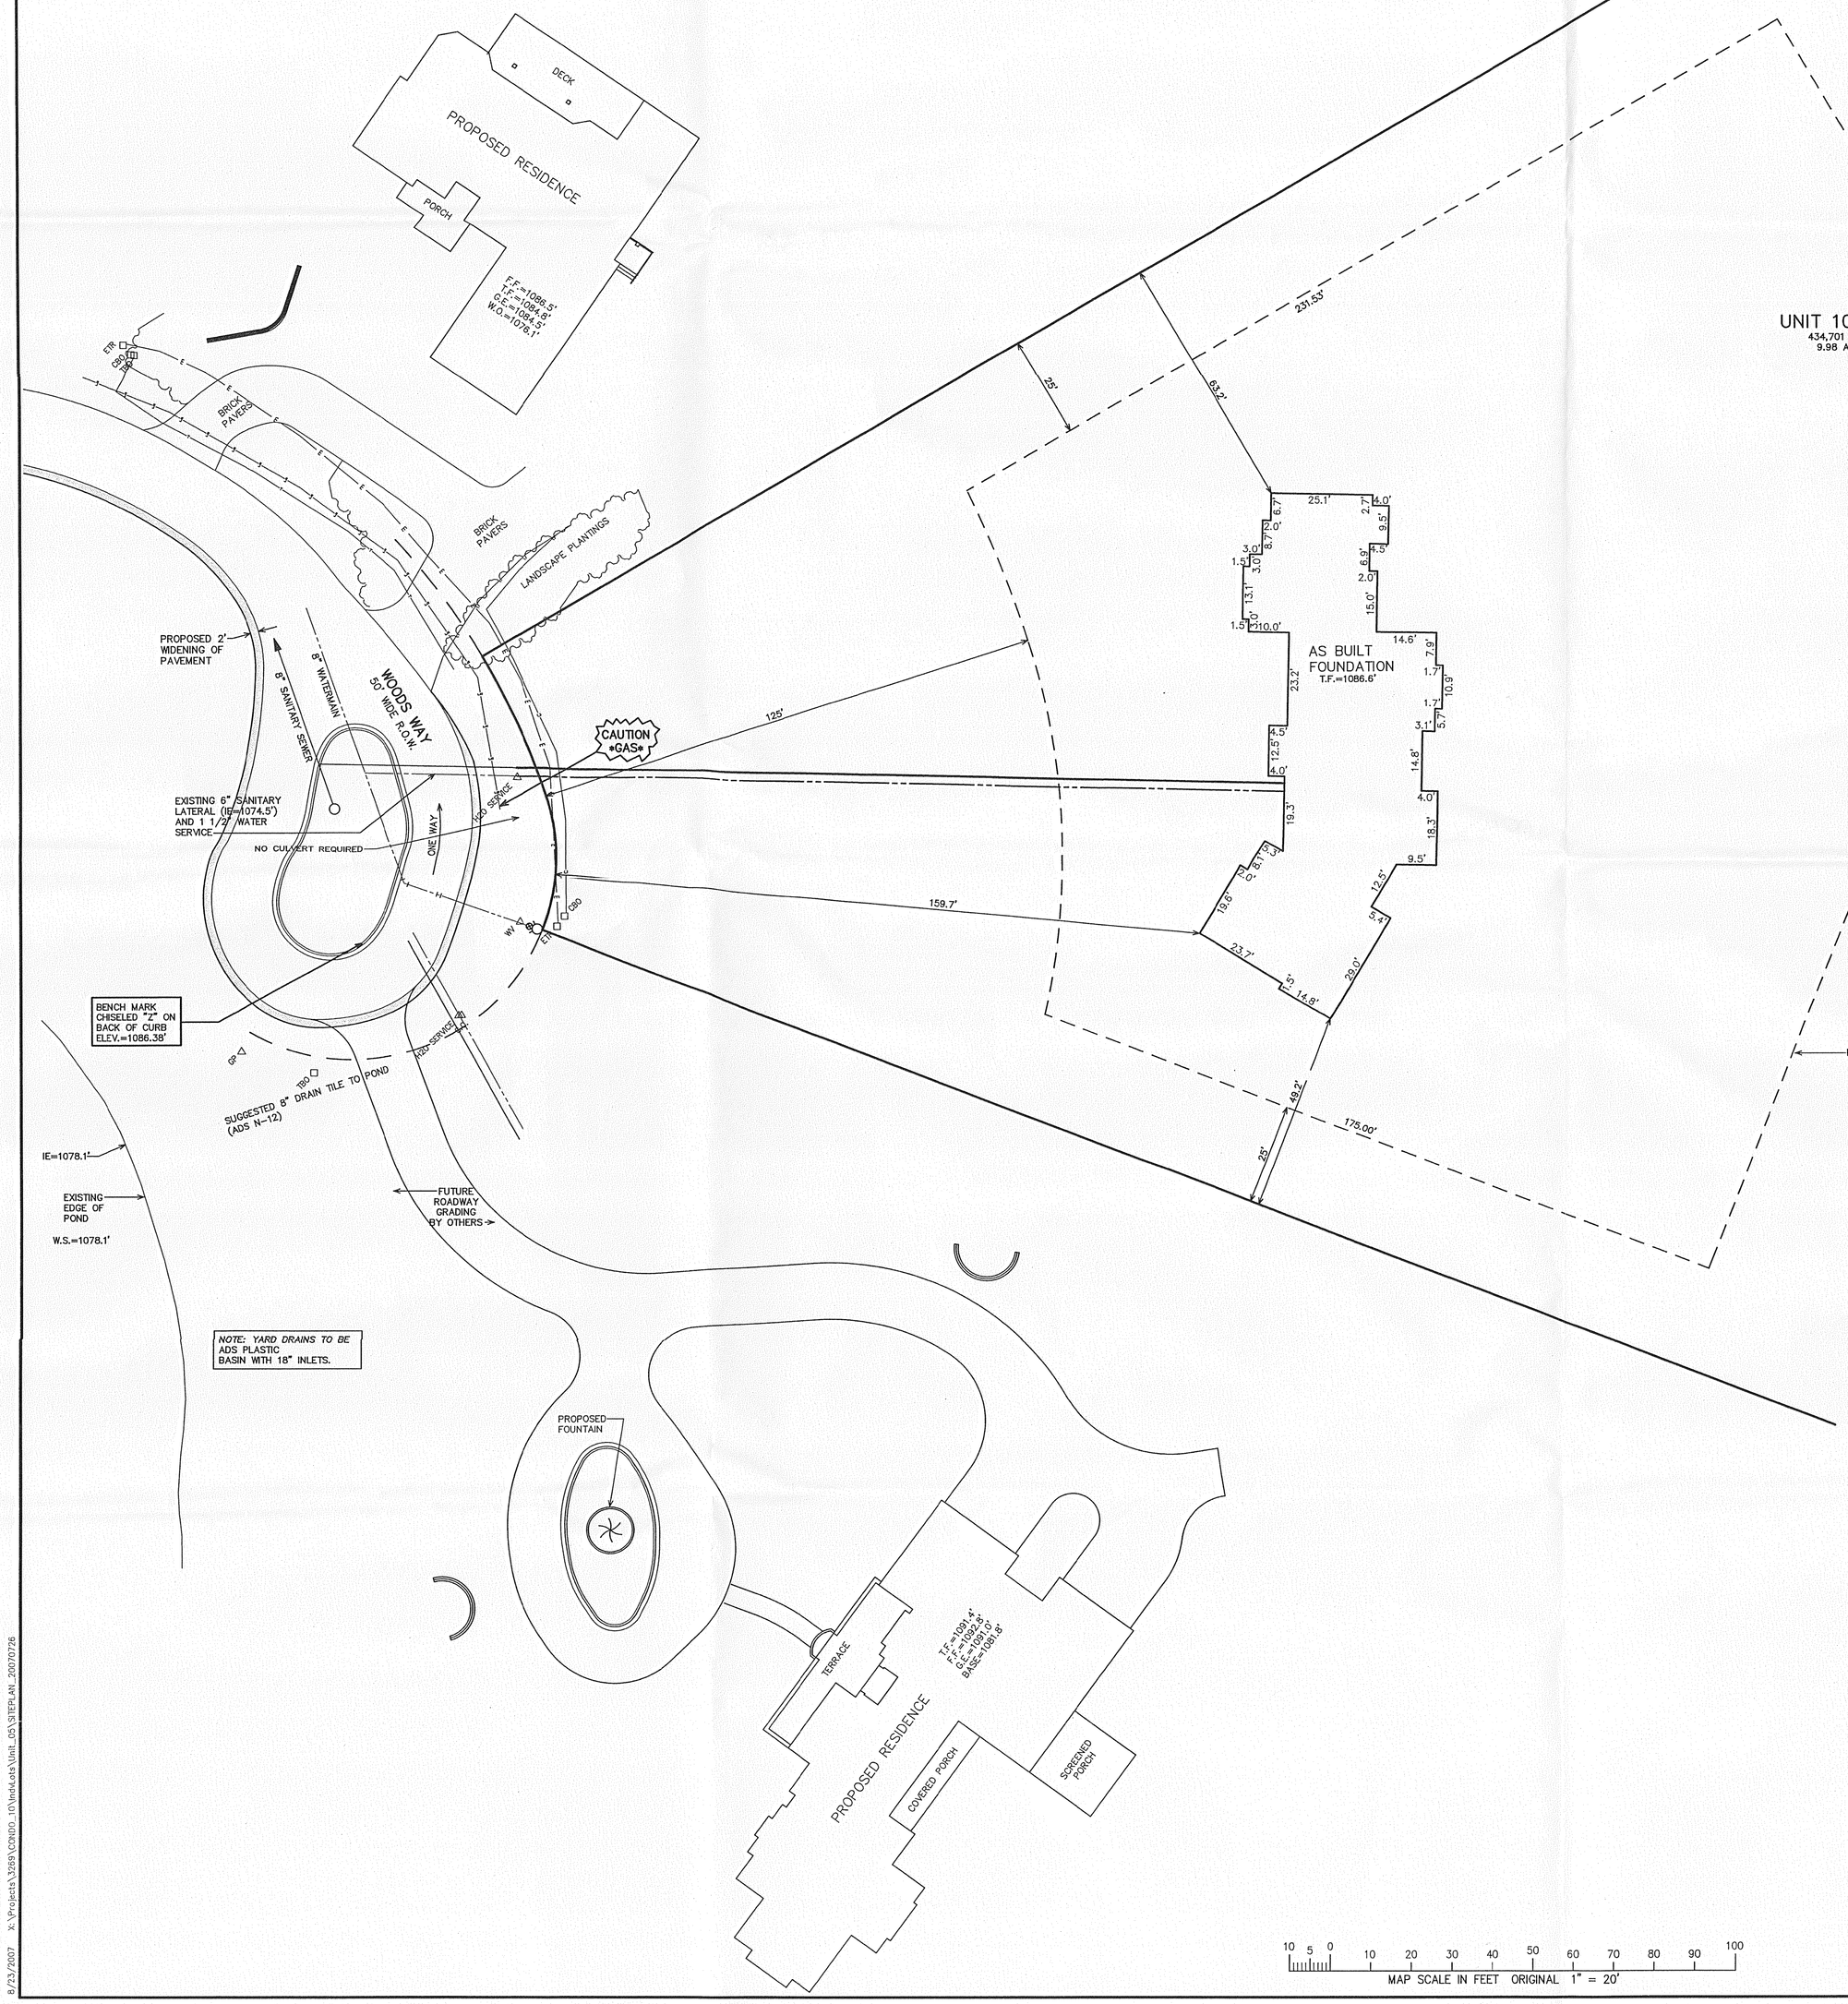

GRID NORTH

WISCONSIN COORDINATE SYSTEM
SOUTH ZONE

NOTE: COPIES OF THIS MAP TO WHICH THE FOLLOWING CERTIFICATE WILL APPLY SHOW THE SURVEYOR'S ORIGINAL SEAL AND SIGNATURE IN RED INK. COPIES BY ANY OTHER MEANS MAY HAVE ALTERATIONS WHICH DO NOT REPRESENT THE SURVEYOR'S WORK PRODUCT.

I HEREBY CERTIFY THAT THE ABOVE DESCRIBED PROPERTY HAS BEEN SURVEYED UNDER MY DIRECTION AND THAT THE ABOVE MAP IS A TRUE REPRESENTATION THEREOF AND SHOWS THE SIZE AND LOCATION OF THE PROPERTY AND ITS EXTERIOR BOUNDARIES. THIS SURVEY IS MADE FOR THE USE OF THE PRESENT OWNERS OF THE PROPERTY, AND ALSO THOSE WHO PURCHASE, MORTGAGE, OR GUARANTEE THE TITLE THERETO WITHIN ONE YEAR FROM THE DATE HEREOF.

DATED: NOVEMBER 15, 2006

PETER S. GORDON R.L.S. 2101

REVISED 08-23-2007
TO SHOW SIZE & LOCATION OF AS BUILT FOUNDATION

WISCONSIN
PETER S. GORDON S-2101 ELKHORN, WI
LAND SURVEYOR

RECEIVED
AUG 30 2007
SJK

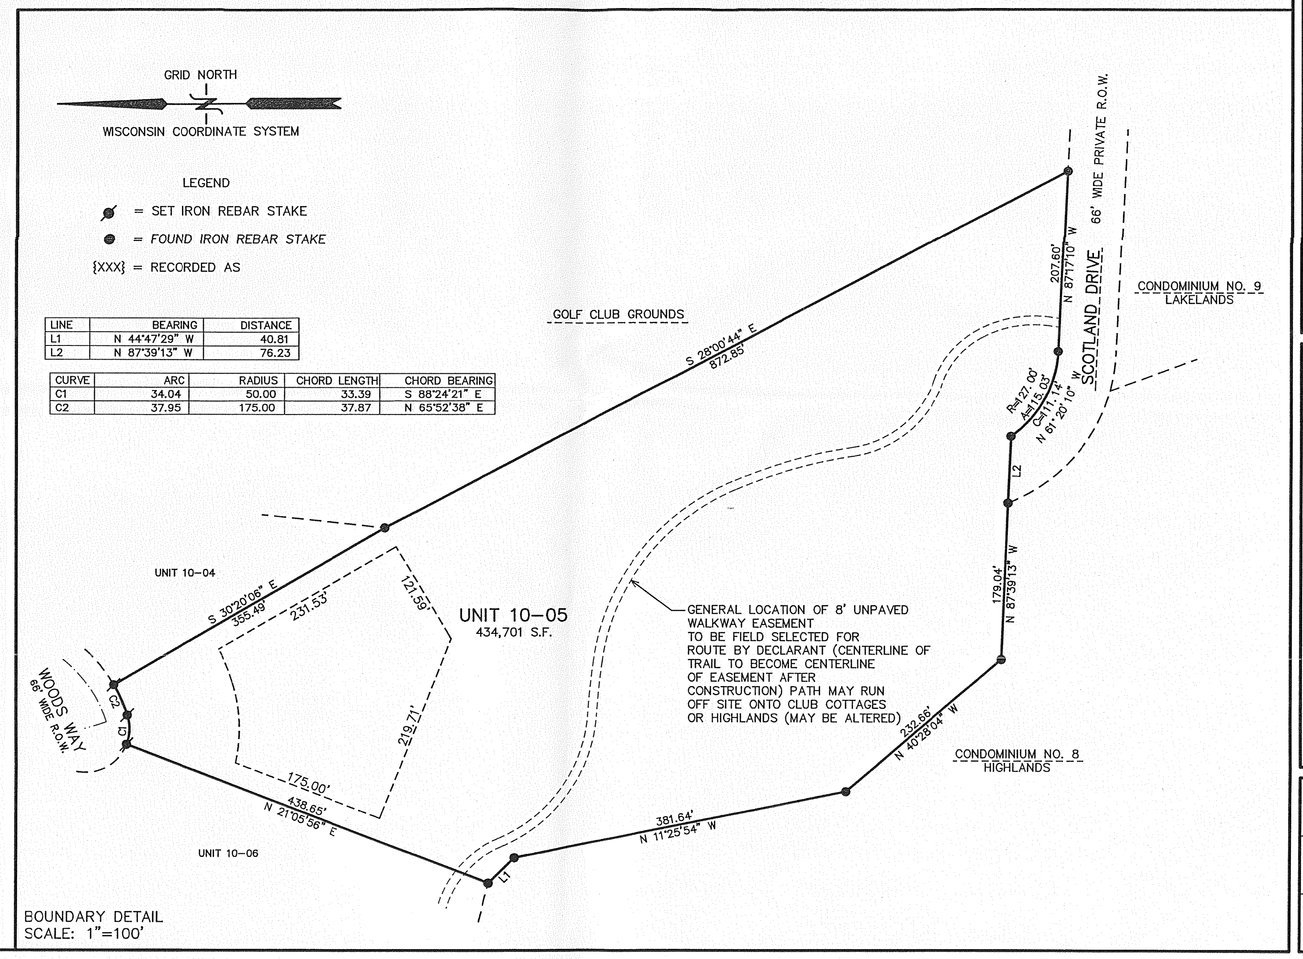

BOUNDARY DETAIL
SCALE: 1"=100'

10 5 0 10 20 30 40 50 60 70 80 90 100
MAP SCALE IN FEET ORIGINAL 1" = 20'

- WORK ORDERED BY -
GEORGE ADAMS
PO BOX 379
FONTANA, WI. 53125

FARRIS, HANSEN & ASSOCIATES, INC.
ENGINEERING – ARCHITECTURE – SURVEYING
7 RIDGWAY COURT P.O. BOX 437
ELKHORN, WISCONSIN 53121
OFFICE: (262) 723-2098 FAX: (262) 723-5886

REVISIONS
7/16/2007-KB REVISED PROPOSED RESIDENCE SIZE AND LOCATION
7/26/2007 – LK ADVANCE PLAN
7-27-2007 PSG ADD NOTES

PROJECT NO.
3269.10.05
DATE
11/15/2006
SHEET NO.
1 OF 1

8/23/2007 X:\Projects\3269\CONDO_10\Mxd\4x4\Unit_05\STEPH.AN_20070726

JGN 10-5

817-3430