
HAROLD H. KOLB

REGISTERED PROFESSIONAL LAND SURVEYOR
LAKE GENEVA, WISCONSIN

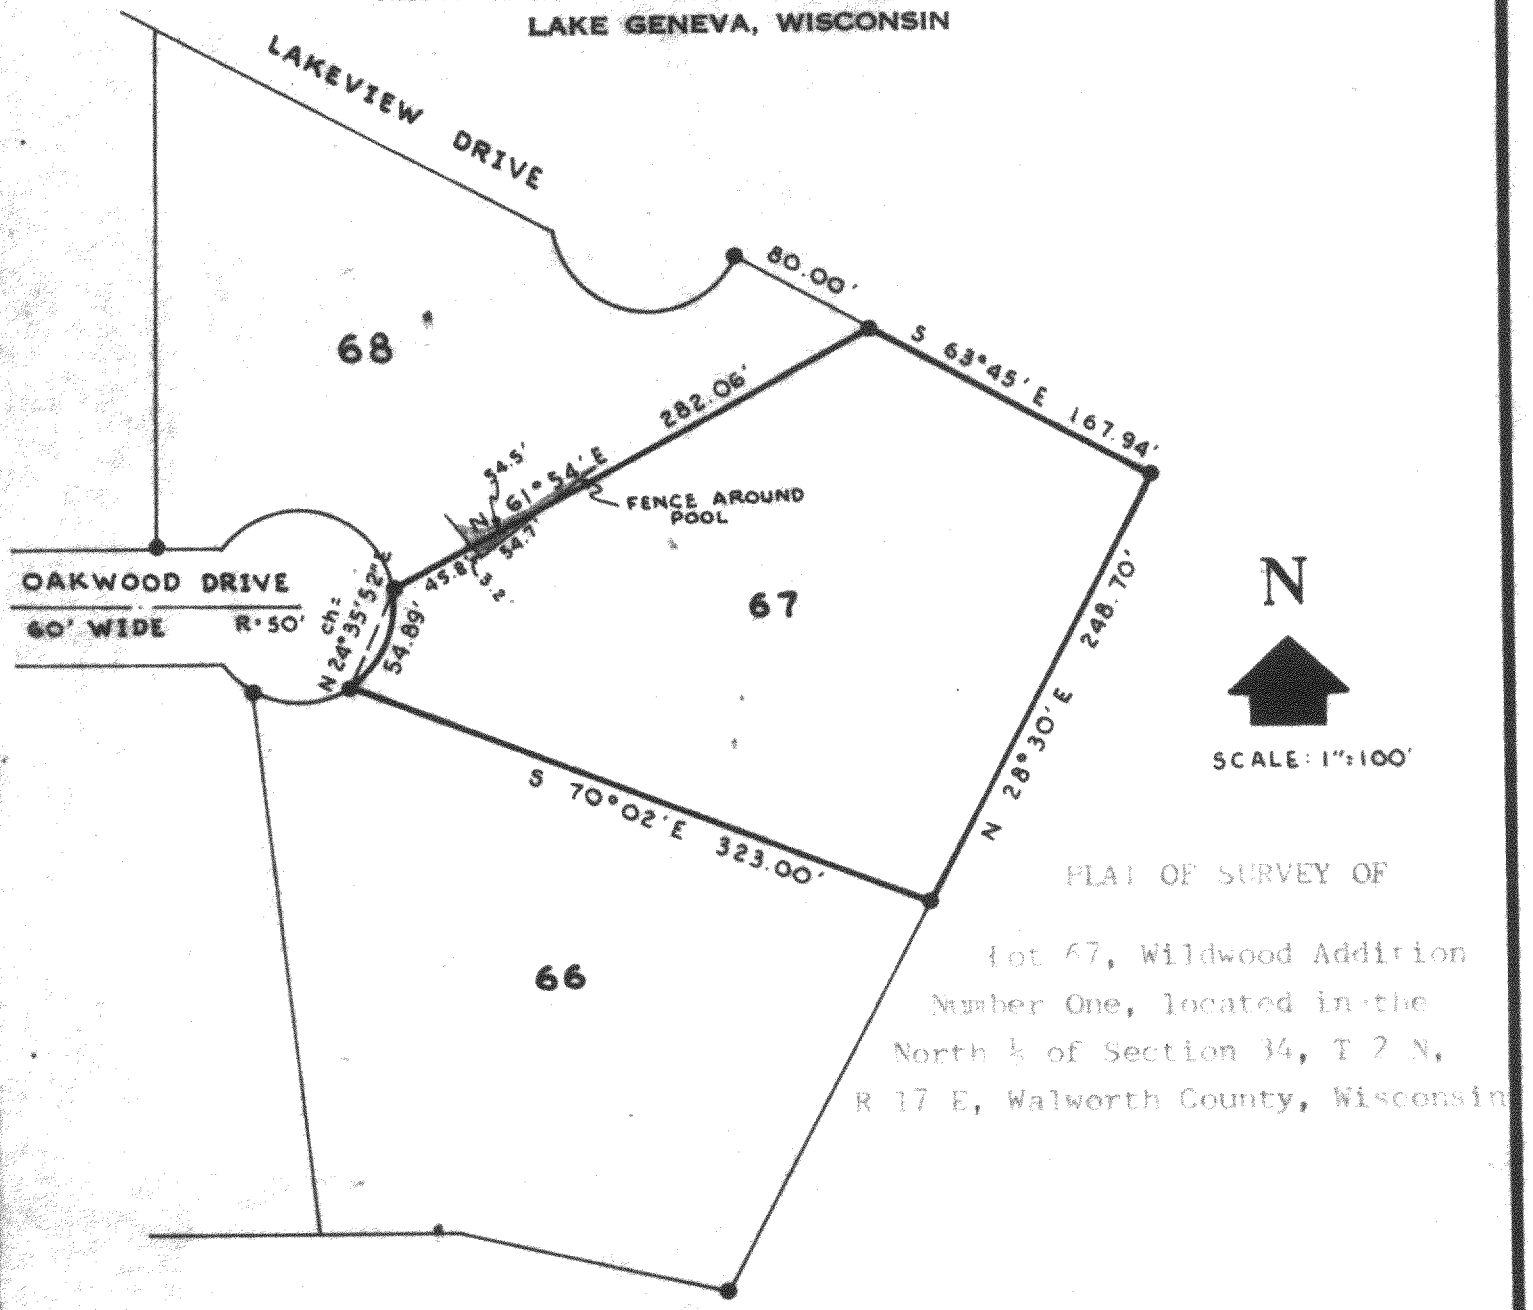

PLAT OF SURVEY OF

Lot 67, Wildwood Addition Number One, located in the North ½ of Section 34, T 2 N, R 17 E, Walworth County, Wisconsin

LEGEND

- ϕ — IRON PIPE FOUND
- O — IRON PIPE PLACED
- ● — Iron Rod Found
- x — SPIKE

WISCONSIN HAROLD H. KOLB S-187 LAKE GENEVA, WIS. LAND SURVEYOR

I, HAROLD H. KOLB, DO HEREBY CERTIFY THAT I HAVE SURVEYED THE PROPERTY HEREON DESCRIBED ACCORDING TO THE OFFICIAL RECORDS, AND THAT THE PLAT HEREON IS A CORRECT REPRESENTATION OF THE LOT LINES.

Harold H. Kolb

HAROLD H. KOLB
WISCONSIN REGISTERED LAND SURVEYOR, S-187

DATE March 8, 1973
REVISED: April 2, 1973

217-346

BRUNING 40-105 1M-6-71

217-334