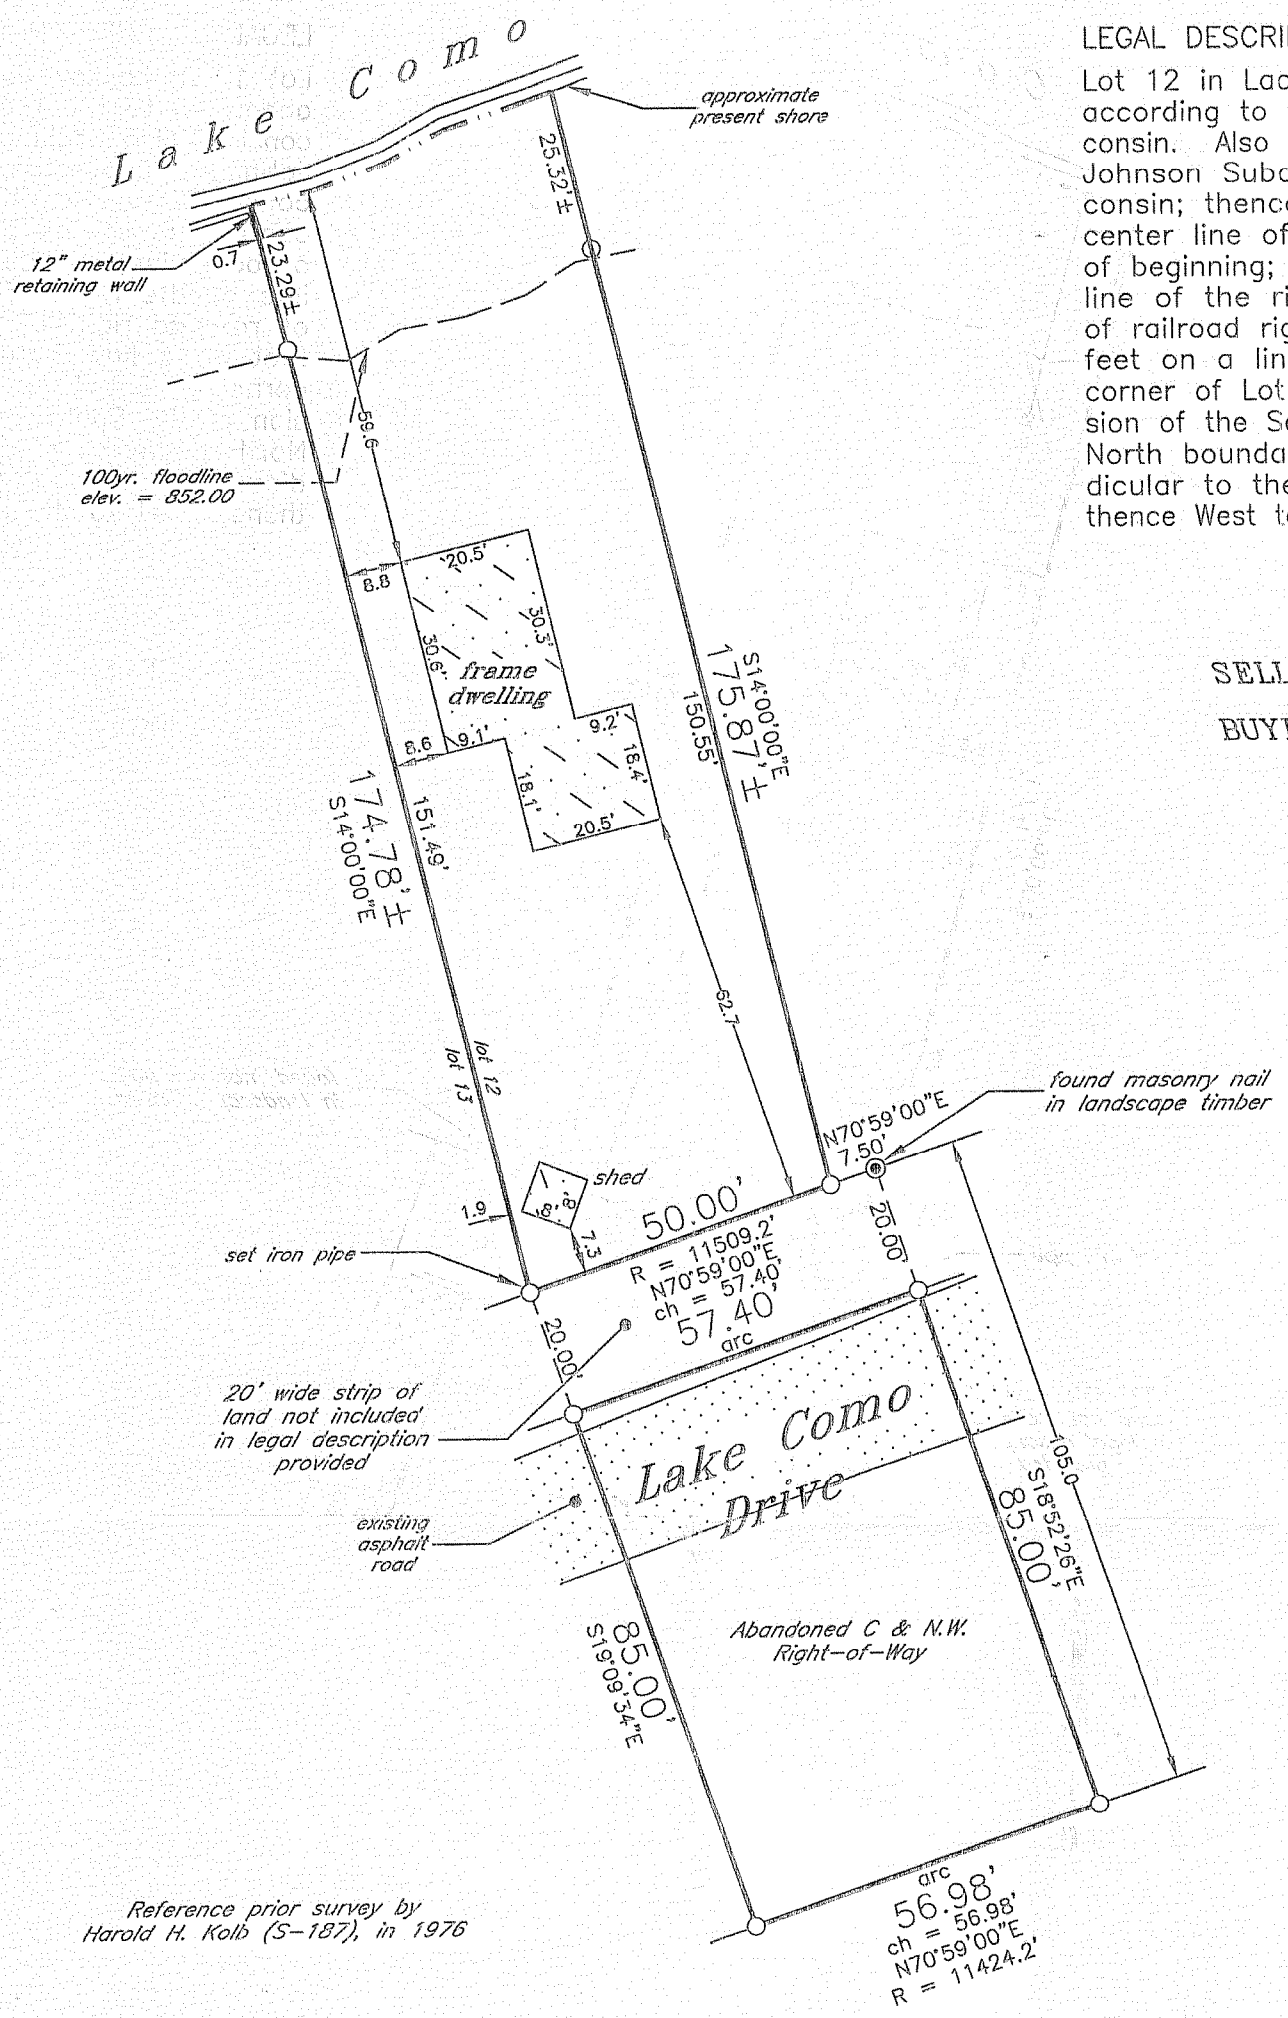


Reference prior survey by Harold H. Kolb (S-187), in 1976

denotes iron pipe found (unless noted)

Scale 1" = 30'

LEGAL DESCRIPTION (AS FURNISHED).....

Lot 12 in Lackey-Johnson Subdivision, in the Town of Geneva, according to the recorded plat thereof, Walworth County, Wisconsin. Also begin at the Southwest corner of Lot 12, Lackey-Johnson Subdivision, Town of Geneva, Walworth County, Wisconsin; thence continue South on a line perpendicular to the center line of the Railroad right of way 20 feet to the point of beginning; thence continue South on this line to the South line of the right of way; thence East along said South line of railroad right of way to a point that is approximately 105 feet on a line from a point 7.5 feet East of the Southeast corner of Lot 12 aforesaid, which point lying along an extension of the South line of Lot 12 aforesaid; thence North to the North boundary of said Railroad right of way that is perpendicular to the North boundary of said Railroad right of way; thence West to the point of beginning.

SELLER: Richard A. Rehm Revocable Trust

BUYER: David L. and Patricia R. Polivka

address: W3772 S. Shore Drive

tax key no.: JLJ 00005

J.K.R. SURVEYING, INC.
8121 22ND AVENUE, KENOSHA, WI. 53143

I hereby certify that the above described property was surveyed under my direction and that this plat is a true representation thereof and shows the size and location of the property, its exterior boundaries, the location and dimensions of all visible structures thereon, fences, apparent easements and roadways and visible encroachments, if any.

This survey is made for the exclusive use of the present owners of the property, and those who purchase, mortgage or guarantee the title thereto, within one (1) year from the date hereof.

WISCONSIN JEFFREY K. RAMPART 2141 KENOSHA, WI LAND SURVEYOR

S U R V E Y O R

June 4, 2008

RECEIVED
JUN 25 2008

Plat of Survey of

LOT 12 & PARCEL TO SOUTH IN

LACKEY-JOHNSON SUBDIVISION

in SE1/4 Section 28-2-17

TOWN OF GENEVA
WALWORTH COUNTY, WIS.

-for-
Century 21/Herget & Plavsic
and
Wells Fargo Bank, N.A.

JW-5

217-3497