LAND-MARK SURVEYING
Mark L. Miritz
Wisconsin Registered Land Surveyor S-2582


N9330 Knuteson Drive
Whitewater, WI 53190
Phone:(262)495-3284
FAX : (262) 495-8421
LAND-MARKSURVEYING.COM


PLAT OF SURVEY

LOTS 11828- 11830 OF BLOCK 212 OF LAKE COMO BEACH, A SUBDIVISION LOCATED IN TOWN 2 NORTH, RANGE 17 EAST, WALWORTH COUNTY, WISCONSIN.

OWNERS: BRIAN & ANNA BROSSARD
N3084 CANARY ROAD
LAKE GENEVA, WI 53147

ZONED R-2

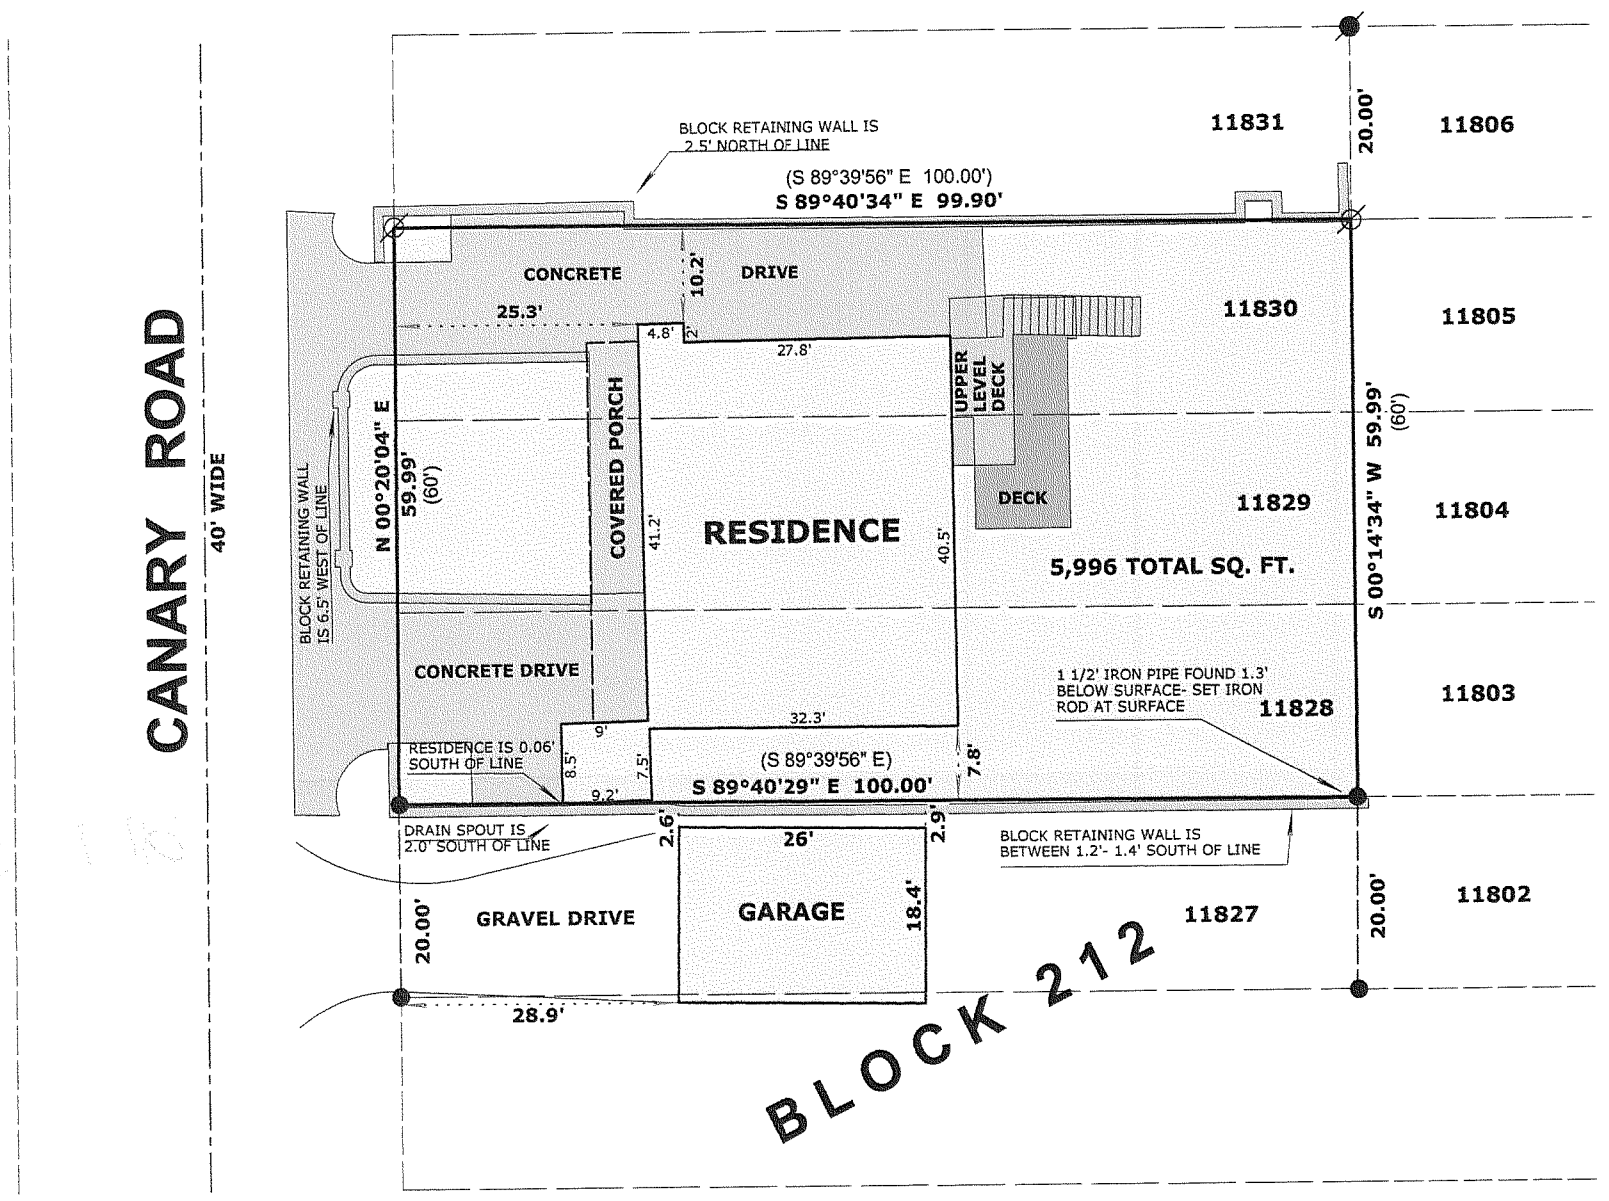

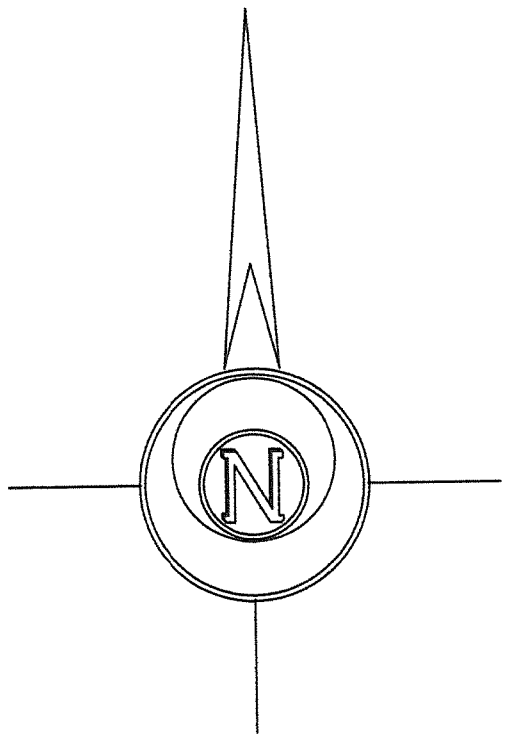

THE EAST LINE OF CANARY STREET WAS ASSUMED TO BEAR N 0°20'04" W AS PLATTED

RECEIVED
SEP 2 5 2008

WISCONSIN
MARK L. MIRITZ
S-2582
WHITEWATER, WI
LAND SURVEYOR

LEGEND

⌀	FOUND IRON PIPE
●	FOUND IRON ROD
●	SET IRON ROD, 24" LONG, WEIGHING 1.5 LBS./LINEAL FT., 3/4" DIA.
(x x)	RECORDED AS DIMENSION

SCALE: 1 INCH = 20 FEET

"I hereby certify that the above described property has been surveyed by me or under my direction and that the above map is a true representation thereof and shows the size and location of the property, its exterior boundaries, the location of all visible structures and dimensions of all principal buildings thereon, boundary fences, apparent easements, roadways and visible encroachments, if any."
"This survey is made for the use of the present owners of the property, and also those who purchase, mortgage, or guarantee the title thereto within one year from date hereof."

Mark L. Miritz

MARK L. MIRITZ
WISCONSIN REGISTERED
LAND SURVEYOR S-2582

DATE: SEPT. 16, 2008 **JOB NO. 08.903**