
HAROLD H. KOLB

REGISTERED PROFESSIONAL LAND SURVEYOR
LAKE GENEVA, WISCONSIN

PLAT OF SURVEY OF

Lots 2342-2356, Block 40, Lake Como Beach Subdivision, T 2 N, R 17 E, Walworth County, Wisconsin.

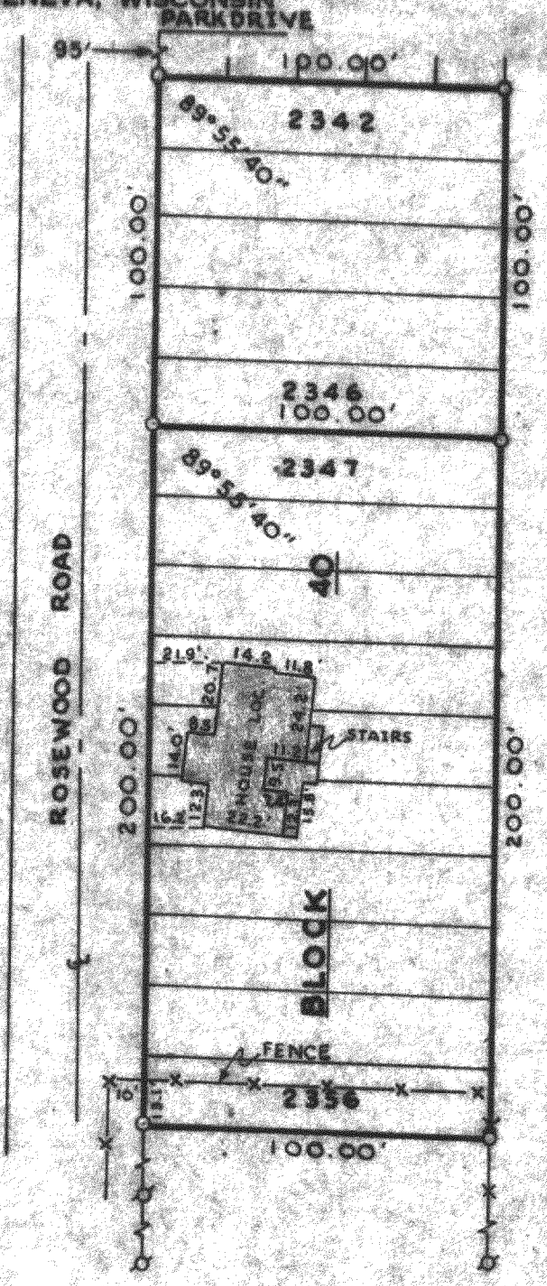

N

SCALE: 1"=50'

LEGEND

- ϕ — IRON PIPE FOUND
- O — IRON PIPE PLACED
- ● — CONCRETE MONUMENT
- x — SPIKE

WISCONSIN
HAROLD H. KOLB
S-187
LAKE GENEVA, WIS.
LAND SURVEYOR

I, HAROLD H. KOLB, DO HEREBY CERTIFY THAT I HAVE SURVEYED THE PROPERTY HEREON DESCRIBED ACCORDING TO THE OFFICIAL RECORDS, AND THAT THE PLAT HEREON IS A CORRECT REPRESENTATION OF THE LOT LINES.

Harold H. Kolb

HAROLD H. KOLB
WISCONSIN REGISTERED LAND SURVEYOR, S-187
DATE August 10, 1973

JCCB-403

2 17-356

BRUNING 40-105 1M-6-71