LAND-MARK SURVEYING
Mark L. Miritz

Wisconsin Registered Land Surveyor S-2582

N9330 Knuteson Drive
Whitewater, WI 53190
Phone:(262)495-3284
FAX : (262) 495-8421
LAND-MARKSURVEYING.COM

PLAT OF SURVEY

A PORTION OF LAKE SHORE DRIVE ADJACENT TO BLOCK 11, LAKE COMO BEACH SUBDIVISION THIRD MAP, LOCATED IN SECTION 27, TOWN 2 NORTH, RANGE 17 EAST, GENEVA TOWNSHIP, WALWORTH COUNTY, WISCONSIN.

ORDERED BY: COMO BEACH PROPERY OWNERS ASSOCIATION
P. O. BOX 268
LAKE GENEVA, WI 53147

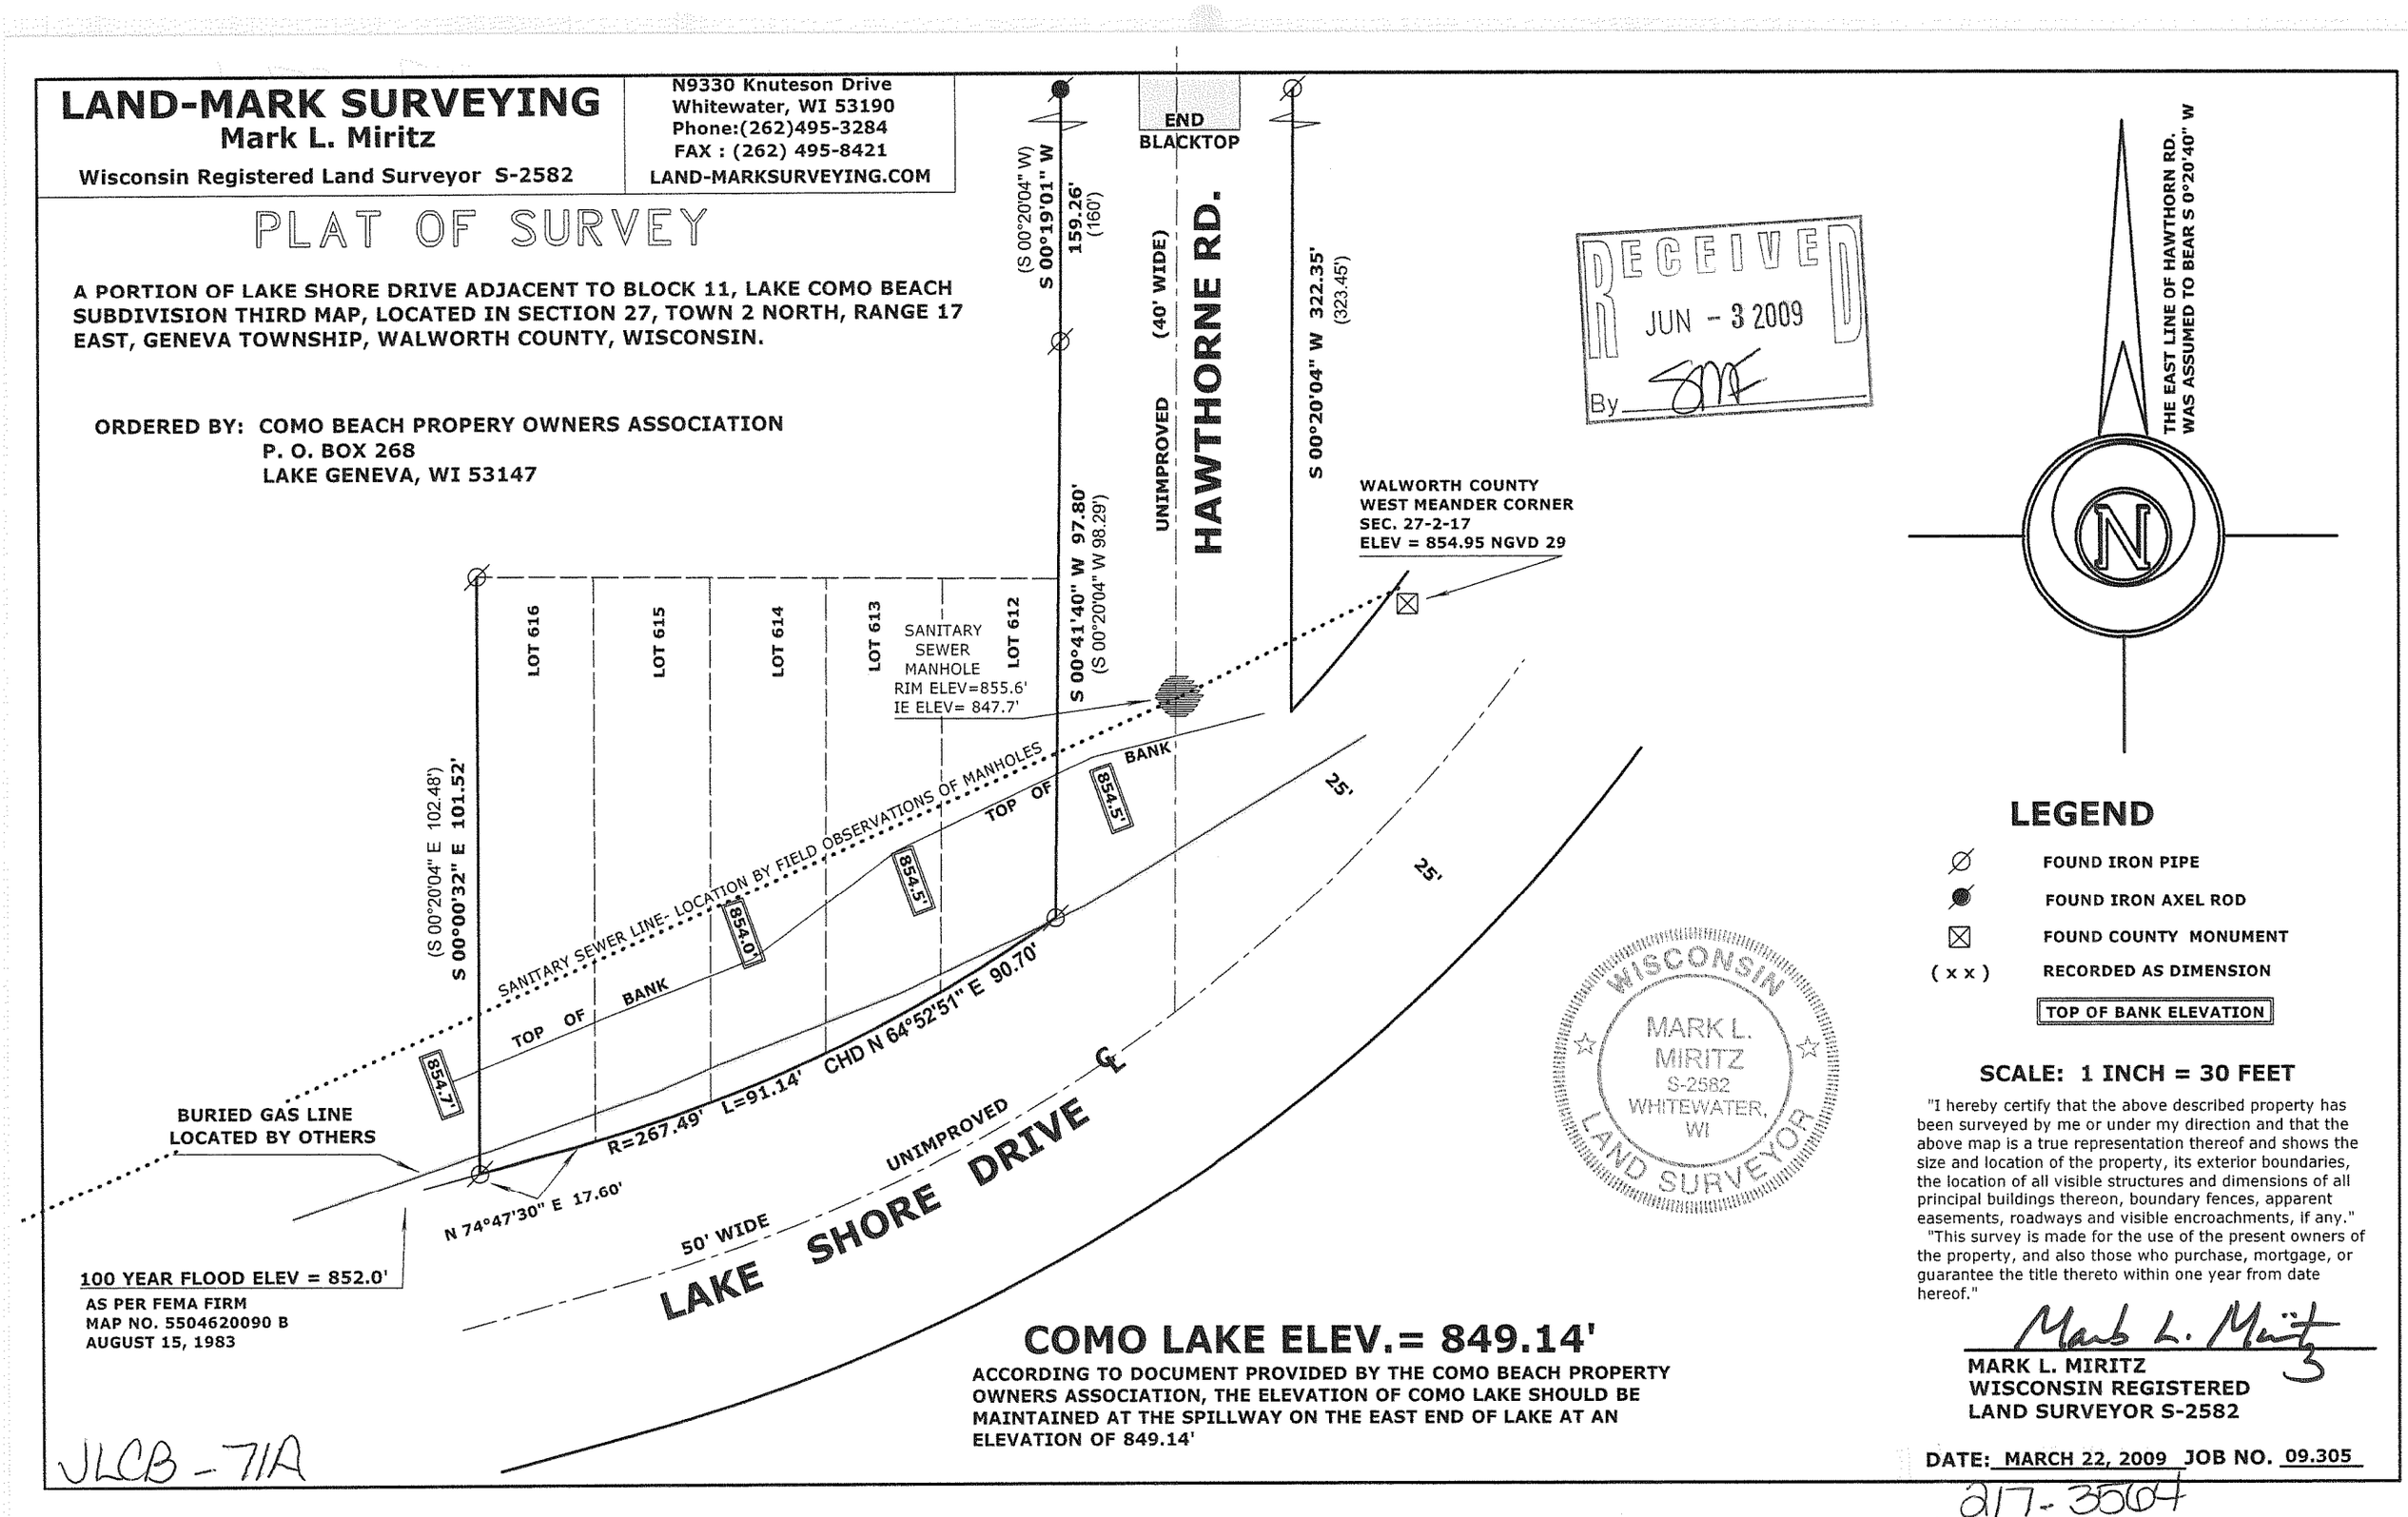

RECEIVED
JUN - 3 2009
By

WISCONSIN
MARK L. MIRITZ
S-2582
WHITEWATER, WI
LAND SURVEYOR

LEGEND

- ⌀ FOUND IRON PIPE
- ● FOUND IRON AXEL ROD
- ⊠ FOUND COUNTY MONUMENT
- (x x) RECORDED AS DIMENSION
- TOP OF BANK ELEVATION

SCALE: 1 INCH = 30 FEET

"I hereby certify that the above described property has been surveyed by me or under my direction and that the above map is a true representation thereof and shows the size and location of the property, its exterior boundaries, the location of all visible structures and dimensions of all principal buildings thereon, boundary fences, apparent easements, roadways and visible encroachments, if any."

"This survey is made for the use of the present owners of the property, and also those who purchase, mortgage, or guarantee the title thereto within one year from date hereof."

Mark L. Miritz

MARK L. MIRITZ
WISCONSIN REGISTERED
LAND SURVEYOR S-2582

DATE: MARCH 22, 2009 JOB NO. 09.305

COMO LAKE ELEV.= 849.14'

ACCORDING TO DOCUMENT PROVIDED BY THE COMO BEACH PROPERTY OWNERS ASSOCIATION, THE ELEVATION OF COMO LAKE SHOULD BE MAINTAINED AT THE SPILLWAY ON THE EAST END OF LAKE AT AN ELEVATION OF 849.14'

JLCB - 71A

217-3564