LAND-MARK SURVEYING
Mark L. Miritz
Wisconsin Registered Land Surveyor S-2582

N9330 Knuteson Drive
Whitewater, WI 53190
Phone:(262)495-3284
FAX : (262) 495-8421
LAND-MARKSURVEYING.COM

PLAT OF SURVEY

LOT 11468 THROUGH LOT 11477 INCLUSIVE AND LOT 11483 THROUGH LOT 11487 INCLUSIVE, BLOCK 206, FIFTH MAP OF LAKE COMO BEACH SUBDIVISION, LOCATED IN PART OF SECTION 29, TOWN 2 NORTH, RANGE 17 EAST, GENEVA TOWNSHIP, WALWORTH COUNTY, WISCONSIN.

OWNERS OF TAX KEY JLCB 02496
LOT 11483 THROUGH LOT 11487
EUGENE E. BIOLIK
DANUTH LUCARZ
7846 W. LAWRENCE APT. C
NORRIDGE, IL 60706

OWNER OF TAX KEY JLCB 02494
LOT 11468 THROUGH LOT 11477
EUGENE BIOLIK
7846 W. LAWRENCE APT. C
NORRIDGE, IL 60607

RECEIVED
JUN - 3 2009
By

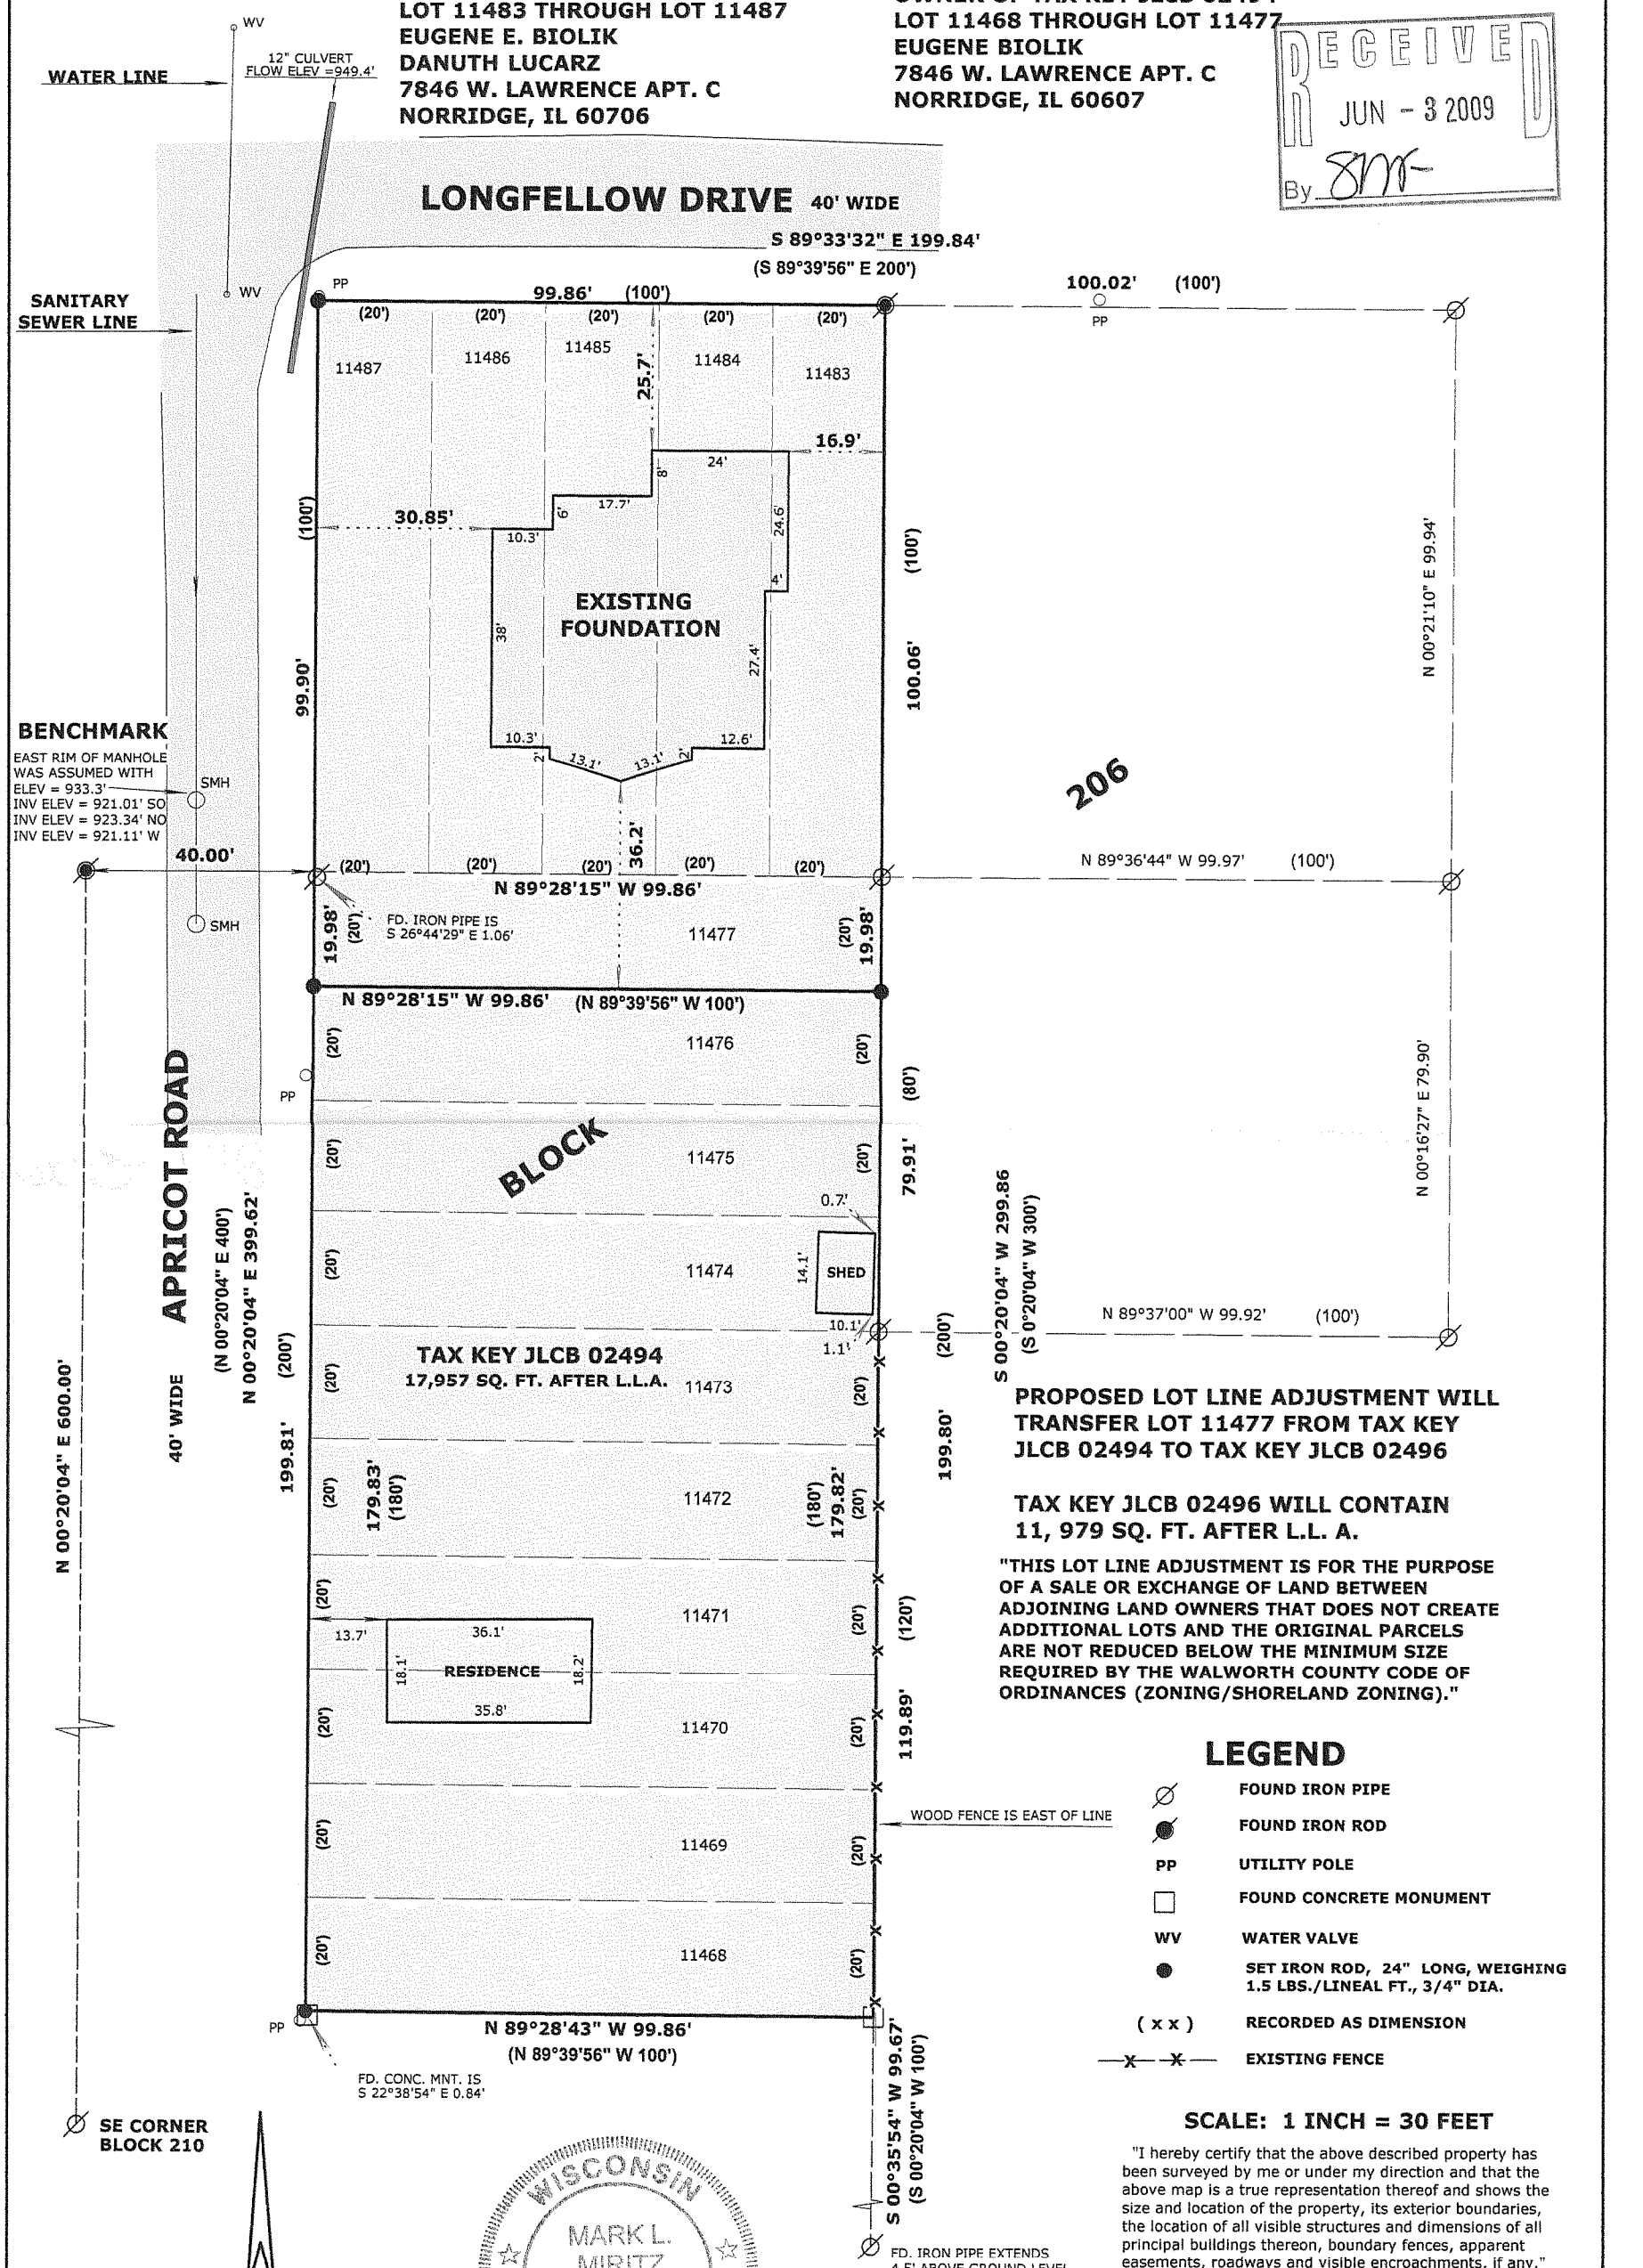

PROPOSED LOT LINE ADJUSTMENT WILL TRANSFER LOT 11477 FROM TAX KEY JLCB 02494 TO TAX KEY JLCB 02496

TAX KEY JLCB 02496 WILL CONTAIN 11, 979 SQ. FT. AFTER L.L. A.

"THIS LOT LINE ADJUSTMENT IS FOR THE PURPOSE OF A SALE OR EXCHANGE OF LAND BETWEEN ADJOINING LAND OWNERS THAT DOES NOT CREATE ADDITIONAL LOTS AND THE ORIGINAL PARCELS ARE NOT REDUCED BELOW THE MINIMUM SIZE REQUIRED BY THE WALWORTH COUNTY CODE OF ORDINANCES (ZONING/SHORELAND ZONING)."

LEGEND

⌀	FOUND IRON PIPE
●	FOUND IRON ROD
PP	UTILITY POLE
□	FOUND CONCRETE MONUMENT
WV	WATER VALVE
●	SET IRON ROD, 24" LONG, WEIGHING 1.5 LBS./LINEAL FT., 3/4" DIA.
(x x)	RECORDED AS DIMENSION
—x—x—	EXISTING FENCE

SCALE: 1 INCH = 30 FEET

"I hereby certify that the above described property has been surveyed by me or under my direction and that the above map is a true representation thereof and shows the size and location of the property, its exterior boundaries, the location of all visible structures and dimensions of all principal buildings thereon, boundary fences, apparent easements, roadways and visible encroachments, if any."

"This survey is made for the use of the present owners of the property, and also those who purchase, mortgage, or guarantee the title thereto within one year from date hereof."

WISCONSIN
MARK L. MIRITZ
S-2582
WHITEWATER, WI
LAND SURVEYOR

Mark L. Miritz

MARK L. MIRITZ
WISCONSIN REGISTERED
LAND SURVEYOR S-2582

REVISED FEB. 13, 2009 TO SHOW FOUNDATION "AS BUILT"

DATE: NOV. 18, 2008 **JOB NO.** 08.1101

JLCB-2496 JLCB 2494 21-3506