
PREPARED FOR:
BASSO BUILDERS
403 SKYLINE DR
LAKE GENEVA, WI
53147

PLAT OF SURVEY

-OF-

LOTS 4983 THRU 4987, BLOCK 87 , LAKE COMO BEACH
A SUBDIVISION , LOCATED IN TOWN 2 NORTH, RANGE 17
EAST, WALWORTH COUNTY, WISCONSIN.

KROTT SURVEYING INC.
N3705 WILLOW BEND LANE
LAKE GENEVA WI. 53147
PHONE # (262)248-3697
FAX # (262)249-0639

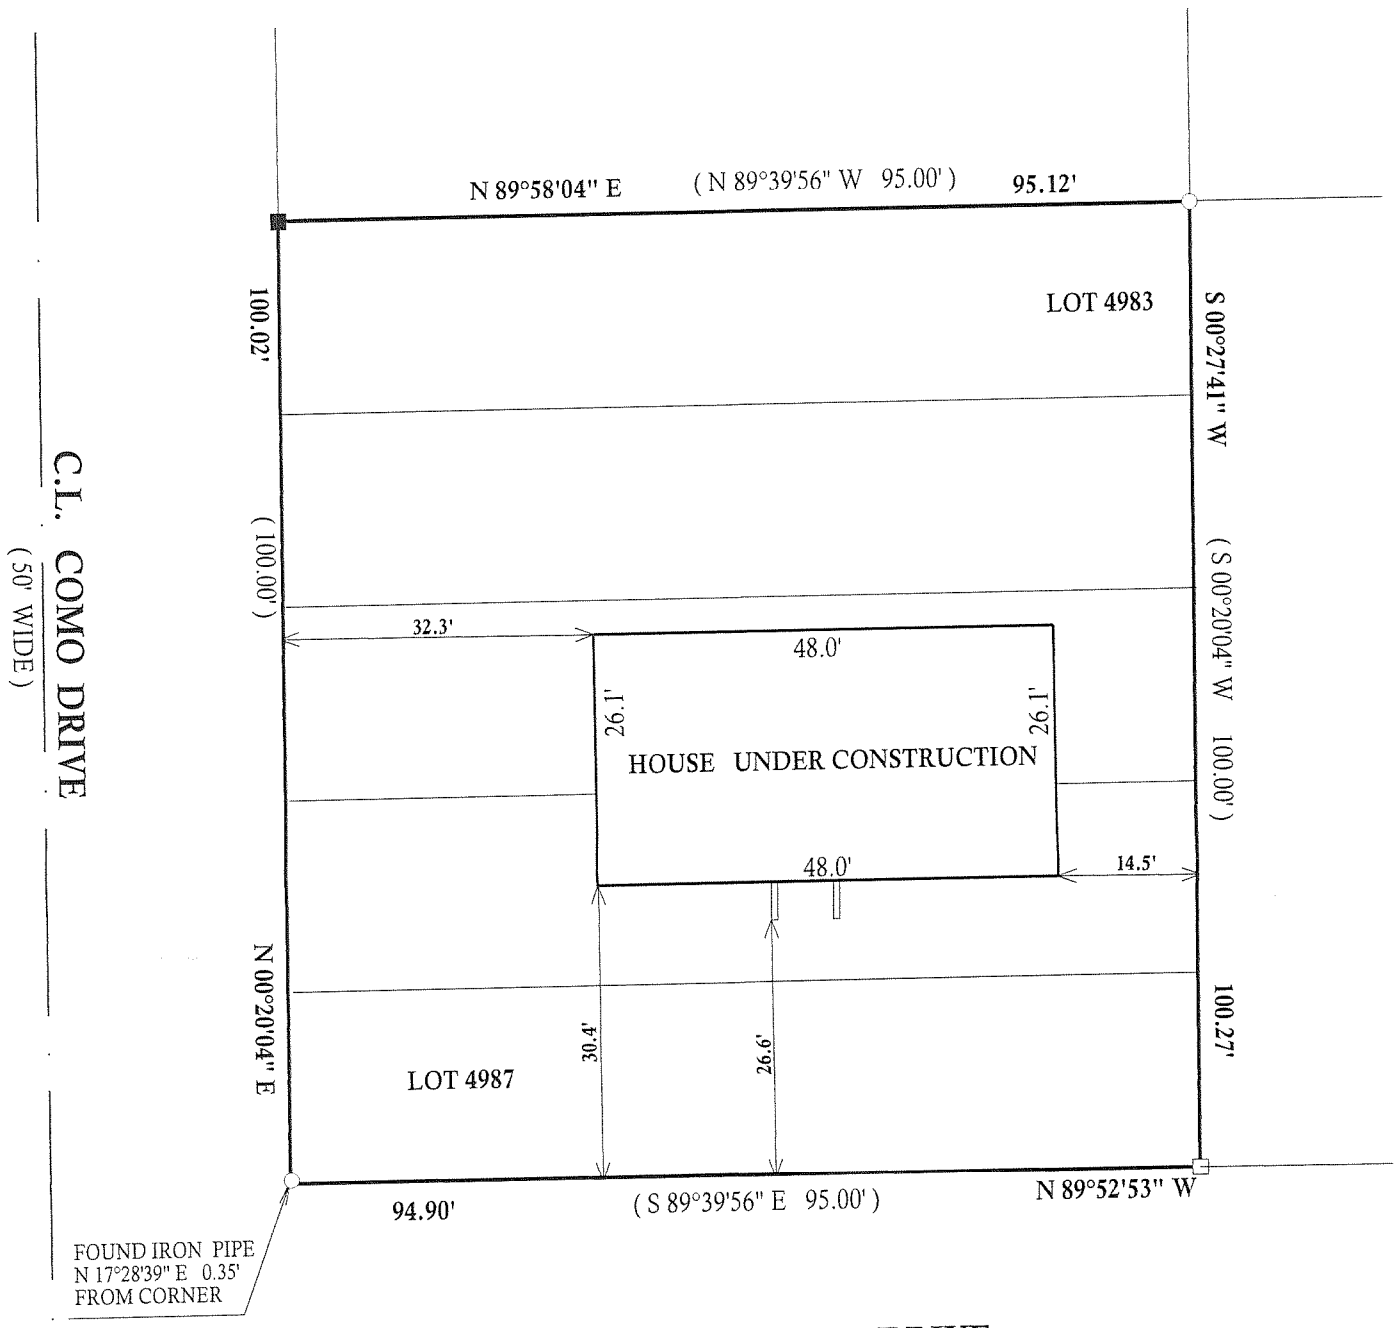

RECEIVED
AUG 24 2009
By

N
W E
S
SCALE 1" = 20'

WISCONSIN
JOHN P.
KROTT
S-2258
LAKE GENEVA
WIS.
LAND SURVEYOR

DATE OF LAST REVISION: 7 / 06 / 2009

DATED THIS 2nd, DAY OF MAY, 2009

LEGEND

- ○ FOUND IRON PIPE
- □ FOUND IRON BAR
- ■ SET IRON BAR
- (XX) RECORDED AS

JOB # 09-064AB TAX ID # JLCB00995

"I hereby certify that I have surveyed the above described property and that the above map is a true representation thereof and shows the size and location of all visible structures, apparent easements and encroachments if any."
This survey is made for the present owners of the property, and those who purchase, mortgage, or guarentee the title thereto, within one year from the date hereof.

JOHN KROTT S - 2258
Wisconsin Registered Land Surveyor
(original if signed in red)

217-3579