
PLAT OF SURVEY

LOT 20, GENEVA OAKS, a subdivision located in the Northwest ¼ of Section 4, Township 1 North, Range 17 East, Walworth County, Wisconsin.

Surveyed for: Beckwith –Design LLC

Survey address: N2395 Geneva Oaks Trail

RECEIVED
SEP 14 2009
By

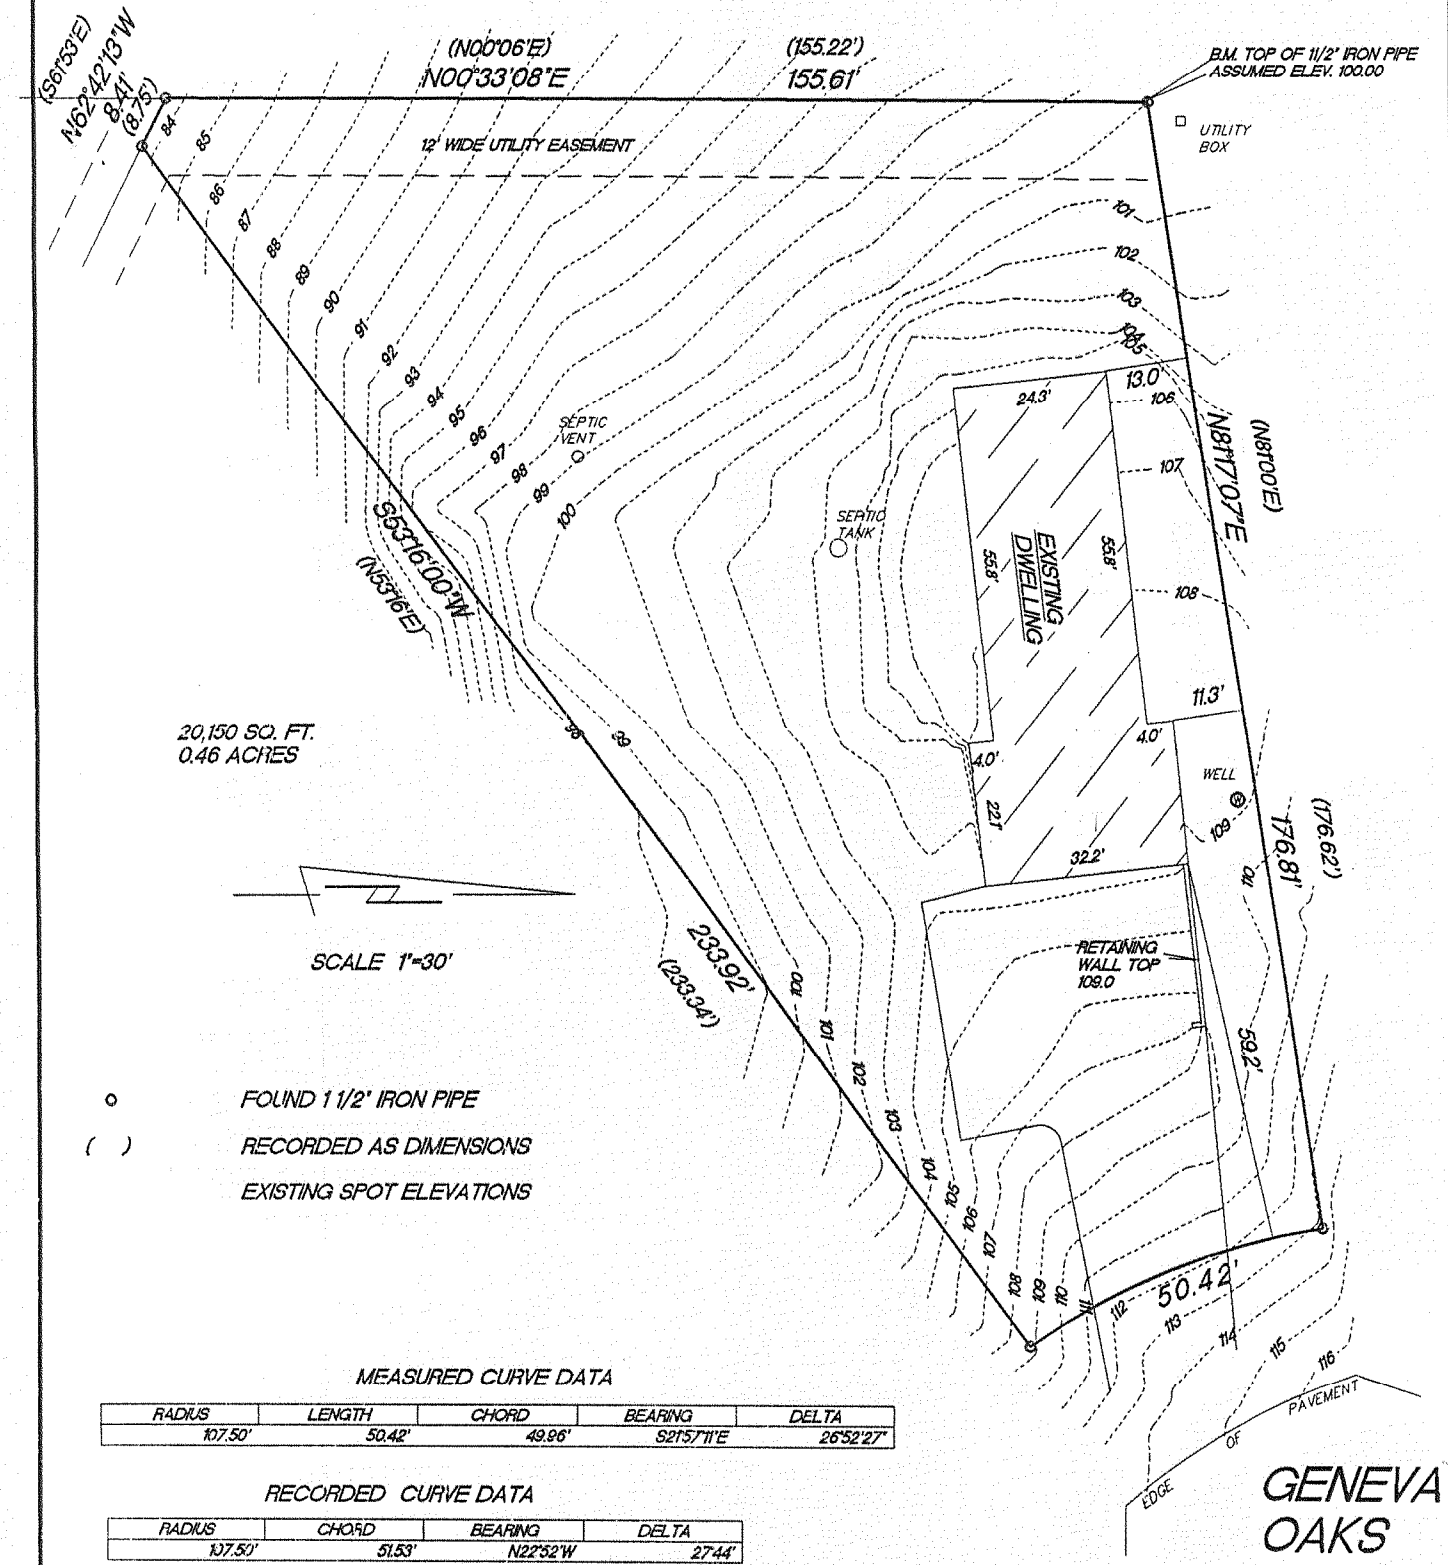

o FOUND 1 1/2" IRON PIPE

( ) RECORDED AS DIMENSIONS

EXISTING SPOT ELEVATIONS

MEASURED CURVE DATA

RADIUS	LENGTH	CHORD	BEARING	DELTA
107.50'	50.42'	49.96'	S21°57'11"E	26°52'27"

RECORDED CURVE DATA

RADIUS	CHORD	BEARING	DELTA
107.50'	51.53'	N22°52'W	27°44'

"I hereby certify that I have surveyed the above described property and that the above map is a true representation thereof and shows the size and location of the property, its exterior boundaries, the location of all visible structures and dimension of all principal buildings thereon, boundary fences, apparent easements, roadways and encroachments if any."

"This survey is made for the use of the present owners of the property, and also those who purchase, mortgage or guarantee the title thereto within one year from date hereof."

KETTLE MORAINE SURVEYING INC.
S75 W36245 Wilton Road
Eagle Wisconsin 53119
P.O. Box 357
(262) 594-3484
Terrance E. Pisarek R.L.S.

WISCONSIN
TERRANCE E. PISAREK S-1930 EAGLE, WISCONSIN
LAND SURVEYOR

THIS IS NOT AN ORIGINAL SURVEY UNLESS THE SEAL IS RED.

9/3/09	TEP	TEP	09084
DATE	FIELD WORK BY	DRAWN BY	JOB NUMBER

IG0 - 20

117 - 3080