
PREPARED FOR
NANCY SPRAGUE
W3555 PARK DR.
LAKE GENEVA WI. 53147

PLAT OF SURVEY

-OF-

LOTS 1524 THRU 1528 BLOCK 25, LAKE COMO BEACH SUBDIVISION LOCATED IN TOWN 2 NORTH, RANGE 17 EAST, WALWORTH COUNTY, WISCONSIN.

KROTT SURVEYING INC.
N3705 WILLOW BEND LANE
LAKE GENEVA WI. 53147
PHONE # (262)248-3697
FAX # (262)249-0639

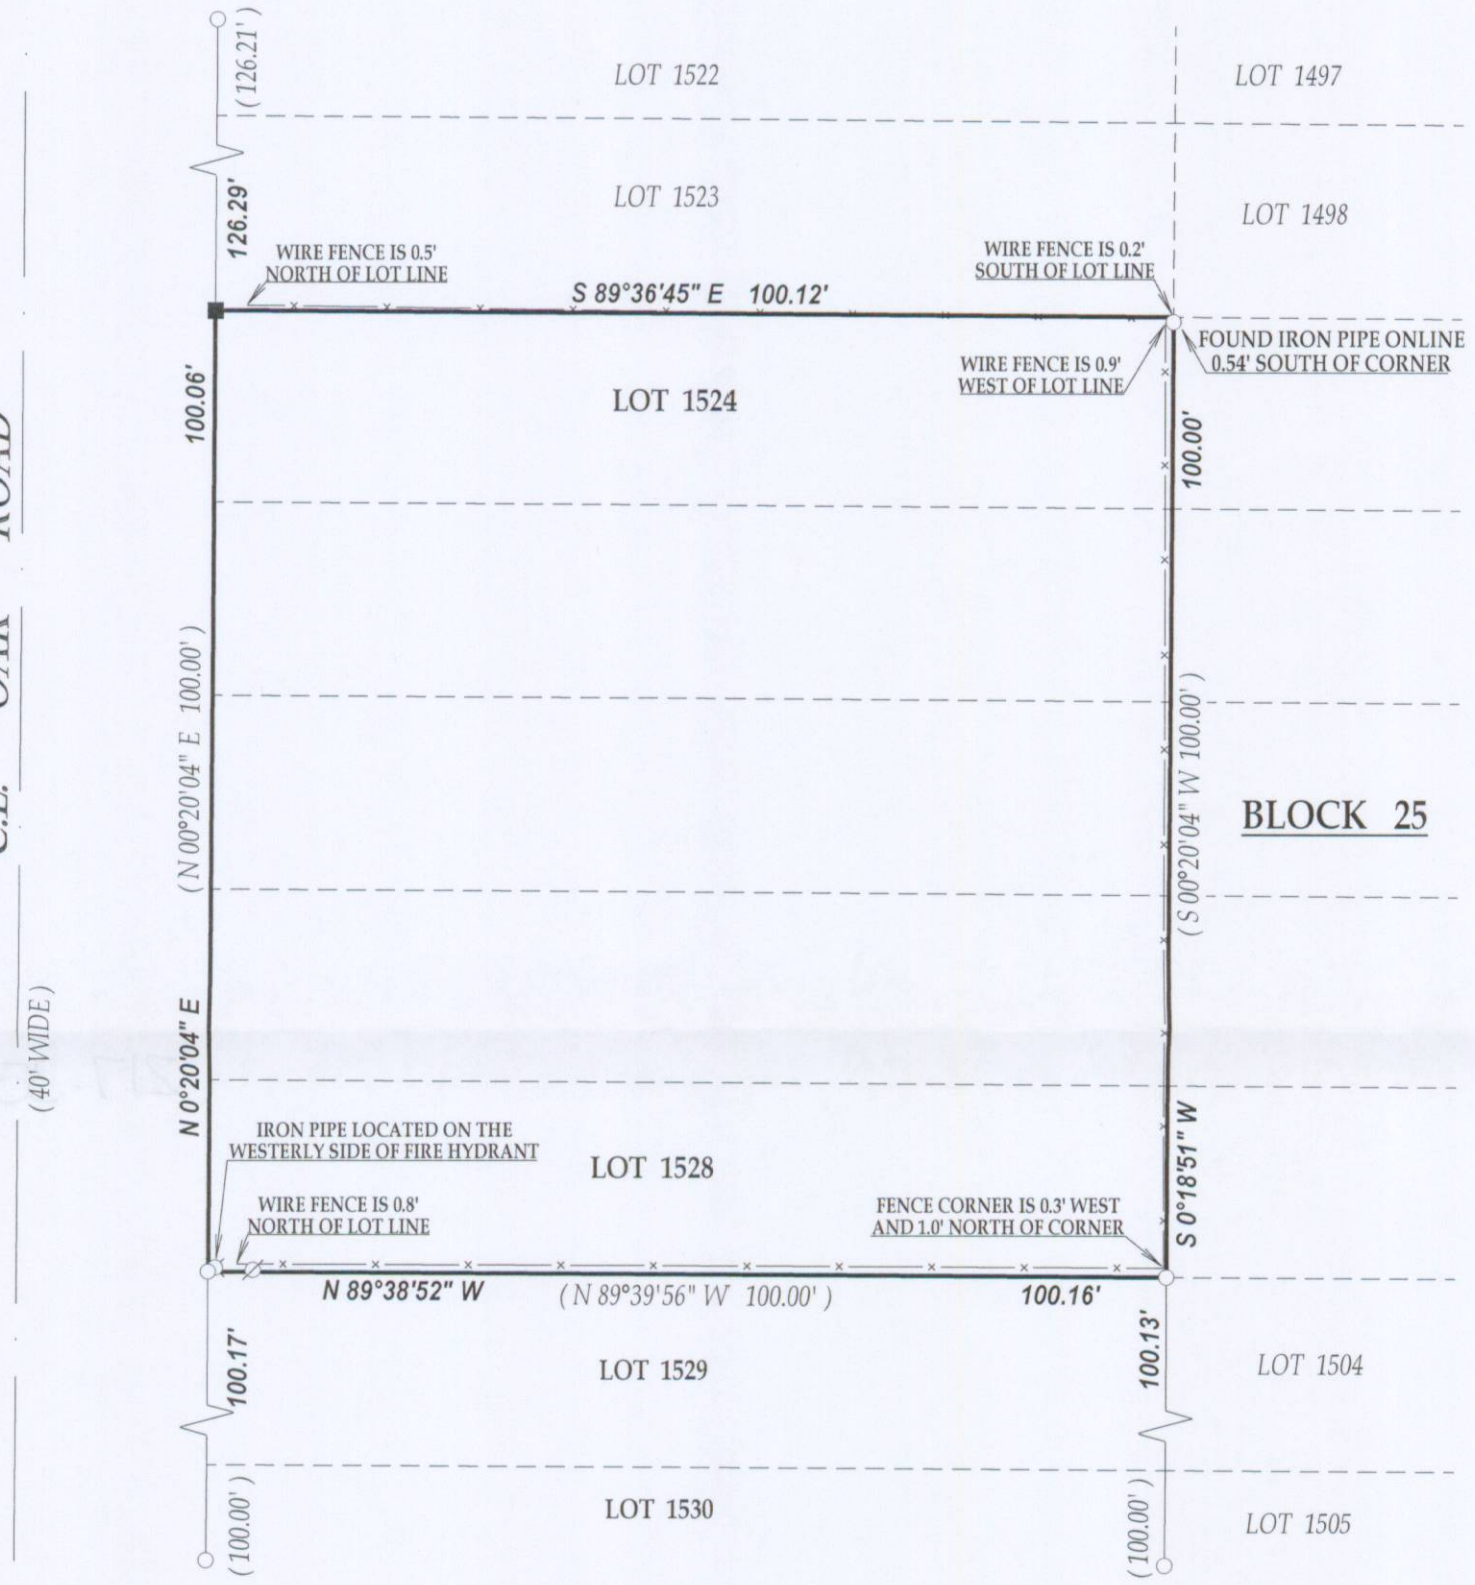

RECEIVED
NOV 10 2009
By

N
W E
S

SCALE 1" = 20'

0 20 40 60

NOTE : BASIS OF BEARINGS ARE REFRENCED TO THE PLAT OF LAKE COMO BEACH SUBDIVISION.

WISCONSIN
JOHN P.
KROTT
S-2258
LAKE GENEVA
WIS.
LAND SURVEYOR

LEGEND

- ○ FOUND IRON PIPE
- ■ SET IRON BAR
- ⌀ UTILITY POLE
- (XX) RECORDED AS

TAX ID # JLCB00232

JOB # 09-137

I have surveyed the above-described property and the above map is a true representation thereof and shows the size and location of the property, its exterior boundaries, the location and dimensions of all structures thereon, fences apparent easements and roadways and visible encroachments. if any.

This survey is made for the exclusive use of the present owners of the property, and also those who puchase, mortgage,or insure the title therto within one (1) year from date hereof; and as to them I warrant the accuracy of said survey map.

DATED THIS 30th DAY OF SEPTEMBER 2009.

JOHN KROTT S - 2258
Wisconsin Registered Land Surveyor
(original if signed in red)

217-3592