
PREPARED FOR
TINA JESSE
N 3229 EVERGREEN RD.
LAKE GENEVA WI. 53147


PLAT OF SURVEY

-OF-

LOTS 5320 THRU 5332 BLOCK 95 OF LAKE COMO BEACH SUBDIVISION,
A SUBDIVISION LOCATED IN T2N, R17E, WALWORTH COUNTY , WISCONSIN.

KROTT SURVEYING INC.
N3705 WILLOW BEND LANE
LAKE GENEVA WI. 53147
PHONE # (262)248-3697
FAX # (262)249-0639

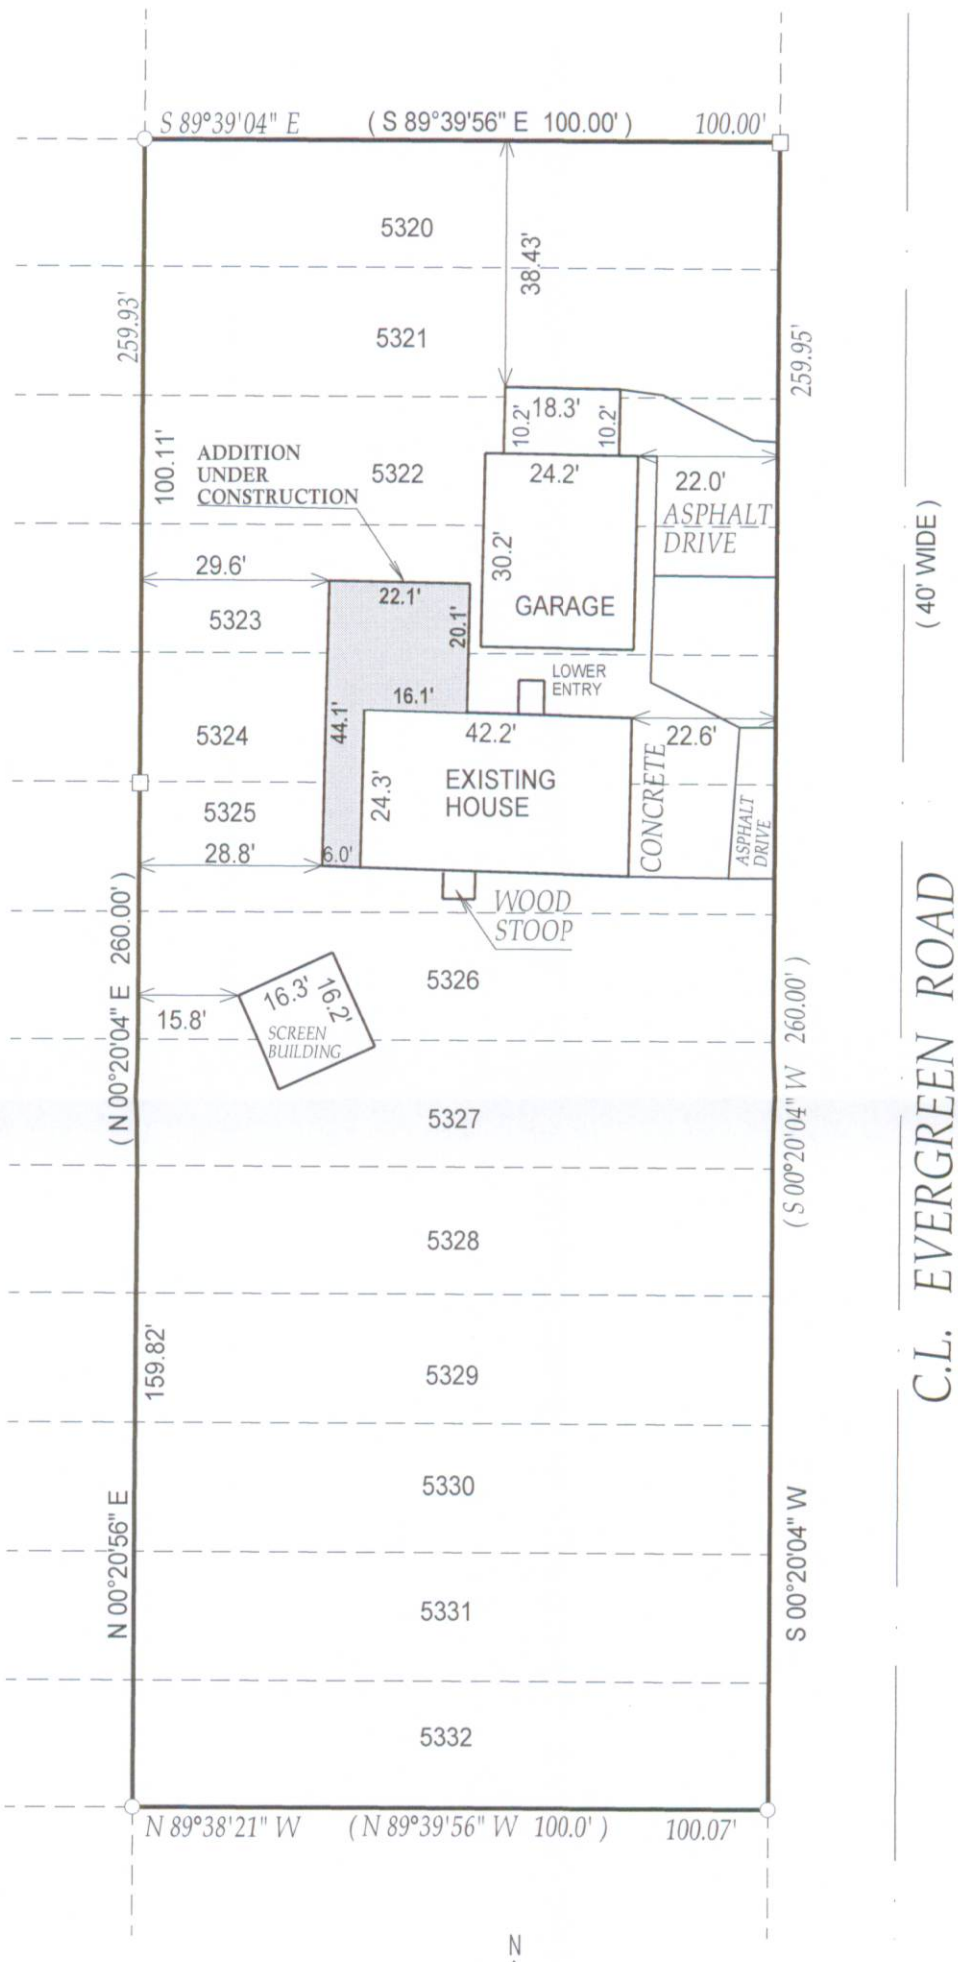

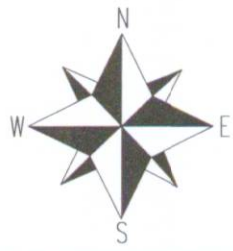

SCALE 1" = 30'

0 30 60 90 120

LEGEND

- ○ FOUND IRON PIPE
- □ FOUND IRON BAR
- (XX) RECORDED AS

TAX ID # JLCB01072
JOB # 03-320UD

I have surveyed the above-described property and the above map is a true representation thereof and shows the size and location of the property, its exterior boundaries, the location and dimensions of all structures thereon, fences apparent easements and roadways and visible encroachments. if any.

This survey is made for the exclusive use of the present owners of the property, and also those who puchase, mortgage,or insure the title therto within one (1) year from date hereof; and as to them I warrant the accuracy of said survey map.

NOTE : BEARINGS REFRENCE TO THE RECORD PLAT OF LAKE COMO BEACH

RECEIVED
DEC 23 2009
By SMF

WISCONSIN
JOHN P.
KROTT
S-2258
LAKE GENEVA
WIS.
LAND SURVEYOR

DATED THIS 7th, DAY OF DECEMBER, 2009

JOHN KROTT S - 2258
Wisconsin Registered Land Surveyor
(original if signed in red)

217-3603