
PREPARED FOR:
DALE OTTO
N3116 WILLIAMS ST.
LAKE GENEVA, WI
53147

PLAT OF SURVEY

-OF-

LOTS 11, 12,13, 14 , 61 AND 62 IN THE GUMMOW ADDITION, ACCORDING TO THE RECORDED PLAT THEREOF , A SUBDIVISION LOCATED IN THE NORTHEAST 1/4 OF SECTION 25, T.2.N. , R.17.E , WALWORTH COUNTY, WISCONSIN.

KROTT SURVEYING INC.
N3705 WILLOW BEND LANE
LAKE GENEVA WI. 53147
PHONE # (262)248-3697
FAX # (262)249-0639

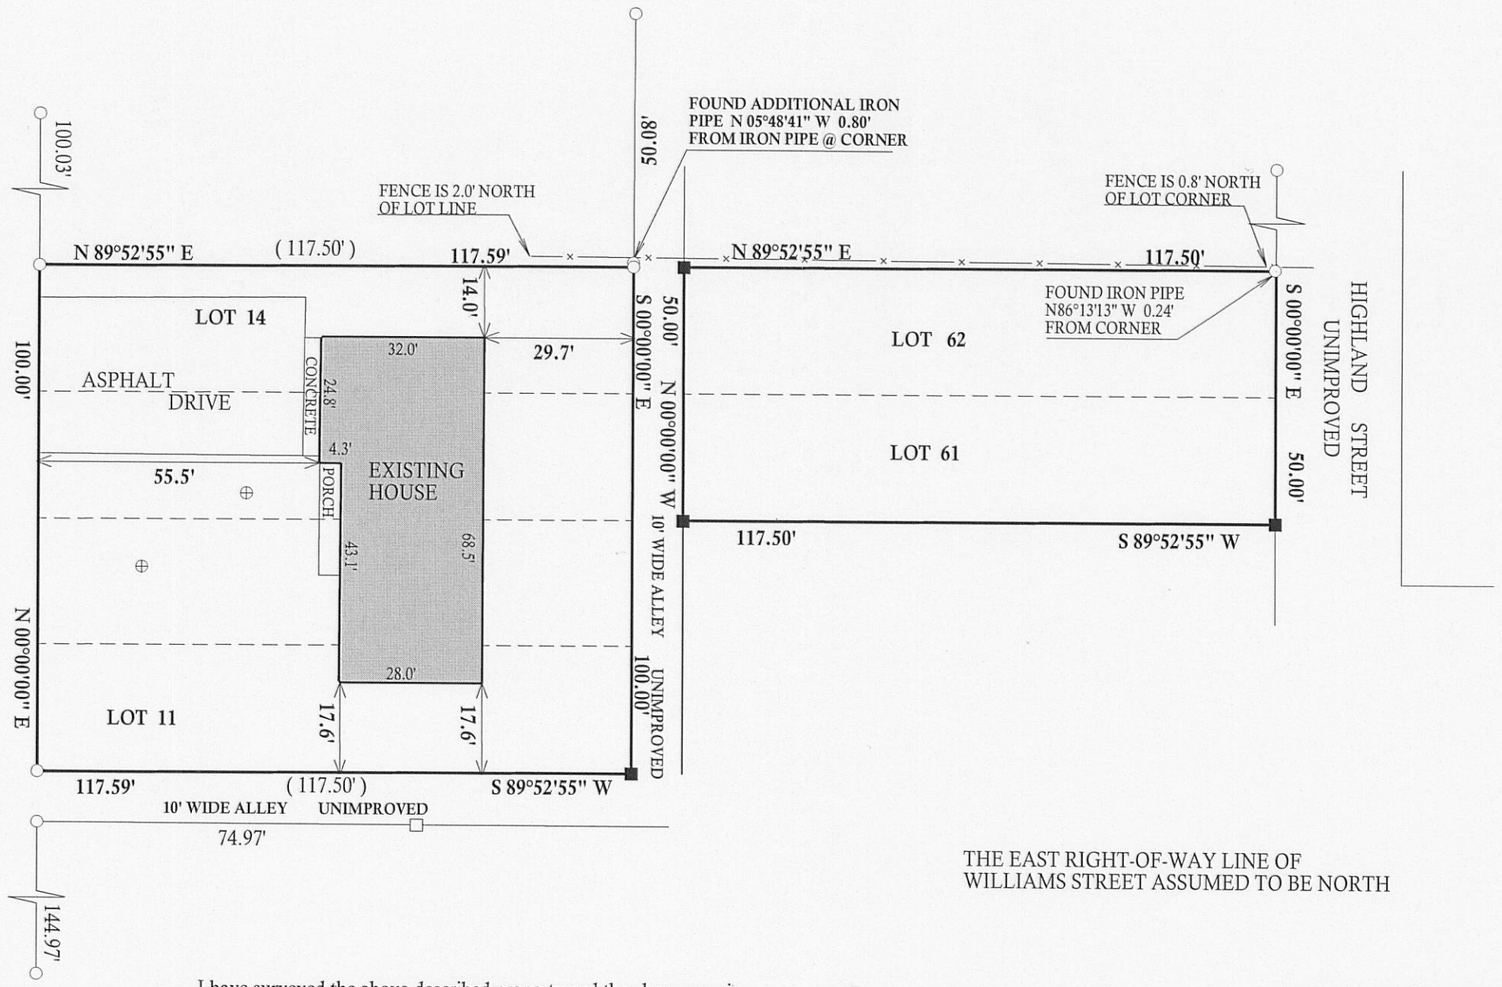

LEGEND

- ⊕ CONCRETE ACCESS COVER
- ○ FOUND IRON PIPE
- □ FOUND IRON BAR
- ■ SET IRON BAR
- (XX) RECORDED AS

JOB # 10-053

TAX ID # JGUM00005 & JGUM00014

I have surveyed the above-described property and the above map is a true representation thereof and shows the size and location of the property, its exterior boundaries, the location and dimensions of all structures thereon, fences apparent easements and roadways and visible encroachments. if any.

This survey is made for the exclusive use of the present owners of the property, and also those who puchase, mortgage,or insure the title therto within one (1) year from date hereof; and as to them I warrant the accuracy of said survey map.

THE EAST RIGHT-OF-WAY LINE OF WILLIAMS STREET ASSUMED TO BE NORTH

N W E S SCALE 1"=30'

RECEIVED
APR 08 2010
By SMF

WISCONSIN
JOHN P. KROTT
S-2258
LAKE GENEVA WIS.
LAND SURVEYOR

DATED THIS 25th, DAY OF MARCH, 2010

JOHN KROTT S - 2258
Wisconsin Registered Land Surveyor
(original if signed in red)