
PREPARED FOR
THE FERRO'S

PLAT OF SURVEY


- OF -

LOT 3 OF WALWORTH COUNTY CERTIFIED SURVEY MAP No. 2945, BEING LOCATED IN THE SE 1/4 OF THE NE 1/4 OF SECTION 33, TOWN 2 NORTH, RANGE 17 EAST OF THE FOURTH PRINCIPAL MERIDIAN, TOWN OF GENEVA, COUNTY OF WALWORTH AND STATE OF WISCONSIN.

PATHFINDER SURVEYING INC.
(formerly)
J.K. SURVEYING INC.
P.O BOX 322
LAKE GENEVA, WI. 53147
262-248-8303

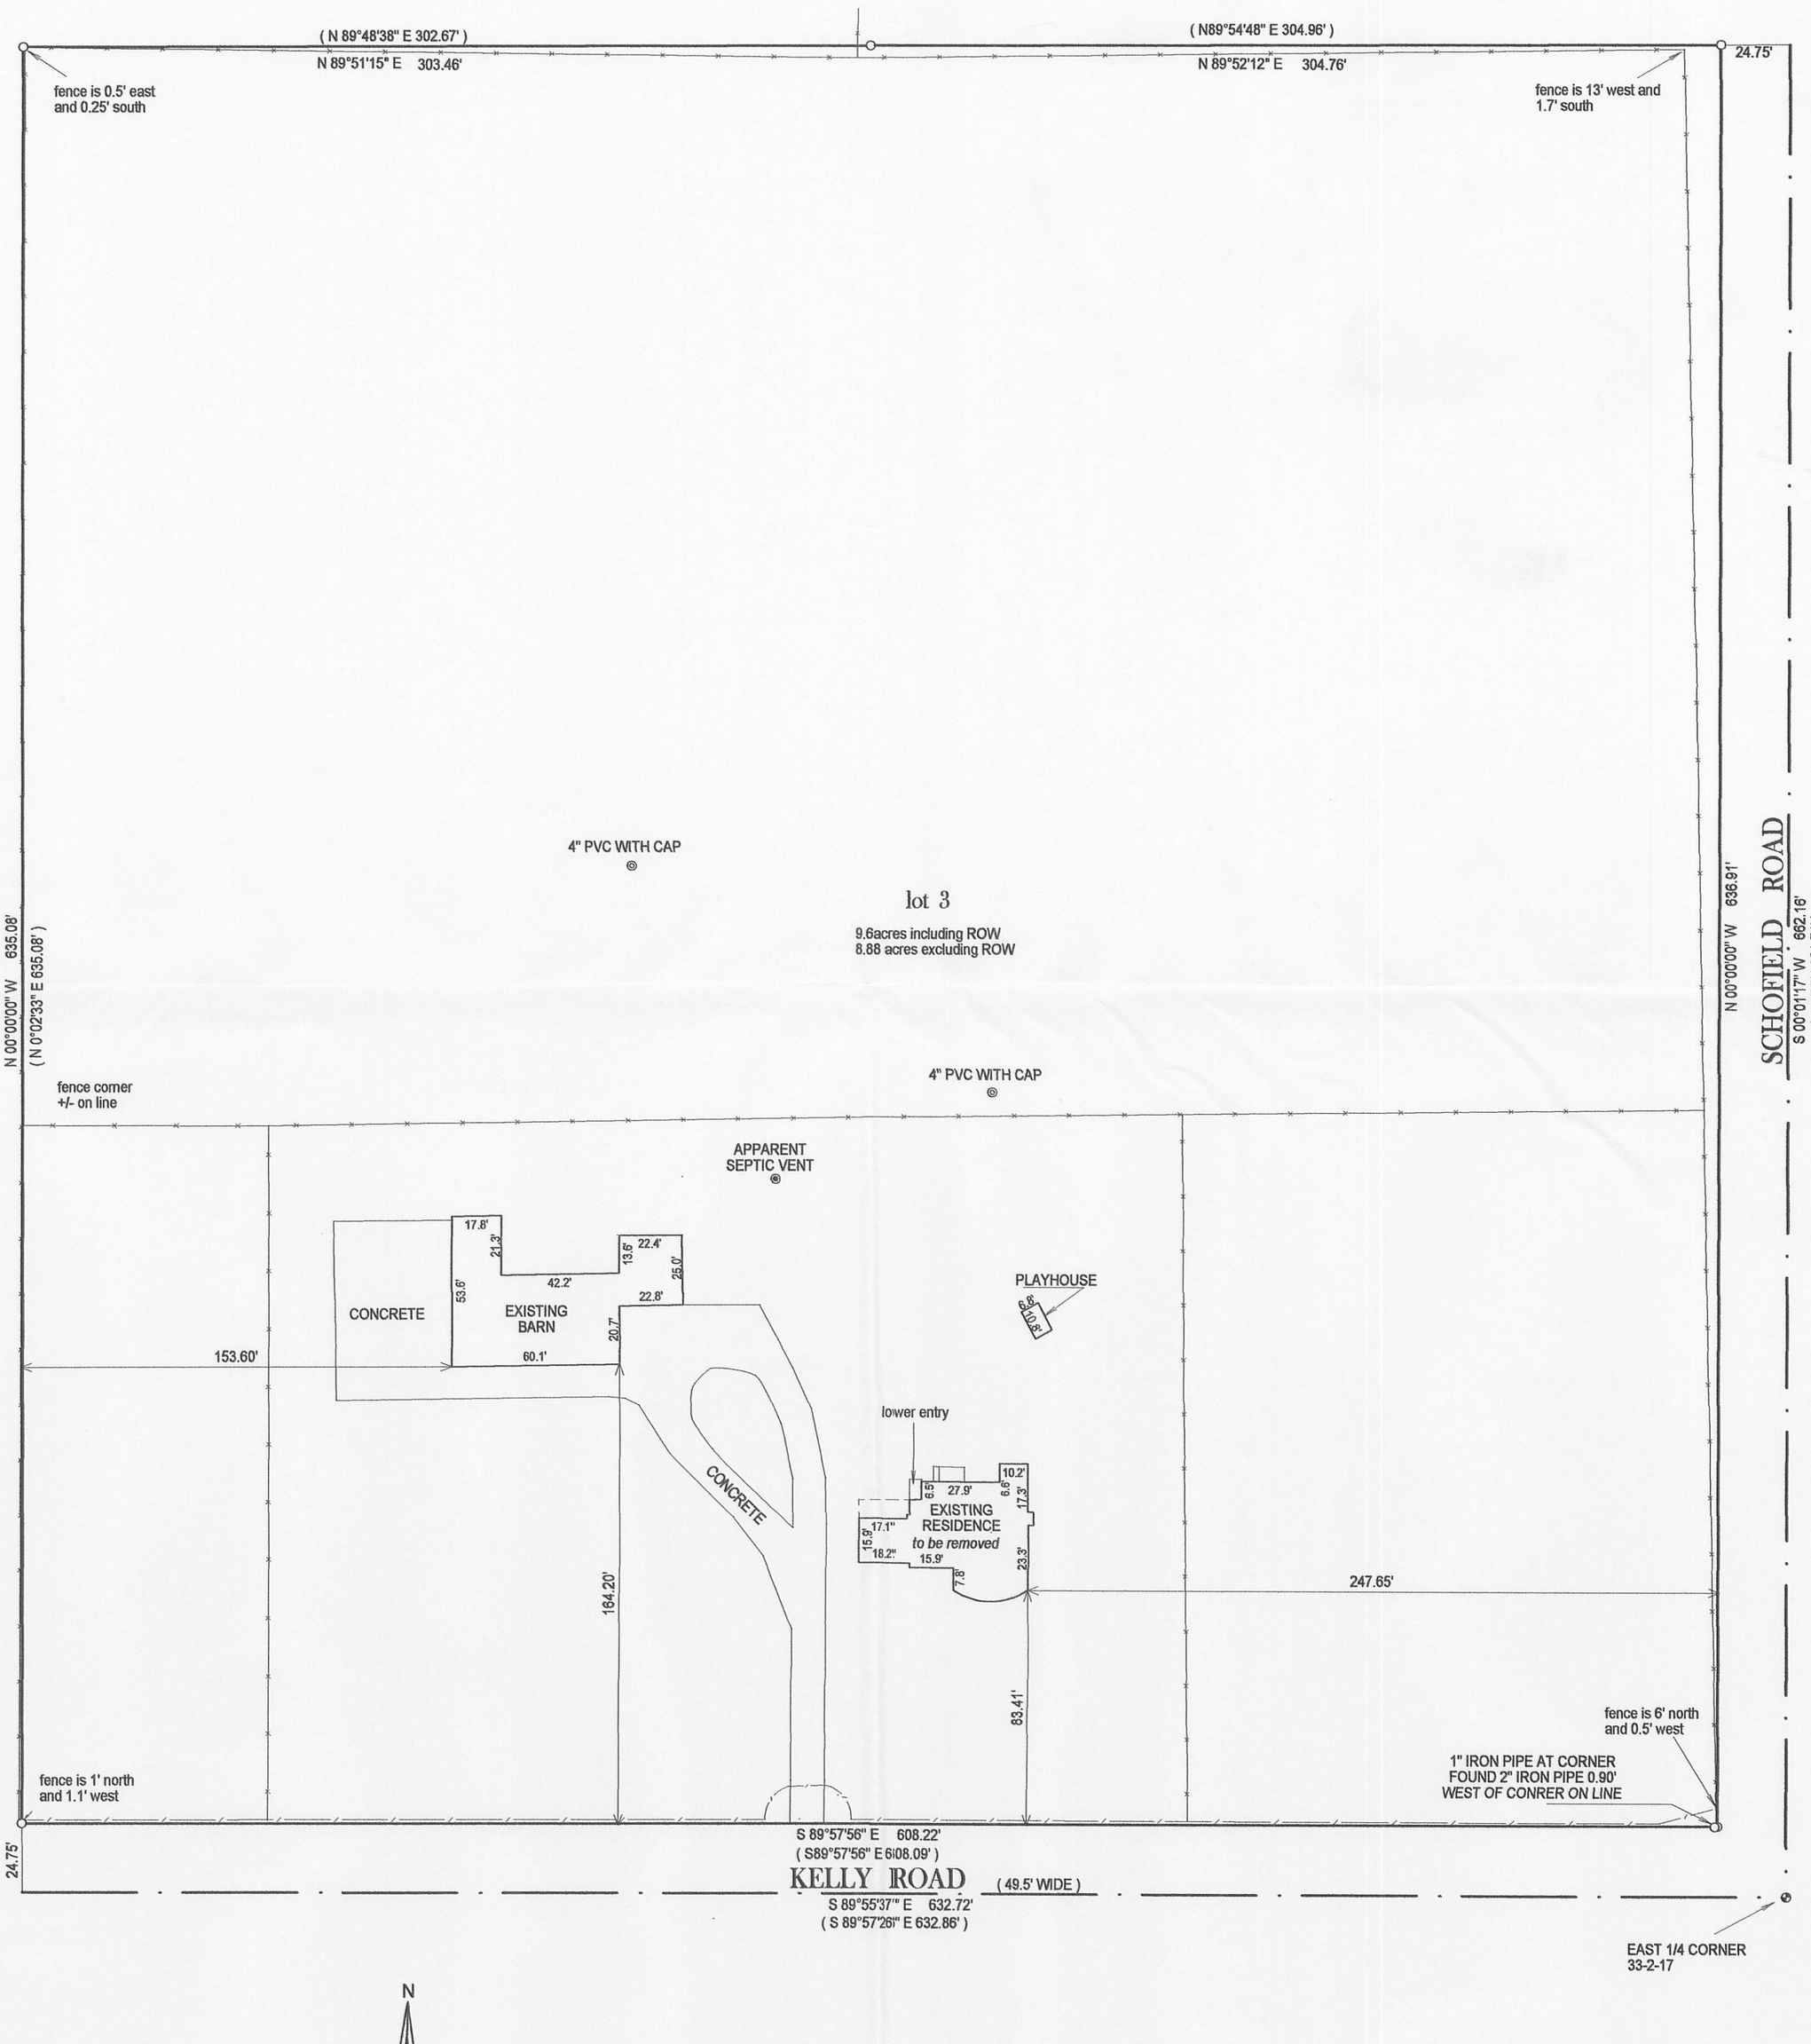

( )= recorded as
■ = set iron bar
□ = found iron bar
○ = found iron pipe
● = set iron pipe
⊕ = railroad track in concrete

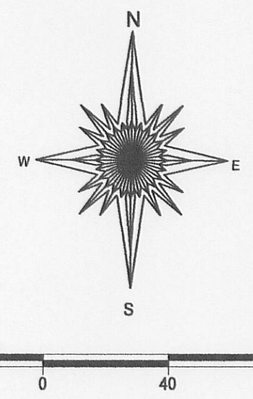

RECEIVED
AUG 20 2010
By

BASIS OF BEARING OF THIS PLAT: CERTIFIED SURVEY MAP No. 2945
THE EAST LINE OF LOT 3 WAS ASSUMED TO BEAR NORTH - SOUTH.

SCALE " = 20'

JOB # 10-93

TAX KEY # JA 294500003

"I hereby certify that I have surveyed the above described property and that the above map is a true representation of its exterior boundary and shows the size and location of all visible structures, apparent easements and encroachments if any."

This survey is made for the present owners of the property, and those who purchase, mortgage, or guarantee the title thereto, within one year from the date hereof.

DATED THIS 29th DAY OF JUNE 2010.

WISCONSIN
JEFFREY L KIMPS S-2436 LAKE GENEVA. WIS.
LAND SURVEYOR

JEFFREY L KIMPS S - 2436
Wisconsin Registered Land Surveyor
(original if signed in red)

217-3657