
PLAT OF SURVEY

-OF-

PREPARED FOR:
ANN DILLA
N3380 ELFIN PLACE
LAKE GENEVA, WI 53147

KROTT SURVEYING INC.
N3705 WILLOW BEND LANE
LAKE GENEVA WI. 53147
PHONE # (262)248-3697
FAX # (262)249-0639

LOTS 11123 THRU 11132 INCLUSIVE, BLOCK 200 LAKE COMO BEACH SUBDIVISION,
LOCATED IN T.2.N. , R.17.E. ,TOWN OF GENEVA, WALWORTH COUNTY, WISCONSIN.

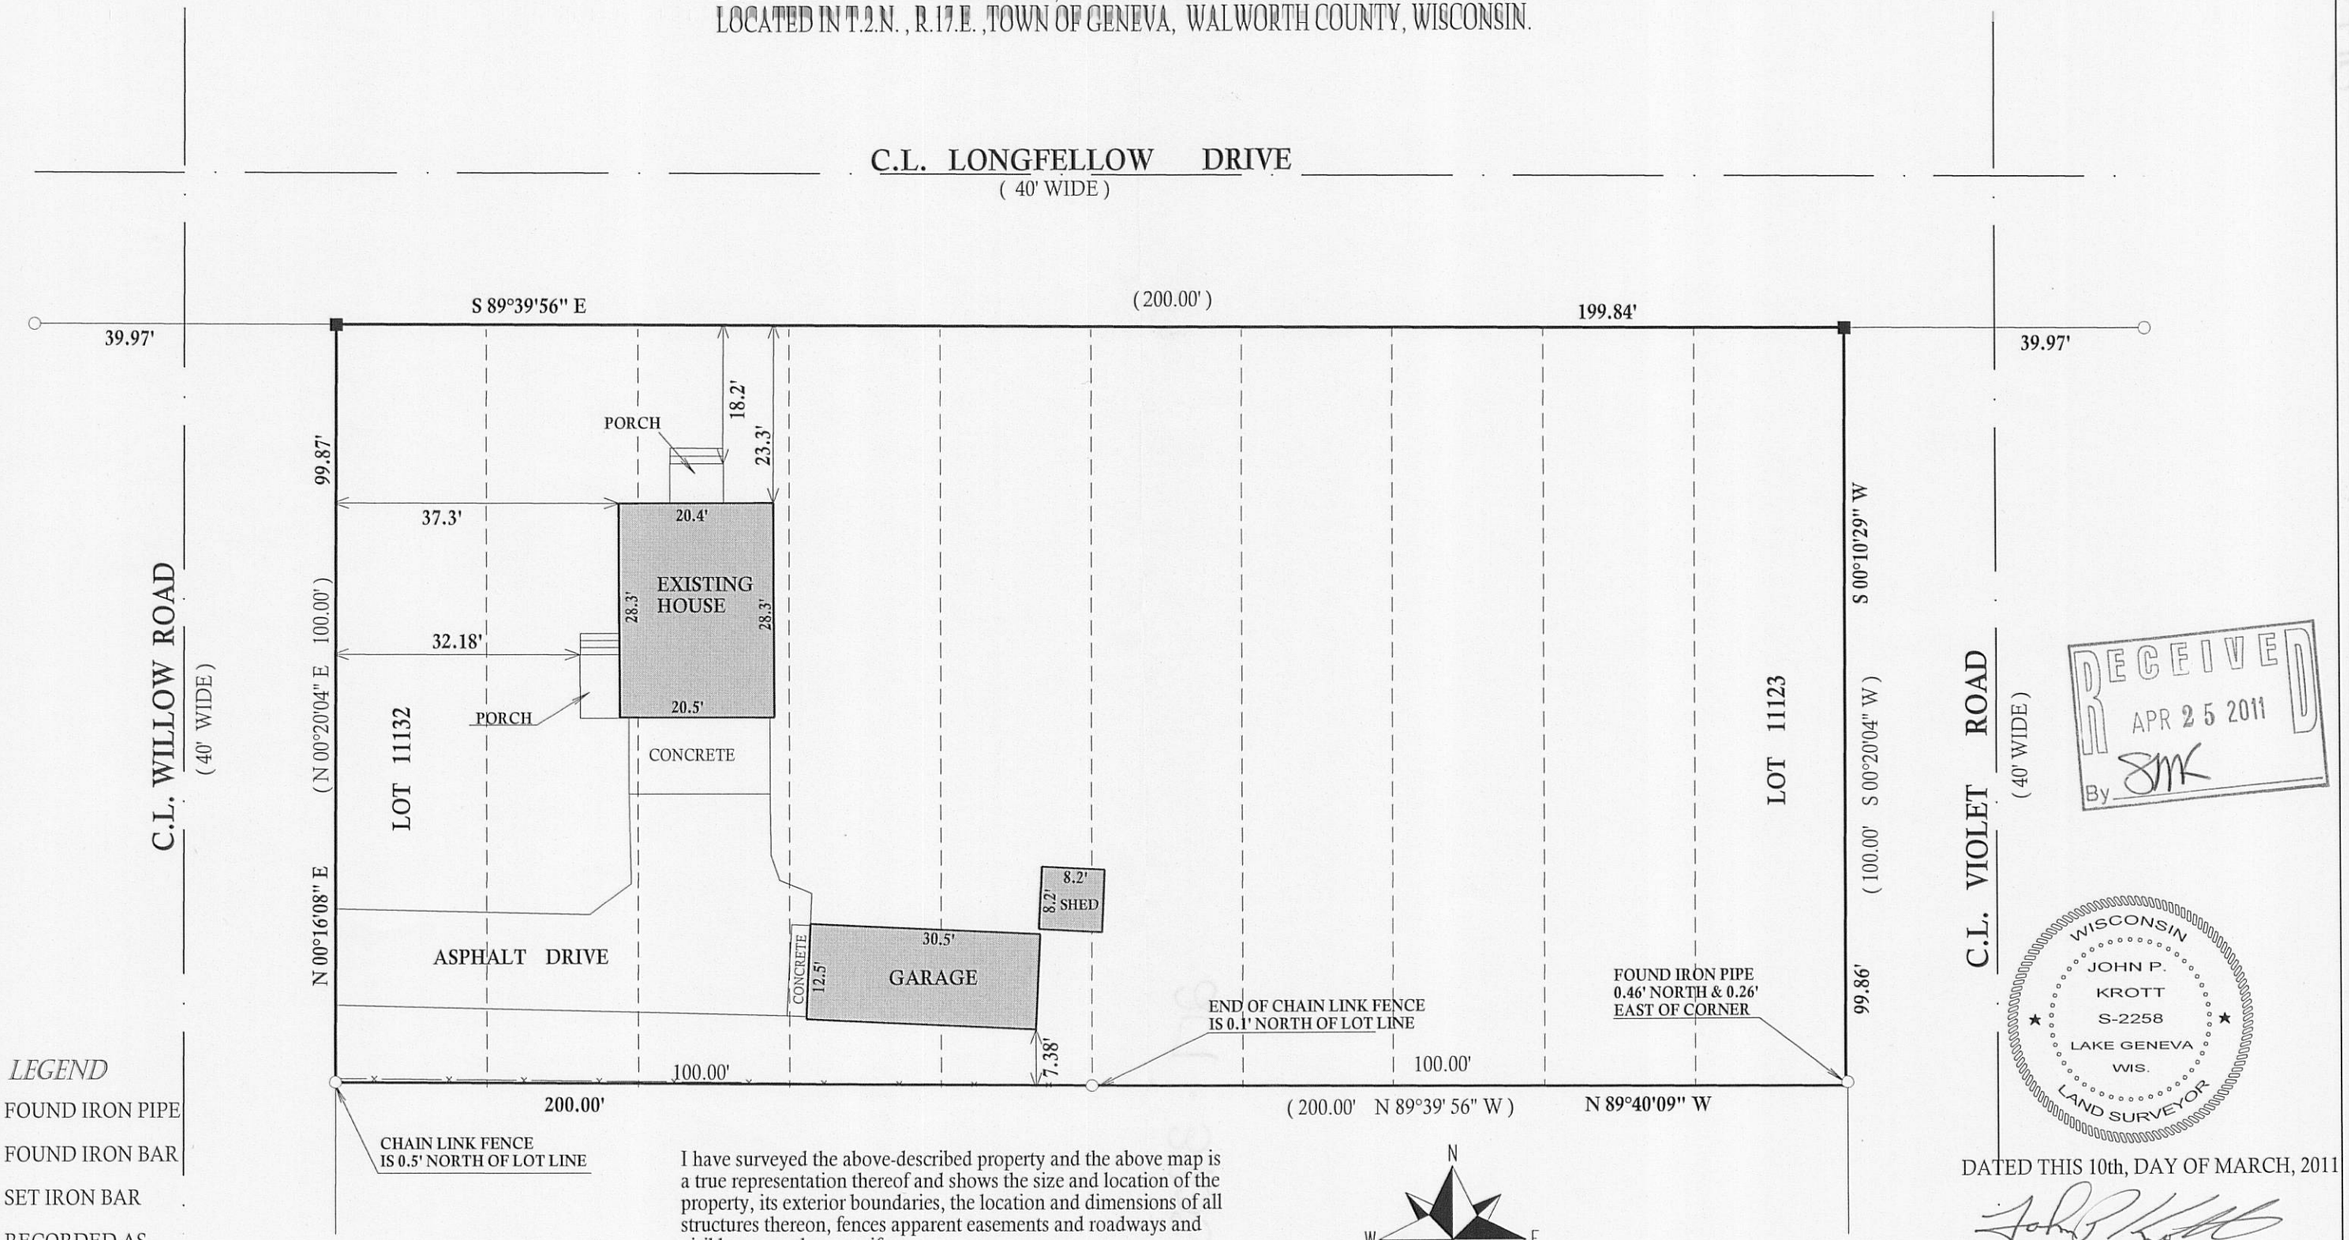

LEGEND

- ○ FOUND IRON PIPE
- □ FOUND IRON BAR
- ■ SET IRON BAR
- (XX) RECORDED AS

JOB # 11-031 TAX ID # JLCB02423

I have surveyed the above-described property and the above map is a true representation thereof and shows the size and location of the property, its exterior boundaries, the location and dimensions of all structures thereon, fences apparent easements and roadways and visible encroachments, if any.

This survey is made for the exclusive use of the present owners of the property, and also those who puchase, mortgage,or insure the title therto within one (1) year from date hereof; and as to them I warrant the accuracy of said survey map.

N W E S SCALE 1"=20'

RECEIVED
APR 25 2011
By SMK

WISCONSIN
JOHN P.
KROTT
S-2258
LAKE GENEVA
WIS.
LAND SURVEYOR

DATED THIS 10th, DAY OF MARCH, 2011

JOHN KROTT S - 2258
Wisconsin Registered Land Surveyor
(original if signed in red)