


PLAT OF SURVEY

UNIT 33-06
GENEVA NATIONAL CONDOMINIUM
NO. 33
LOCATED IN TOWN 2 NORTH, RANGE 17 EAST
WALWORTH COUNTY, WISCONSIN

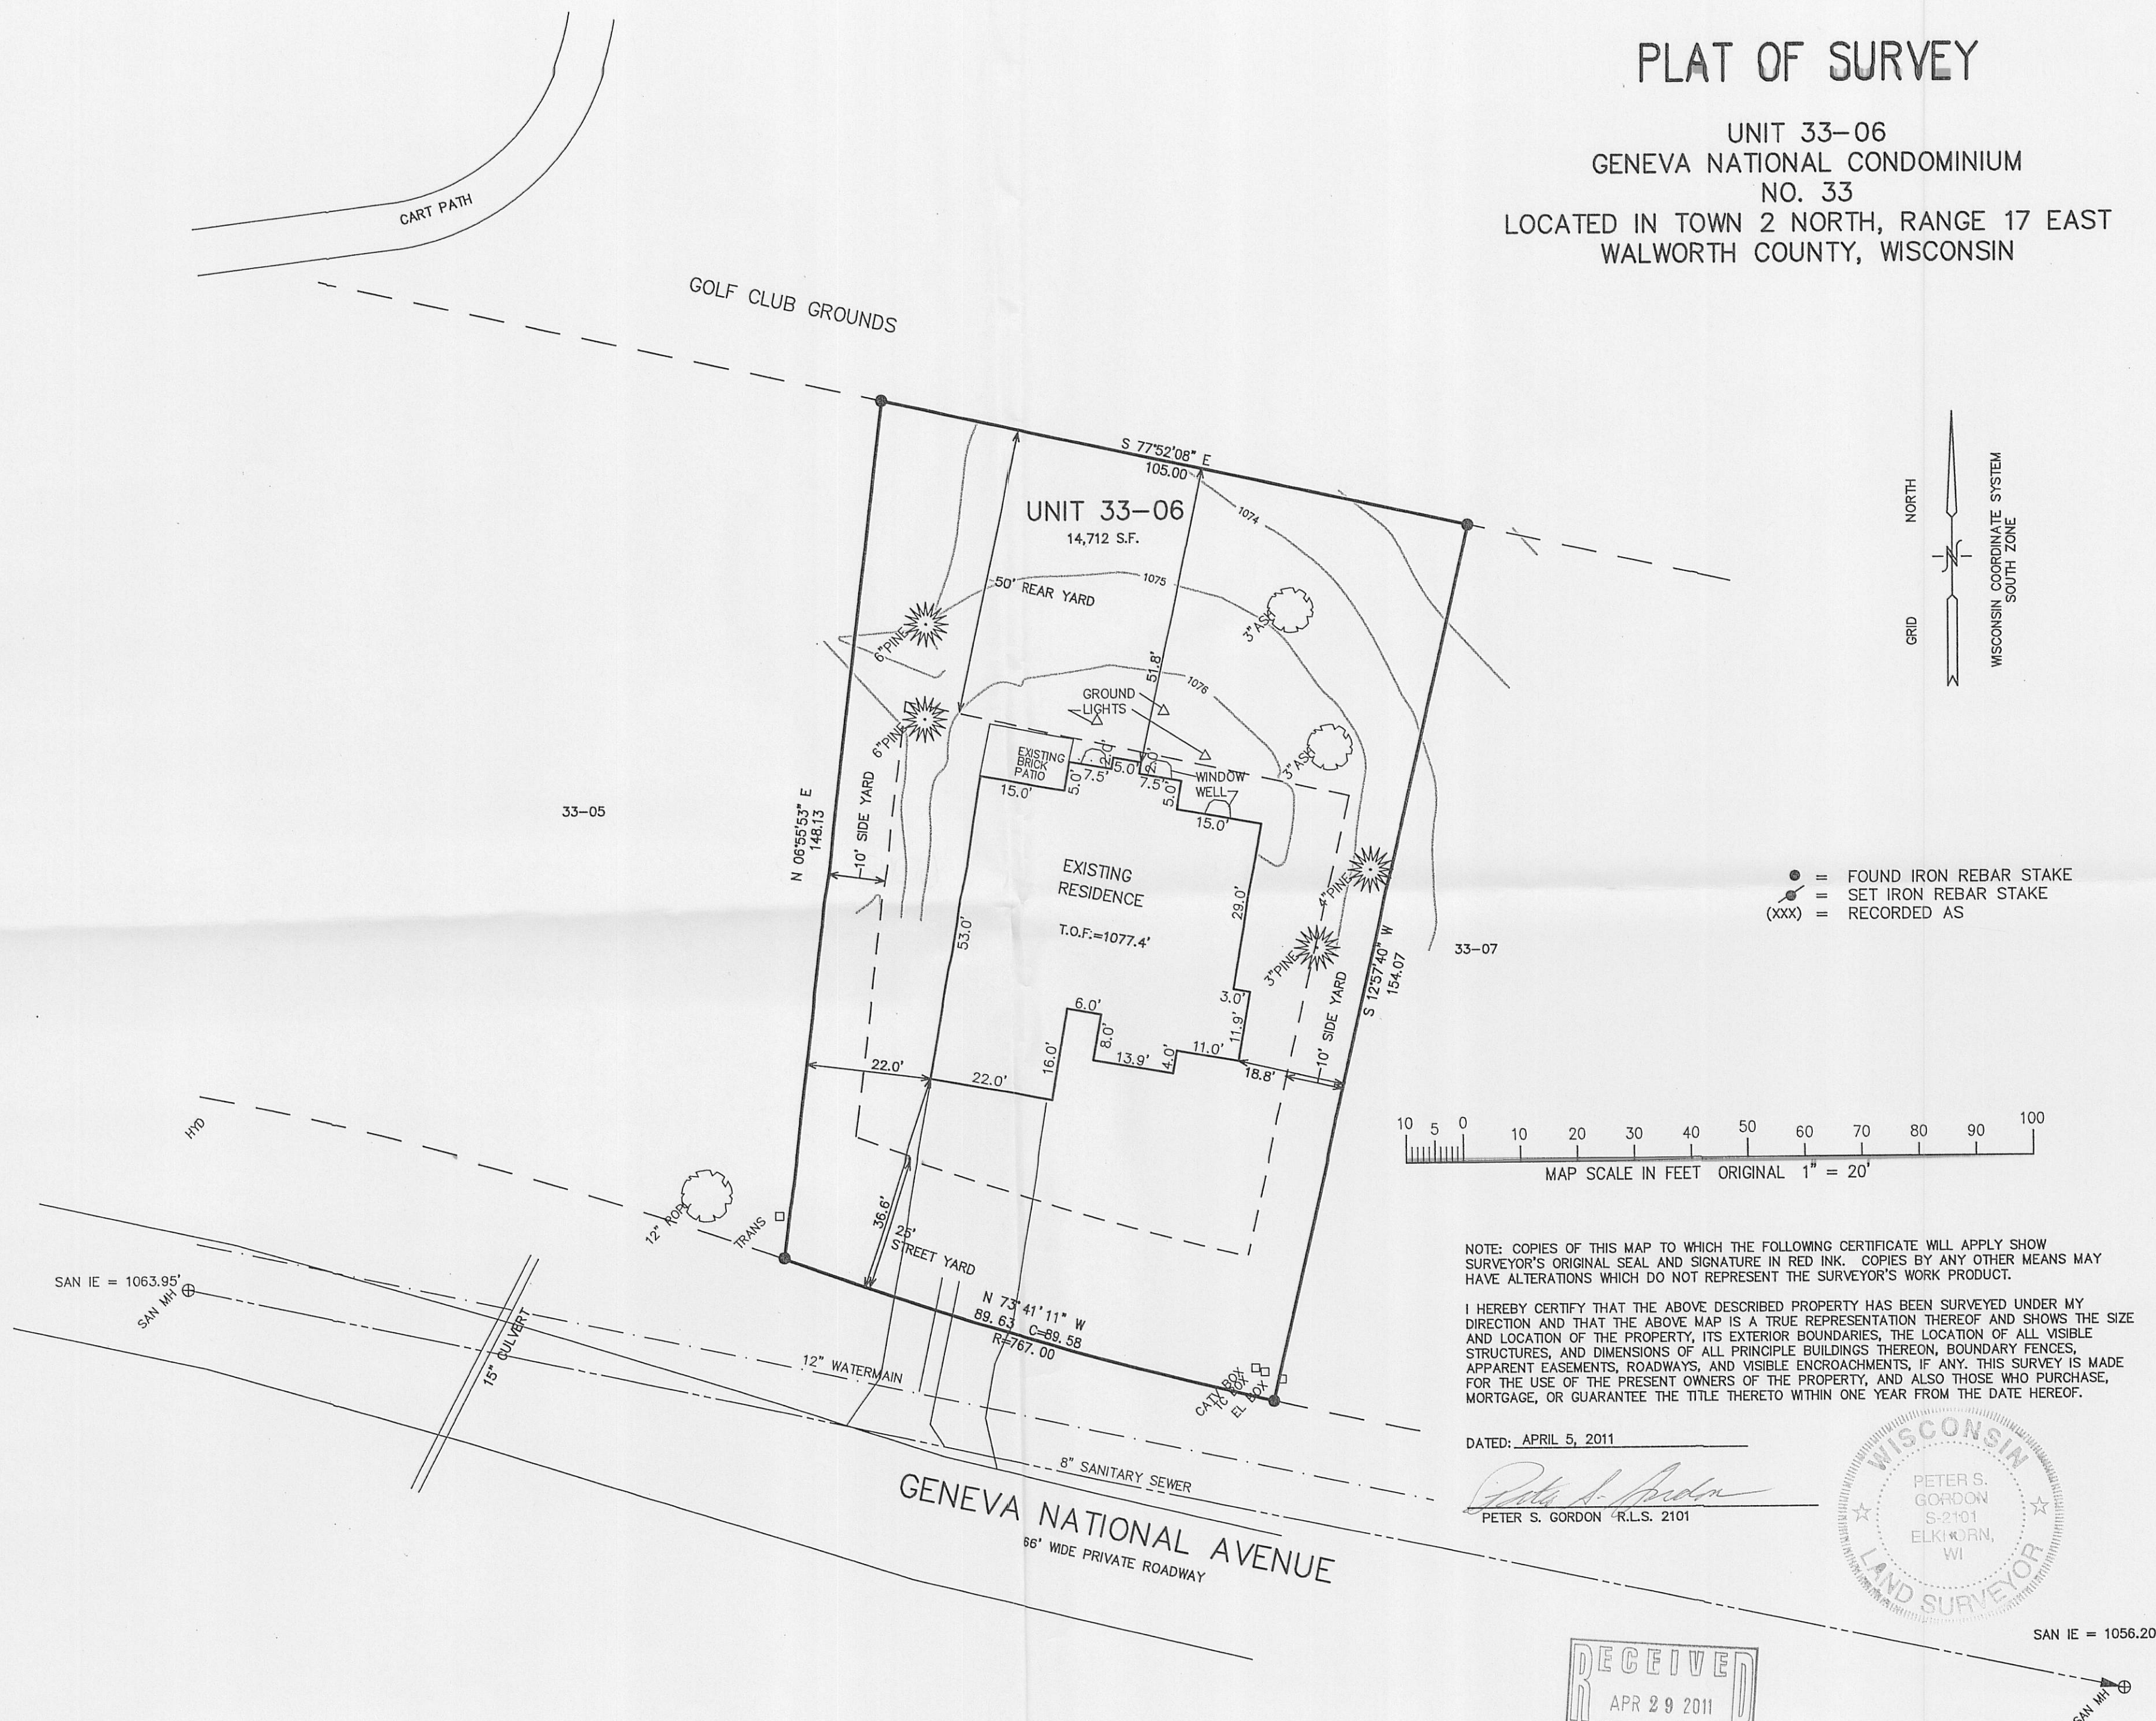

WORK ORDERED BY
JEFF LETZIER
2410 MEHRING AVENUE
JOHNSBURG, IL 60050

FARRIS, HANSEN & ASSOCIATES, INC.
Engineering, Architecture, Surveying
7 Ridgway Court P.O. Box 437
ELKHORN, WISCONSIN 53121
Office: (414) 723-2098
Fax: (414) 723-5886

REVISIONS

PROJECT NO.
3269.33-06
DATE:
05-18-04
SHEET NO.
1 OF 1

APR 05 2011