
PLAT OF SURVEY

GENEVA NATIONAL CONDOMINIUM NO. 20
UNIT 20–45

LOCATED IN PART OF THE SOUTH 1/2 OF THE NORTHWEST 1/4 & NORTH 1/2 OF THE SOUTHWEST 1/4 OF SECTION 29, TOWN 2 NORTH, RANGE 17 EAST, WALWORTH COUNTY, WISCONSIN

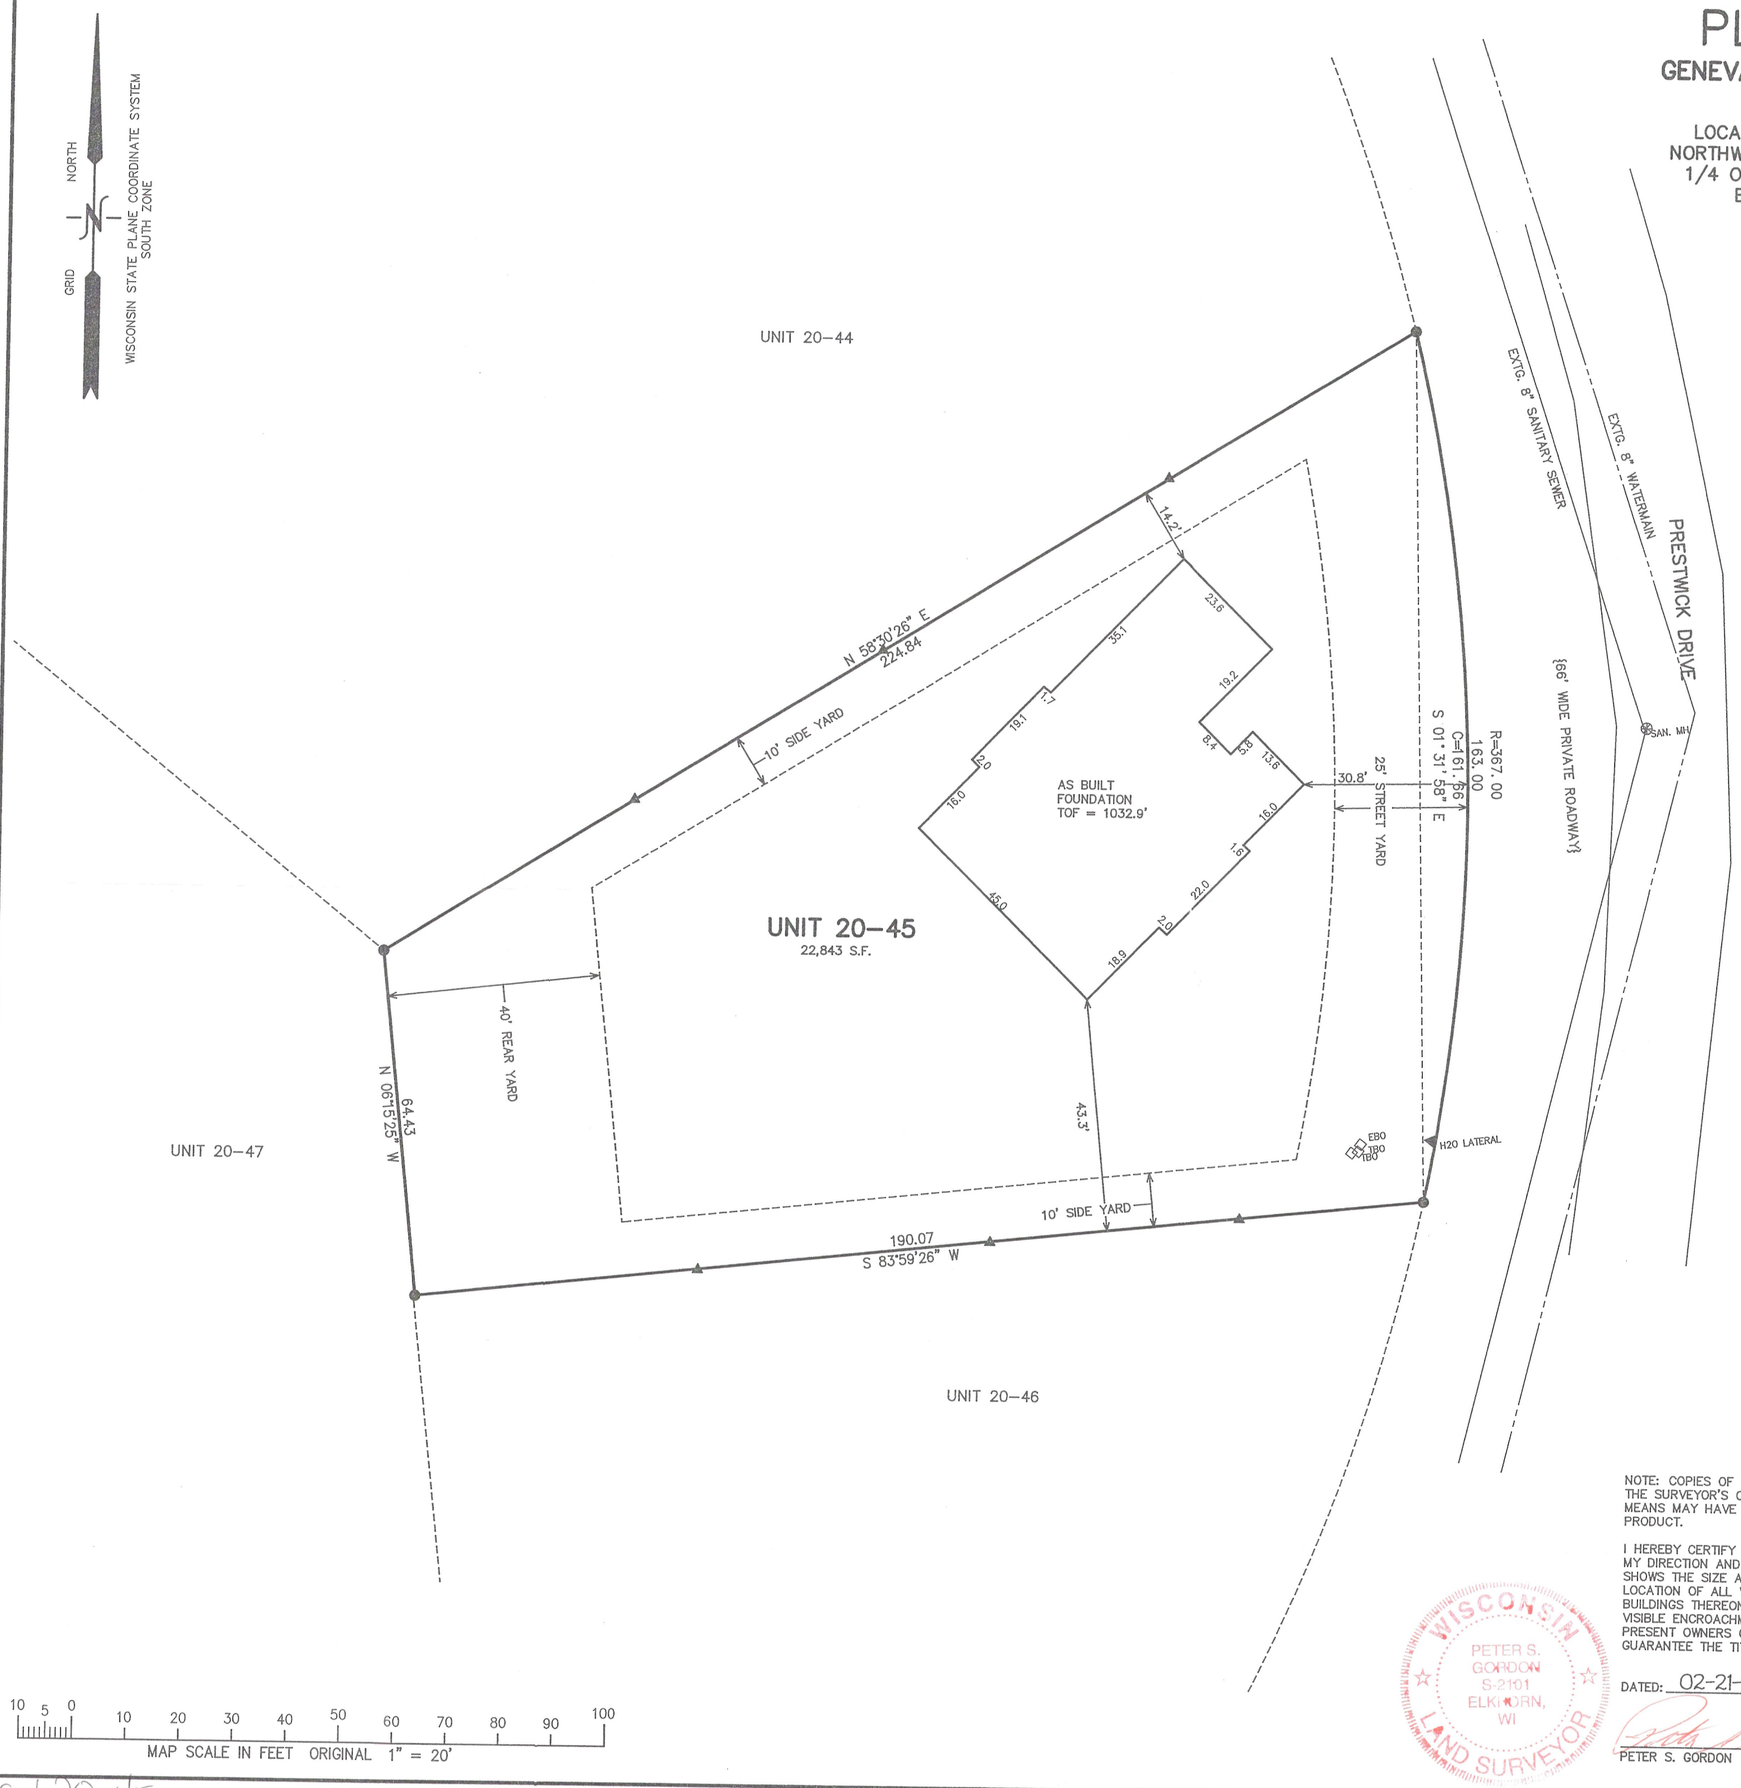

LEGEND

● = FOUND IRON REBAR STAKE

{XXX} = RECORDED AS

EBO = ELECTRIC CONTROL BOX
TBO = TELEPHONE CONTROL BOX

▲ = SET LATH ON LINE

10 5 0 10 20 30 40 50 60 70 80 90 100

MAP SCALE IN FEET ORIGINAL 1" = 20'

7/20/2012 X:\Projects\3269\CONDO_20\Unit_45\dcad\survey

RECEIVED
JUL 24 2012
By SMK

NOTE: COPIES OF THIS MAP TO WHICH THE FOLLOWING CERTIFICATE WILL APPLY SHOW THE SURVEYOR'S ORIGINAL SEAL AND SIGNATURE IN RED INK. COPIES BY ANY OTHER MEANS MAY HAVE ALTERATIONS WHICH DO NOT REPRESENT THE SURVEYOR'S WORK PRODUCT.

I HEREBY CERTIFY THAT THE ABOVE DESCRIBED PROPERTY HAS BEEN SURVEYED UNDER MY DIRECTION AND THAT THE ABOVE MAP IS A TRUE REPRESENTATION THEREOF AND SHOWS THE SIZE AND LOCATION OF THE PROPERTY, ITS EXTERIOR BOUNDARIES, THE LOCATION OF ALL VISIBLE STRUCTURES, AND DIMENSIONS OF ALL PRINCIPLE BUILDINGS THEREON, BOUNDARY FENCES, APPARENT EASEMENTS, ROADWAYS, AND VISIBLE ENCROACHMENTS, IF ANY. THIS SURVEY IS MADE FOR THE USE OF THE PRESENT OWNERS OF THE PROPERTY, AND ALSO THOSE WHO PURCHASE, MORTGAGE, OR GUARANTEE THE TITLE THERETO WITHIN ONE YEAR FROM THE DATE HEREOF.

DATED: 02-21-2012

REVISED 07-20-2012
TO SHOW SIZE & LOCATION OF AS BUILT FOUNDATION

WISCONSIN
PETER S. GORDON
S-2101
ELKHORN, WI
LAND SURVEYOR

PETER S. GORDON

JGN 20-45

217-3793

PLAT OF SURVEY
TOWN OF GENEVA, WALWORTH COUNTY, WISCONSIN

– WORK ORDERED BY –
BRIAN WAGNER
610 GENEVA NATIONAL AVENUE NORTH
LAKE GENEVA, WI. 53147

FARRIS, HANSEN & ASSOCIATES, INC.
ENGINEERING – ARCHITECTURE – SURVEYING
7 RIDGWAY COURT P.O. BOX 437
ELKHORN, WISCONSIN 53121
OFFICE: (262) 723-2098 FAX: (262) 723-5886

REVISIONS
3-1-2012
ADD TOPO

PROJECT NO.
3269.20-45

DATE:
02-21-2012

SHEET NO.
1 OF 1