


PLAT OF SURVEY

- OF -

LOTS 4586 THRU 4595, BLOCK 79 OF LAKE COMO BEACH SUBDIVISION,
LOCATED IN TOWN 2 NORTH, RANGE 17 EAST, TOWN OF GENEVA, WALWORTH
COUNTY, WISCONSIN.

PATHFINDER SURVEYING INC.
(formerly)
J.K. SURVEYING INC.
P.O BOX 322
LAKE GENEVA, WI. 53147
WWW.PATHFINDERSURVEYING.NET
262-248-8303

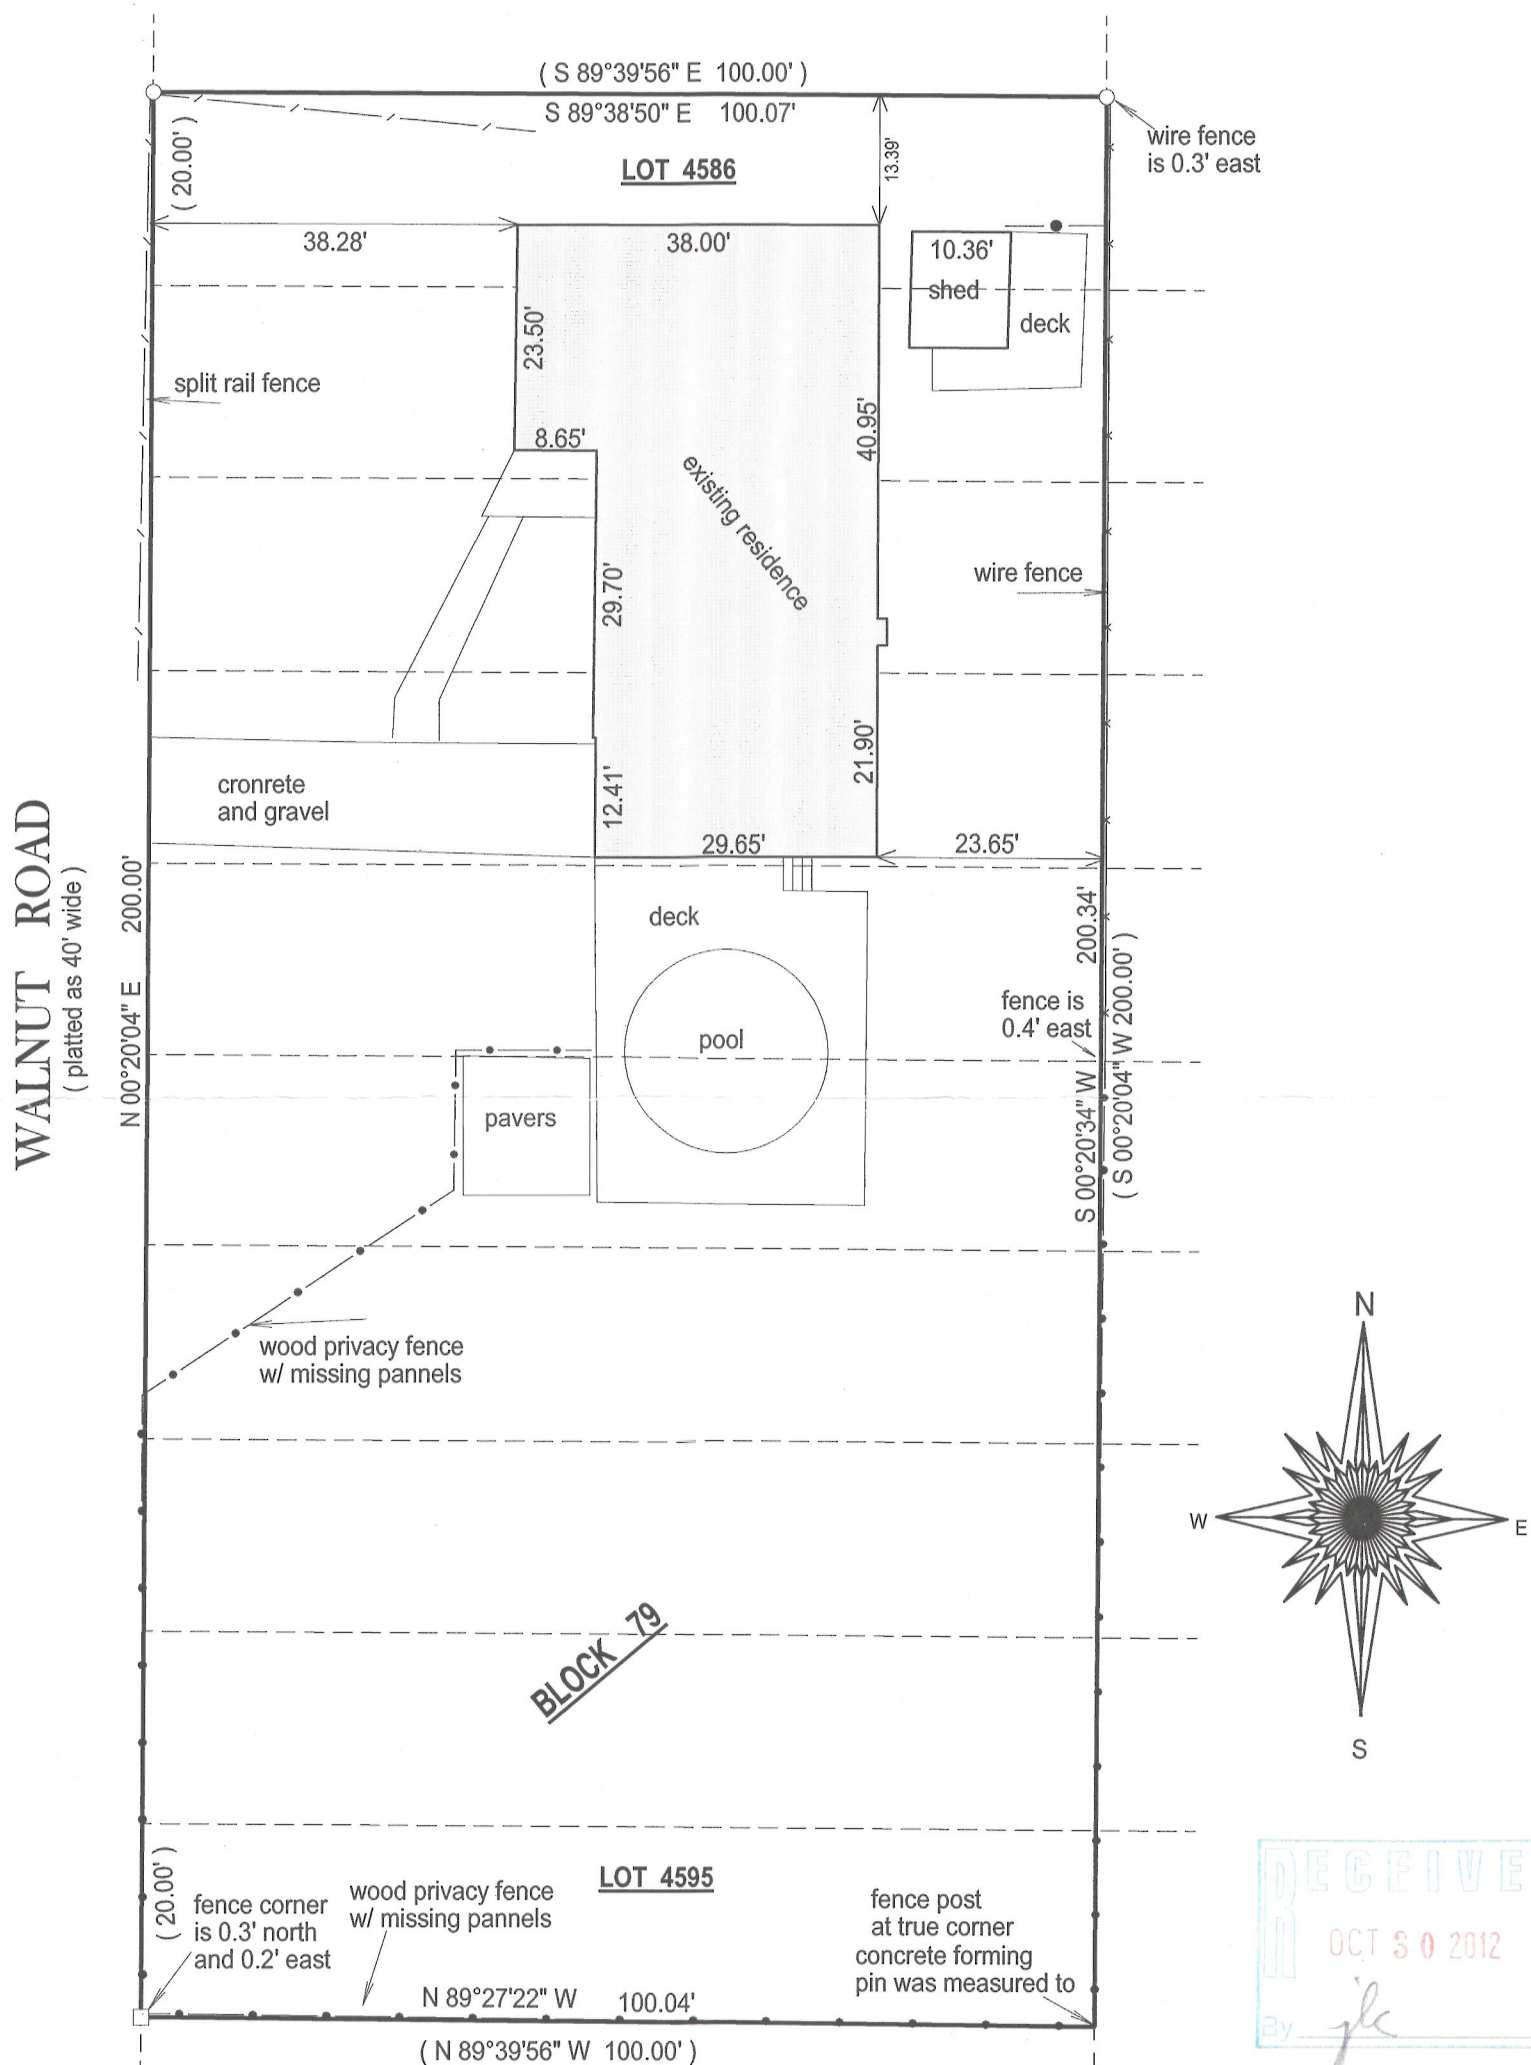


TAX ID #
JLCB 00906A

BASIS OF BEARING OF THIS PLAT: THE EAST LINE OF WALNUT ROAD WAS ASSUMED TO BEAR N00°20'04" E AS SHOWN ON THE RECORD PLAT OF LAKE COMO BEACH

"I Jeffrey L. Kimps, Wisconsin Registered Land Surveyor do hereby certify that that this survey was preformed by me and is in full compliance with chapter AE-7 of the Wisconsin Administrative Code " Minium Standards for Property Surveys" and this map is an accurate representation thereof to the best of my knowledge and belief.

This survey is made for the present owners of the property, and those who purchase, mortgage, or guarantee the title thereto, within one year from the date hereof.

DATED THIS 10TH DAY OF SEPTEMBER, 2012.

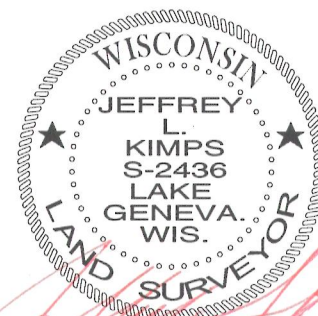

JEFFREY L KIMPS S - 2436
Wisconsin Registered Land Surveyor
(original if signed in red)

217-3822