
PREPARED FOR
JOHN BORSKIE
N 3332 LAUREL RD.
LAKE GENEVA WI. 53147

KROTT SURVEYING INC.
N3705 WILLOW BEND LANE
LAKE GENEVA WI. 53147
PHONE # (262)248-3697
FAX # (262)249-0639

PLAT OF SURVEY

-OF-

THE SOUTH 1/2 OF LOT 7888, BLOCK 134 AND LOTS 7889 THRU 7891, BLOCK 134, LAKE COMO BEACH SUBDIVISION, TOWN OF GENEVA WALWORTH COUNTY, WISCONSIN.

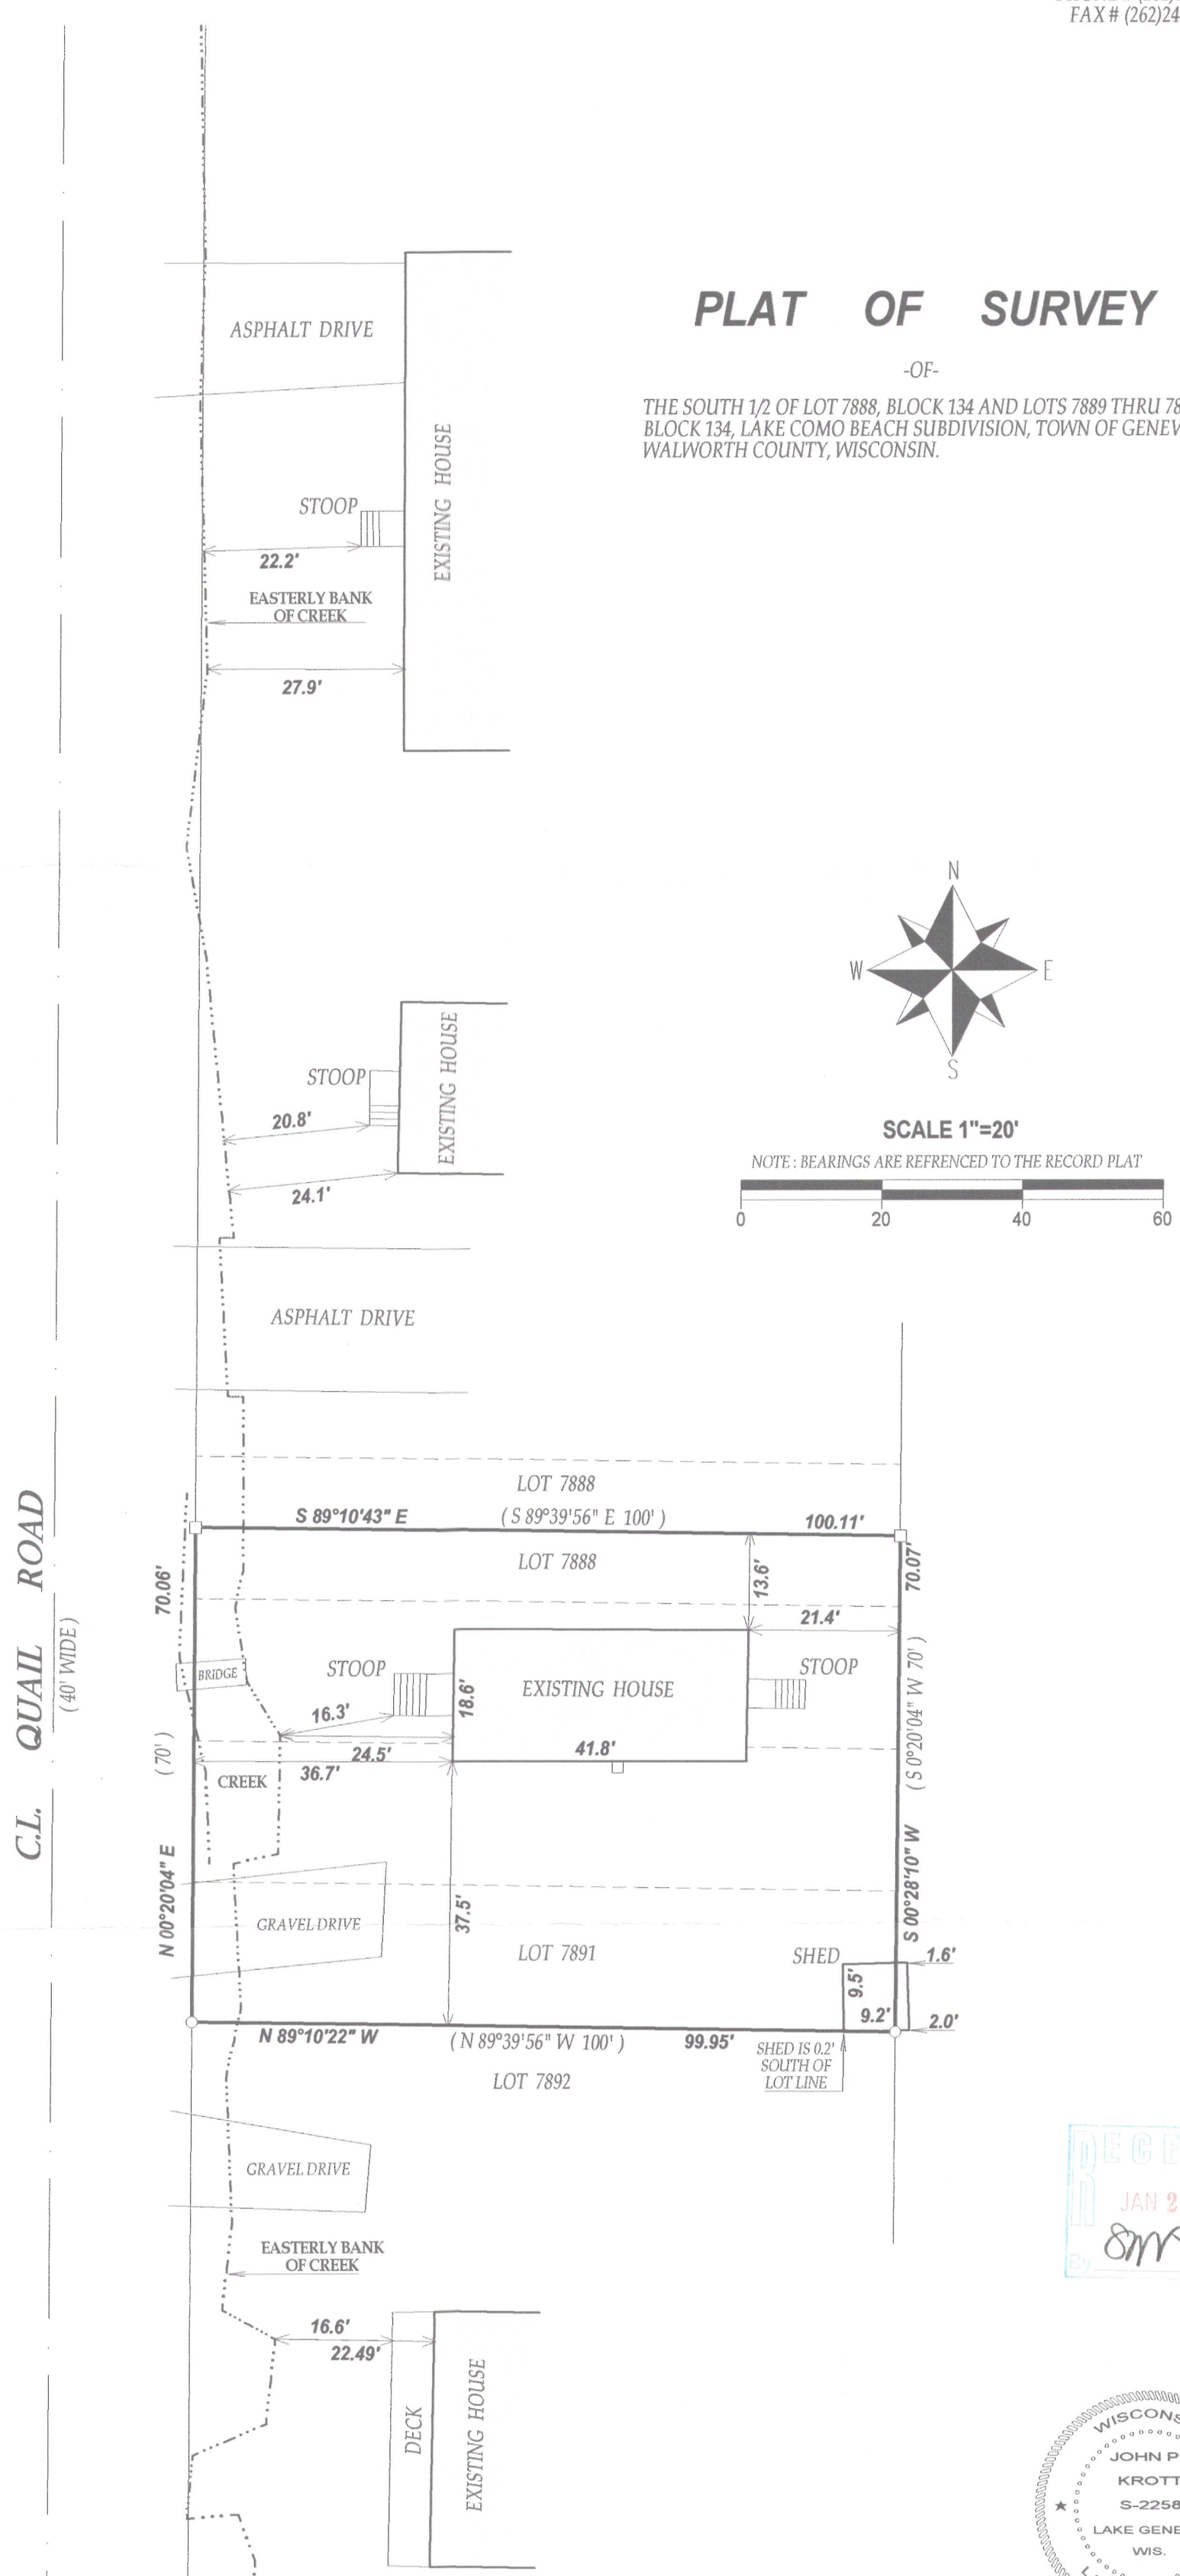

N
W E
S

SCALE 1"=20'

NOTE : BEARINGS ARE REFRENCED TO THE RECORD PLAT

0 20 40 60

RECEIVED
JAN 24 2013
By

LEGEND

○ FOUND IRON PIPE

□ FOUND IRON BAR

(XX) RECORDED AS

TAX ID # JLCB01679

JOB # 13-005

I have surveyed the above-described property and the above map is a true representation thereof and shows the size and location of the property, its exterior boundaries, the location and dimensions of all structures thereon, fences apparent easements and roadways and visible encroachments. if any.

This survey is made for the exclusive use of the present owners of the property, and also those who puchase, mortgage,or insure the title therto within one (1) year from date hereof; and as to them I warrant the accuracy of said survey map.

WISCONSIN
JOHN P.
KROTT
S-2258
LAKE GENEVA
WIS.
LAND SURVEYOR

DATED THIS 17th DAY OF JANUARY 2013

JOHN KROTT S - 2258
Wisconsin Registered Land Surveyor
(original if signed in red)

217.3848