
KROTT SURVEYING INC.
N3705 WILLOW BEND LANE
LAKE GENEVA WI. 53147
PHONE # (262)248-3697
FAX # (262)249-0639

PLAT OF SURVEY

-OF-

THE NORTH 110.57 FEET OF LOT 1, CERTIFIED SURVEY MAP NO. 1926 RECORDED IN VOLUME 9 OF CERTIFIED SURVEYS, ON PAGES 140 AND 141, AS DOCUMENT NO.192474, BEING PART OF THE NORTHWEST 1/4 OF SECTION 25, TOWNSHIP 2 NORTH, RANGE 17 EAST, IN THE TOWN OF GENEVA, WALWORTH COUNTY, WISCONSIN.

PREPARED FOR
MARK LARKIN
500 S. STONE RIDGE DR.
LAKE GENEVA WI 53147

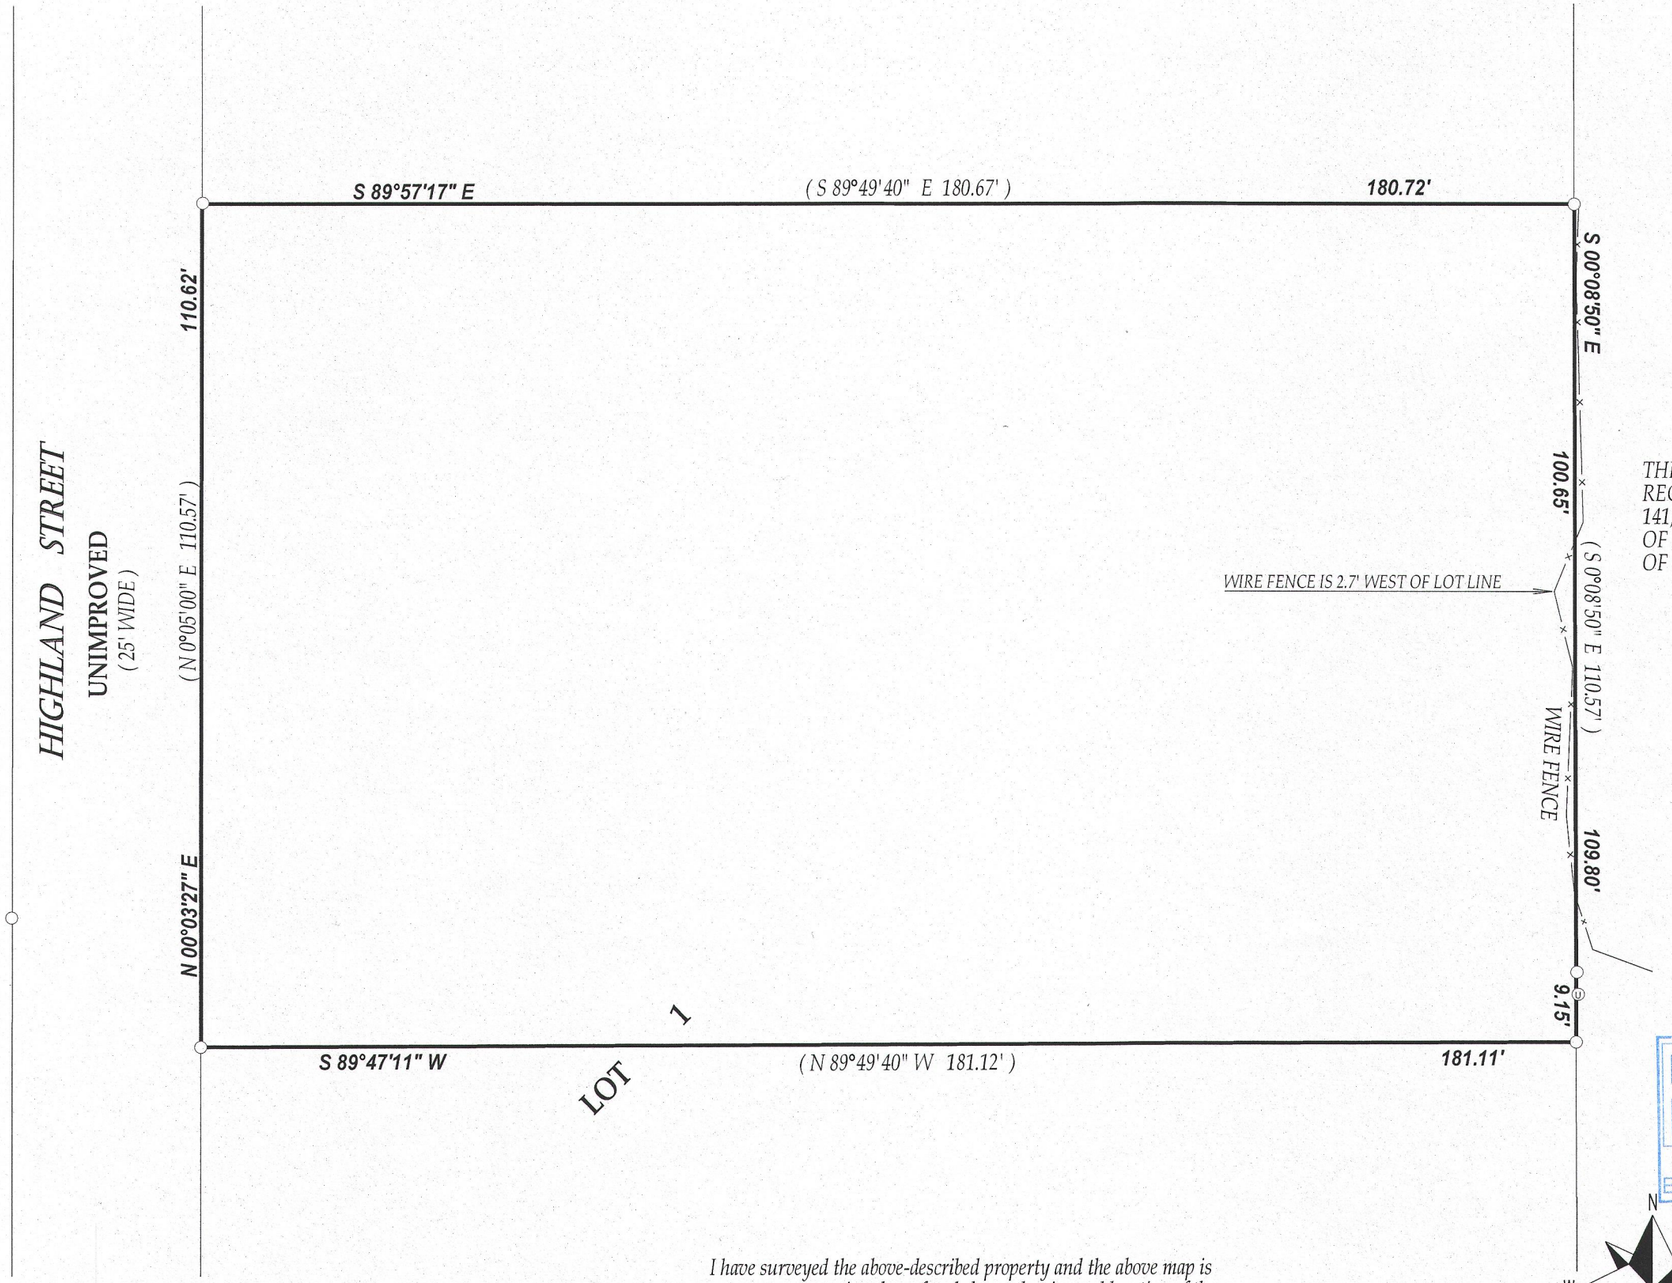

RECEIVED
JUN 27 2013
By jlc

WISCONSIN
JOHN P.
KROTT
S-2258
LAKE GENEVA
WIS.
LAND SURVEYOR

DATED THIS 4th DAY OF APRIL 2013

JOHN KROTT S - 2258
Wisconsin Registered Land Surveyor
(original if signed in red)

LEGEND

- ○ FOUND IRON PIPE
- ⓤ UTILITY PEDESTALS
- (XX) RECORDED AS

TAX ID # JA192600001

JOB # 13-041

I have surveyed the above-described property and the above map is a true representation thereof and shows the size and location of the property, its exterior boundaries, the location and dimensions of all structures thereon, fences apparent easements and roadways and visible encroachments. if any.

This survey is made for the exclusive use of the present owners of the property, and also those who puchase, mortgage,or insure the title therto within one (1) year from date hereof; and as to them I warrant the accuracy of said survey map.

N
W E
S

SCALE 1"=20'

0 20 40 60

NOTE : BEARINGS ARE REFRENCED TO C.S.M. # 1926

217-3873