PLAT OF SURVEY

- OF -

LOTS 5515 THRU 5521 AND LOTS 5558 THRU 5662 BLOCK 99 OF LAKE COMO BEACH SUBDIVISION; LOCATED IN TOWN 2 NORTH, RANGE 17 EAST, WALWORTH COUNTY, WISCONSIN

PATHFINDER SURVEYING INC.
(formerly)
J.K. SURVEYING INC.
P.O BOX 322
LAKE GENEVA, WI. 53147
WWW.PATHFINDERSURVEYING.NET
262-248-8303

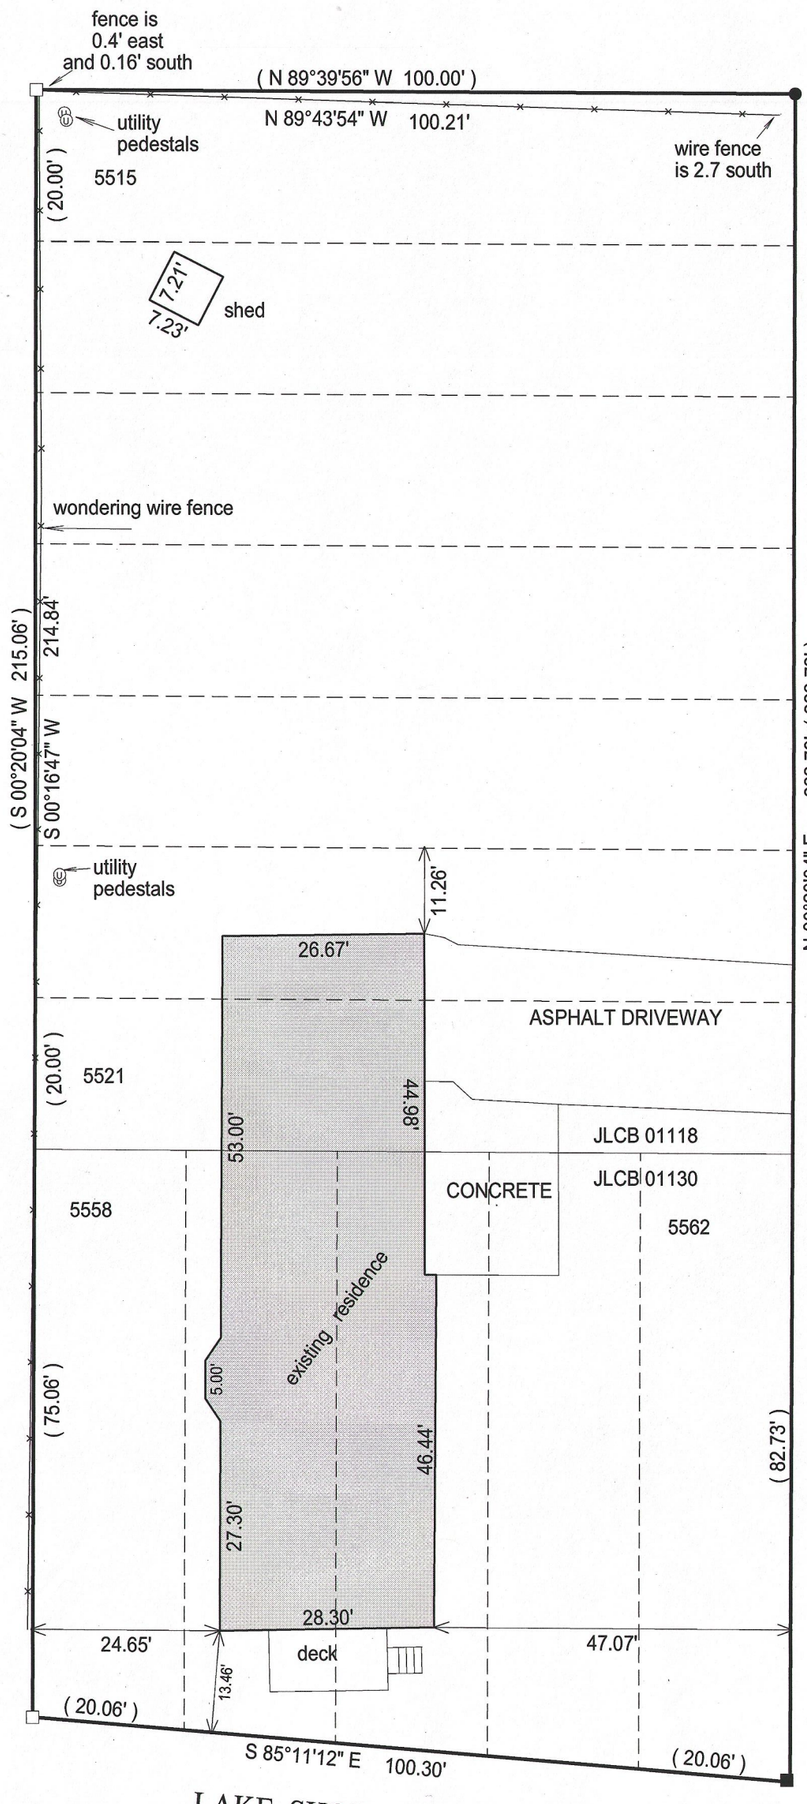

RECEIVED
JUN 28 2013
By jlc

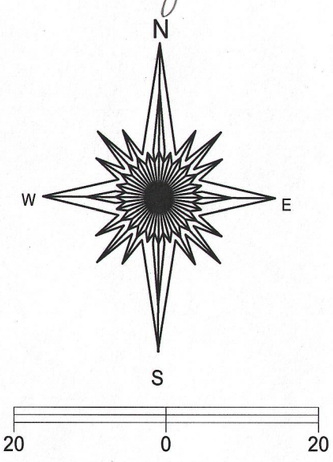

BASIS OF BEARING OF THIS PLAT: THE WEST LINE OF DAFFODIL WAS ASSUMED TO BEAR N 00°20'04"AS SHOWN ON THE RECORD PLAT OF LAKE COMO BEACH.

SET IRON BAR
0.4' WEST AND0.3' NORTH
OF CORNERLANDSCAPE BLOCK
EDGE OVER CORNER

( )= recorded as

□ = found iron bar

○ = found iron pipe

● = set iron pipe

■ = set iron bar

SCALE 1" = 20'

JOB # 13-75

TAX ID # JLCB 01130
JLCB 01118

I hereby certify that I have surveyed the above- described property and the above map is a is a true representation thereof and shows the size and location of the property, its exterior boundaries, the location and dimensions of all structures thereon, fences, apparant easements and roadways and visible encroachments if any.

This survey is made for the present owners of the property, and those who purchase, mortgage, or guarantee the title thereto, within one year from the date hereof.

DATED THIS 2nd day of June, 2013.

WISCONSIN
JEFFREY L. KIMPS S-2436 LAKE GENEVA. WIS.
LAND SURVEYOR

JEFFREY L KIMPS S - 2436
Wisconsin Registered Land Surveyor
(original if signed in red)

217-3876