PLAT OF SURVEY

LOTS 11776 THRU 11780, BLOCK 212
LAKE COMO BEACH SUBDIVISION 5th MAP
LOCATED IN THE NE 1/4 SEC. 29, T2N, R17E
WALWORTH COUNTY, WI.

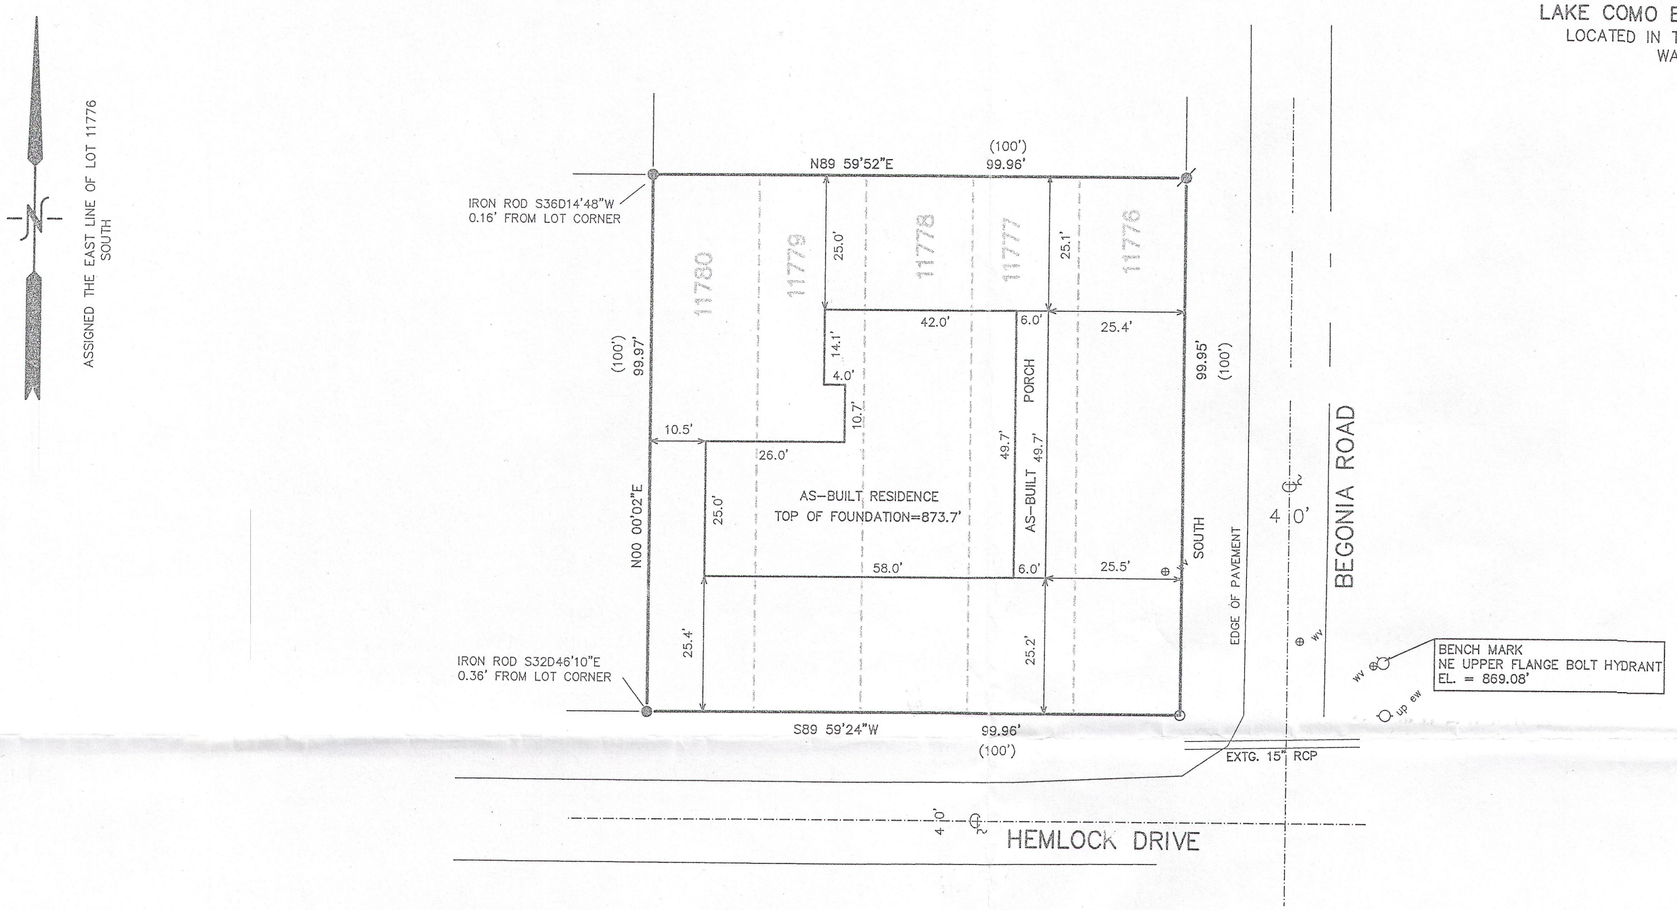

LEGEND

○ = FOUND IRON PIPE STAKE
◎ = FOUND IRON REBAR STAKE
⊘ = FOUND IRON REBAR STAKE
(XXX) = RECORDED AS

TAX PARCEL JCLB 02561
9,992 SQ. FT.

10 5 0 10 20 30 40 50 60 70 80 90 100
MAP SCALE IN FEET ORIGINAL 1" = 20'

NOTE: COPIES OF THIS MAP TO WHICH THE FOLLOWING CERTIFICATE WILL APPLY SHOW SURVEYOR'S ORIGINAL SEAL AND SIGNATURE IN RED INK. COPIES BY ANY OTHER MEANS MAY HAVE ALTERATIONS WHICH DO NOT REPRESENT THE SURVEYOR'S WORK PRODUCT.

I HEREBY CERTIFY THAT THE ABOVE DESCRIBED PROPERTY HAS BEEN SURVEYED UNDER MY DIRECTION AND THAT THE ABOVE MAP IS A TRUE REPRESENTATION THEREOF AND SHOWS THE SIZE AND LOCATION OF THE PROPERTY AND ITS EXTERIOR BOUNDARIES. THIS SURVEY IS MADE FOR THE USE OF THE PRESENT OWNERS OF THE PROPERTY, AND ALSO THOSE WHO PURCHASE, MORTGAGE, OR GUARANTEE THE TITLE THERETO WITHIN ONE YEAR FROM THE DATE HEREOF.

DATED: MAY 18, 2011

PETER S. GORDON R.L.S. 2101

REVISED 7/11/2013-KB
TO SHOW SIZE & LOCATION
OF AS-BUILT RESIDENCE

REVISED 02-20-2013
TO SHOW SIZE & LOCATION OF
PROPOSED RESIDENCE

REVISED 4/22/2013-KB
TO RAISE RESIDENCE 0.3'

REVISED 4/23/2013-KB
TO REMOVE RETAINMENT WALL

REVISED 5/1/2013-KB
TO ADD RETAINMENT WALL

REVISED 5/22/2013-KB
ADD DRIVEWAY NOTE &
VISION TRIANGLE &
MOVE BACK RETAINMENT
WALL

REVISED 5/29/2013-KB
ADJUST G.E. & DRIVE
GRADES

RECEIVED
JUL 23 2013
By

WISCONSIN
PETER S.
GORDON
S-2101
ELKHORN,
WI
LAND SURVEYOR

ORDERED BY: WILLIAM POULOS
1118 WEST LILL AVE
CHICAGO, IL. 60616

FARRIS, HANSEN & ASSOCIATES, INC.
ENGINEERING – ARCHITECTURE – SURVEYING
7 RIDGWAY COURT P.O. BOX 437
ELKHORN, WISCONSIN 53121
OFFICE: (262) 723-2098 FAX: (262) 723-5886

REVISIONS

PROJECT NO. 8357.13
DATE: 4/19/2013
SHEET NO. 1 OF 1

7/11/2013 X:\Projects\8357\Dcad\ASBUILT

JUL 11 2013

JLCB 02561

217-3884