
PREPARED FOR
BASSO BUILDERS
405 SKYLINE DR.
LAKE GENEVA WI. 53147

PLAT OF SURVEY

-OF-

LOTS 4061 THRU 4065 BLOCK 70 LAKE COMO BEACH SUBDIVISION LOCATED IN TOWN 2 NORTH, RANGE 17 EAST, WALWORTH COUNTY, WISCONSIN.

KROTT SURVEYING INC.
N3705 WILLOW BEND LANE
LAKE GENEVA WI. 53147
PHONE # (262)248-3697
FAX # (262)249-0639

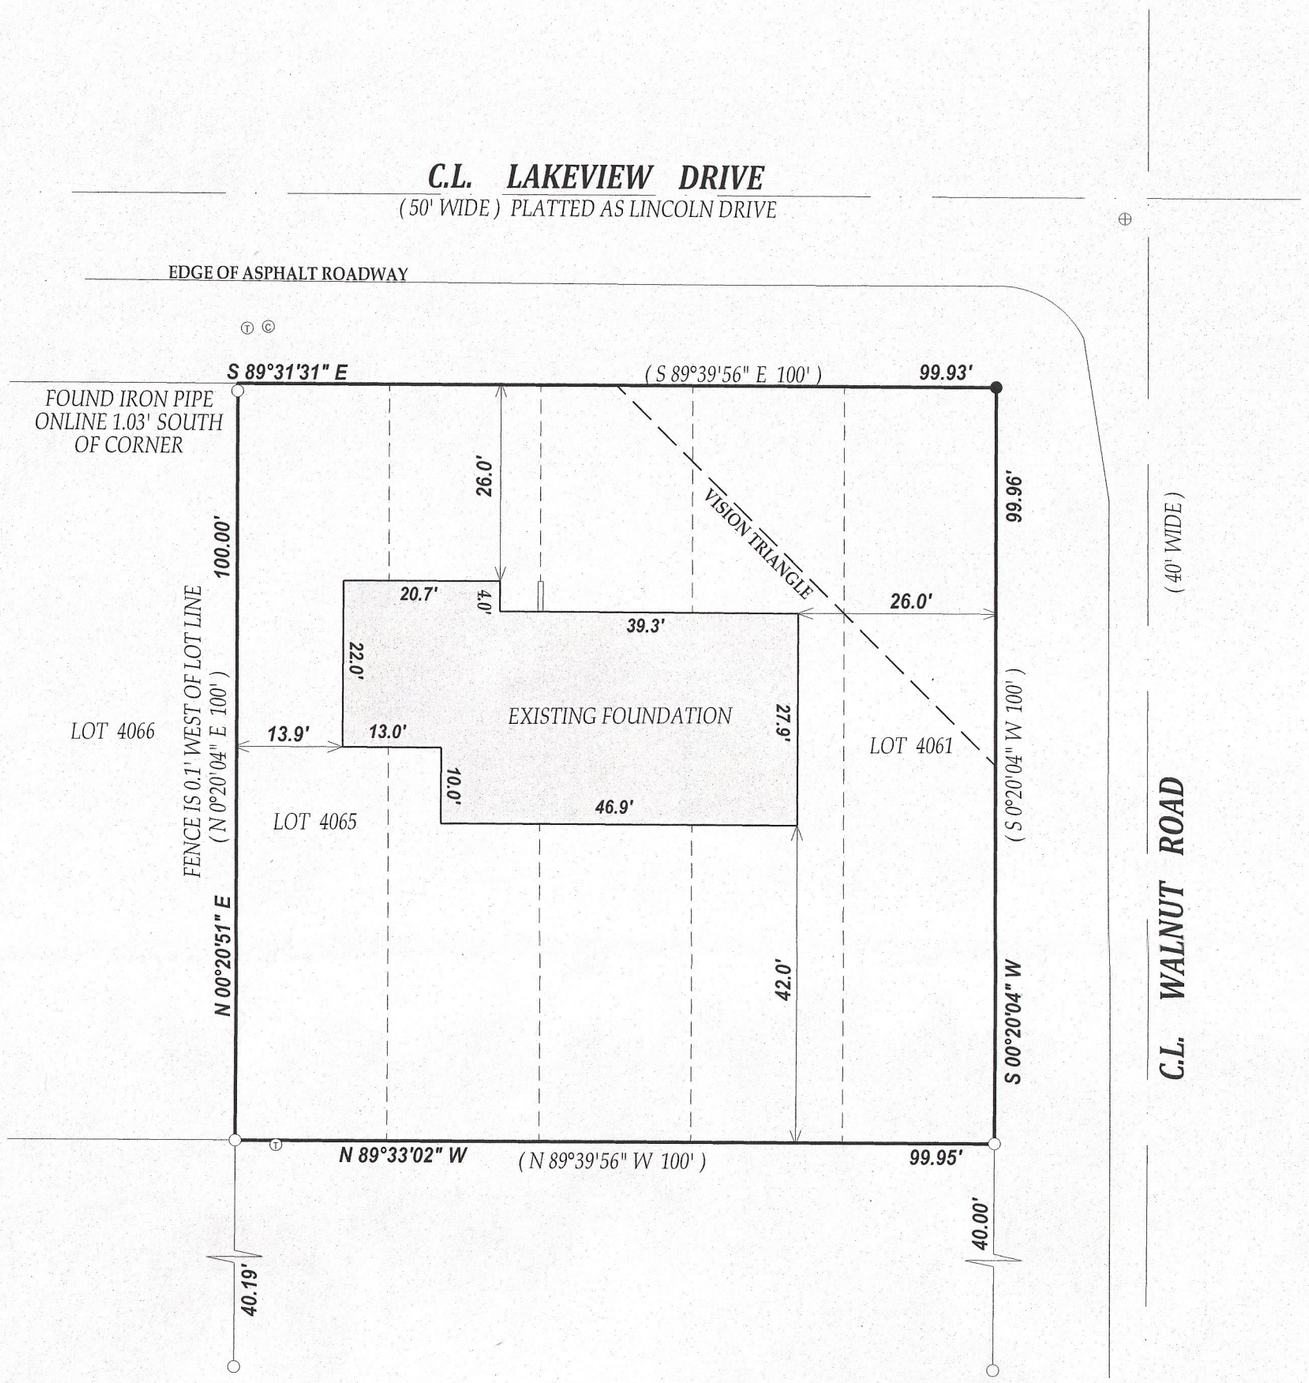



SCALE 1" = 20'

0 20 40 60

NOTE: BEARINGS ARE REFRENCED TO THE RECORD PLAT
NOTE: VERTICAL DATUM BASED ON N.G.V.D. 1929

RECEIVED
OCT 4 2013

WISCONSIN
JOHN P.
KROTT
S-2258
LAKE GENEVA
WIS.
LAND SURVEYOR

LEGEND

- ○ FOUND IRON PIPE
- ● SET IRON PIPE
- Ⓣ TELEPHONE PEDESTAL
- Ⓒ CABLE PEDESTAL
- (XX) RECORDED AS

TAX ID # JLCB00780
JOB # 13-084AB

I have surveyed the above-described property and the above map is a true representation thereof and shows the size and location of the property, its exterior boundaries, the location and dimensions of all structures thereon, fences apparent easements and roadways and visible encroachments. if any.

This survey is made for the exclusive use of the present owners of the property, and also those who puchase, mortgage,or insure the title therto within one (1) year from date hereof, and as to them I warrant the accuracy of said survey map.

DATE OF LAST REVISION: 9/13/2013

DATED THIS 17th DAY OF JUNE 2013

JOHN KROTT S - 2258
Wisconsin Registered Land Surveyor
(original if signed in red)

217-3912