PREPARED FOR
BASSO BUILDERS
405 SKYLINE DR.
LAKE GENEVA WI. 53147

PLAT OF SURVEY OF

LOTS 7735 THROUGH 7740, INCLUSIVE, AND LOTS 7762 AND 7763, BLOCK 132 AS DESIGNATED AND DELINEATED ON THE MAP ENTITLED " MAP OF LAKE COMO BEACH." SAID LAND BEING IN THE TOWN OF GENEVA , COUNTY OF WALWORTH AND STATE OF WISCONSIN.

KROTT SURVEYING INC.
(262) 248-3697
N 3705 WILLOW BEND LANE
LAKE GENEVA WI. 53147

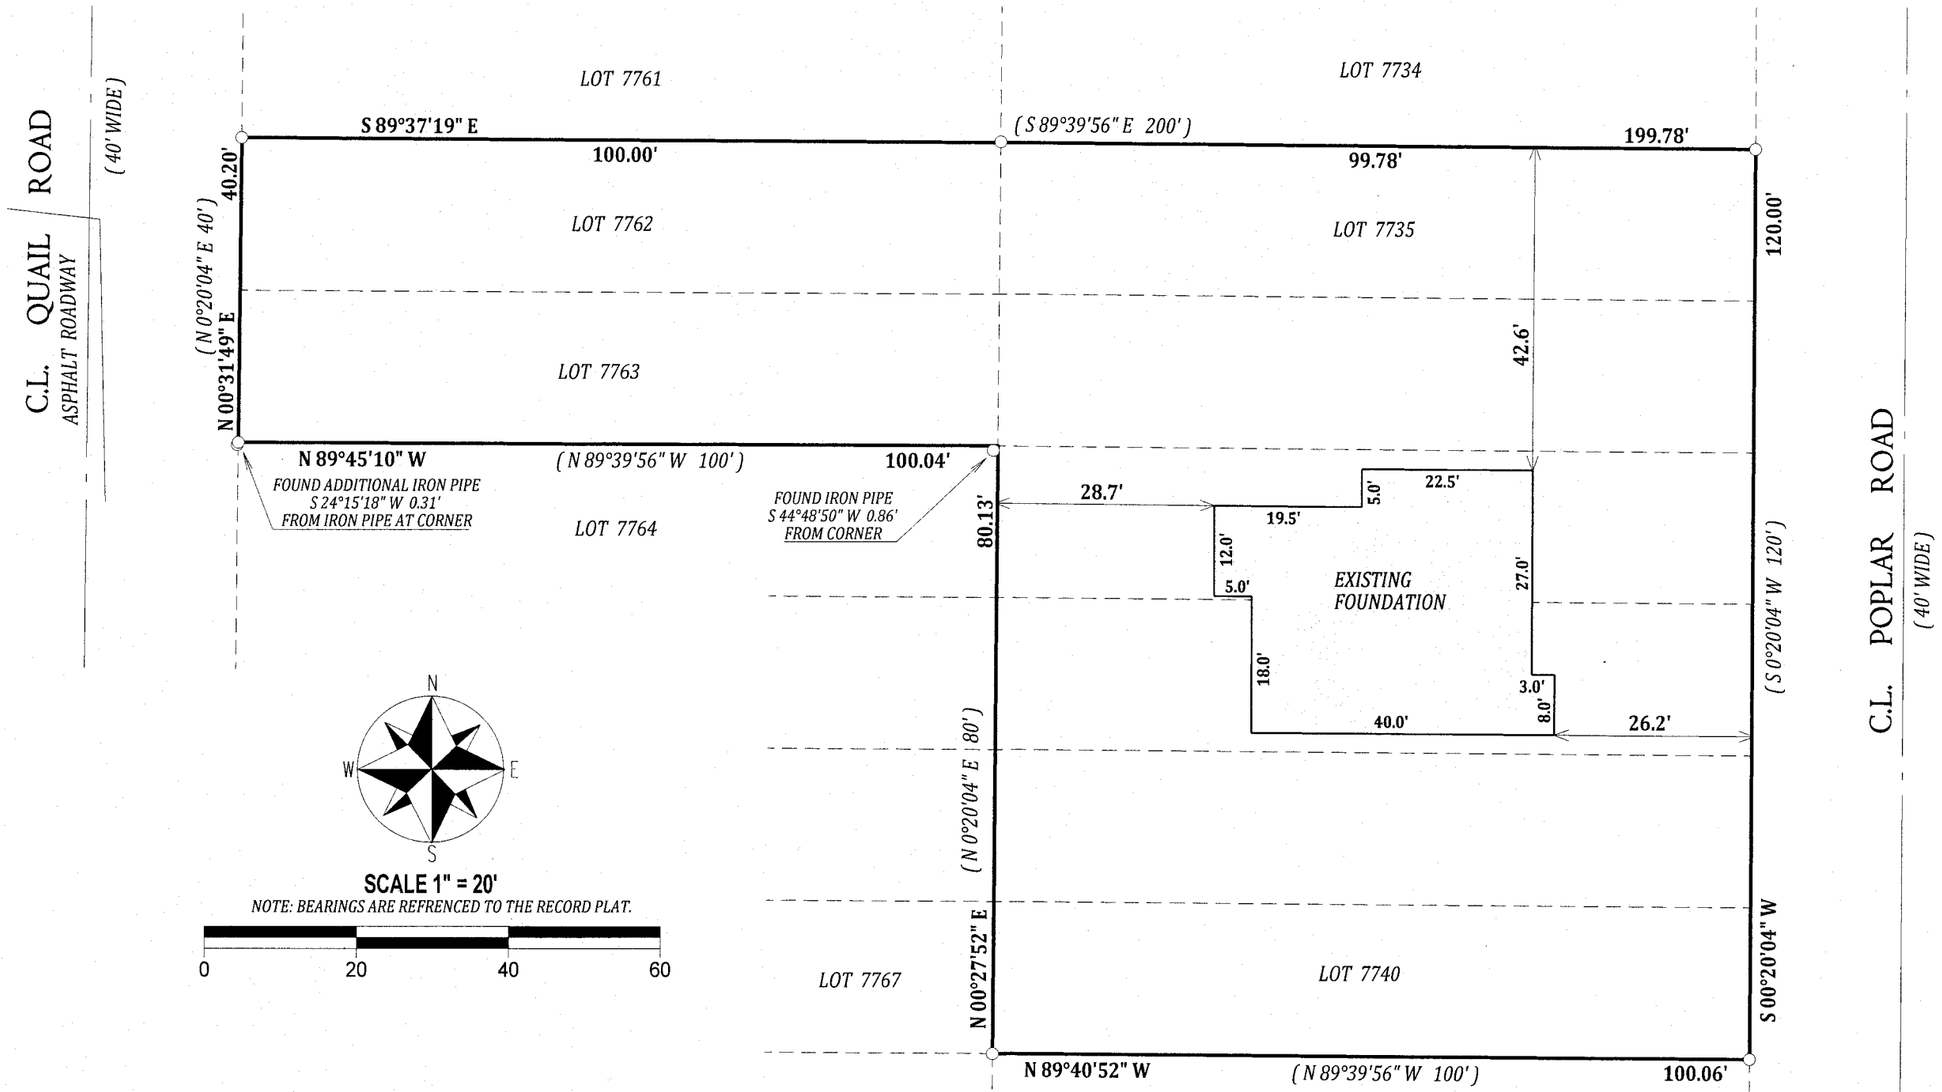

RECEIVED
JAN 21 2014
By jl

WISCONSIN
JOHN P.
KROTT
S-2258
LAKE GENEVA
WIS.
LAND SURVEYOR

DATED THIS 28th DAY OF OCTOBER 2013
DATE OF LAST REVISION: 12 / 04 / 2013

JOHN P. KROTT S-2258
WISCONSIN REGISTERED LAND SURVEYOR
(NOTE: THIS IS NOT A CERTIFIED COPY UNLESS SIGNED IN RED INK)

LEGEND

○ FOUND IRON PIPE

□ FOUND IRON BAR

(XX) RECORDED AS

TAX ID # JLCB01643

JOB # 13-163AB

I have surveyed the above-described property and the above map is a true representation thereof and shows the size and location of the property, its exterior boundaries, the location and dimensions of all structures thereon, fences apparent easements and roadways and visible encroachments. if any.

This survey is made for the exclusive use of the present owners of the property, and also those who puchase, mortgage,or insure the title therto within one (1) year from date hereof; and as to them I warrant the accuracy of said survey map.

JLCB 01643

217-3933