
PREPARED FOR:
PATRICK MCPARTLAND


PLAT OF SURVEY

- OF -

PATHFINDER SURVEYING INC.
(formerly)
J.K. SURVEYING INC.
P.O BOX 322
LAKE GENEVA, WI. 53147
WWW.PATHFINDERSURVEYING.NET
262-248-8303

LOTS 6652 THRU 6658 BLOCK 114OF LAKE COMO BEACH SUBDIVISION; LOCATED IN TOWN 2 NORTH, RANGE 17 EAST, TOWN OF GENEVA, WALWORTH COUNTY, WISCONSIN

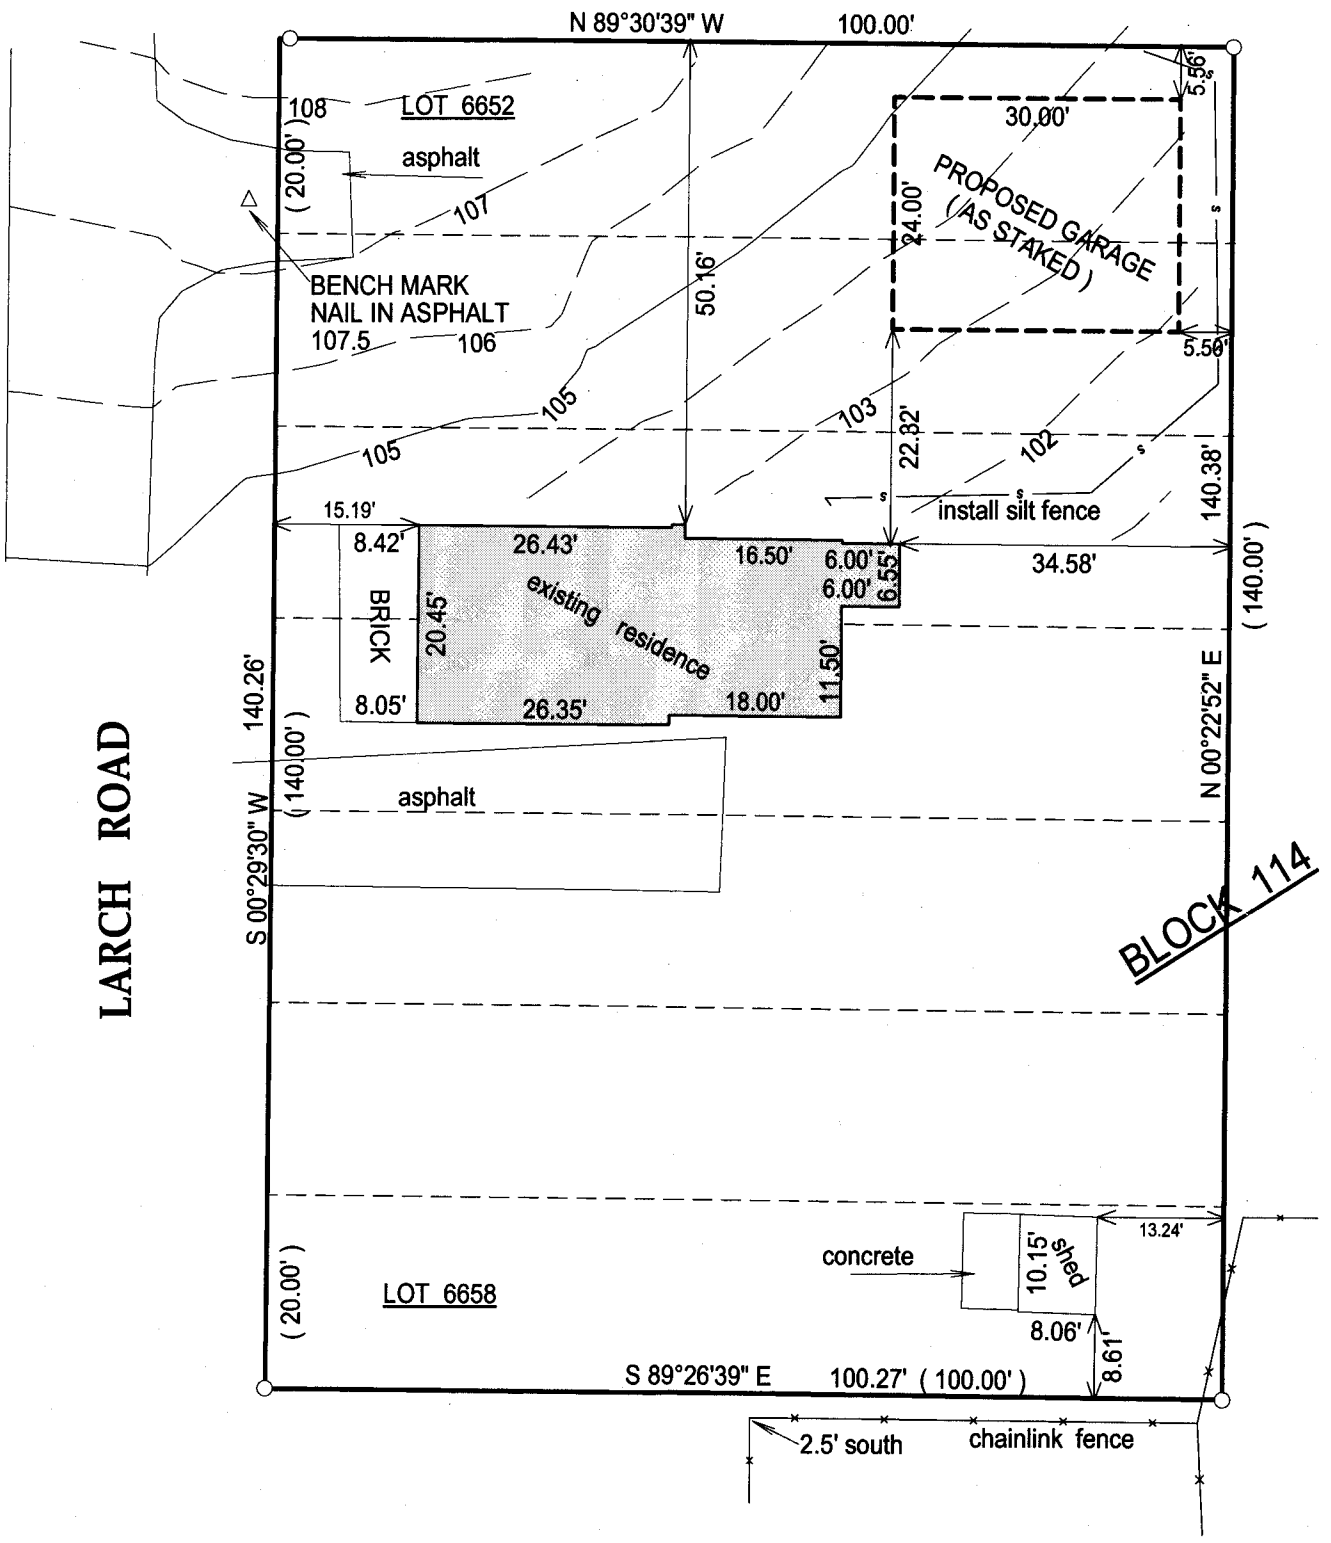

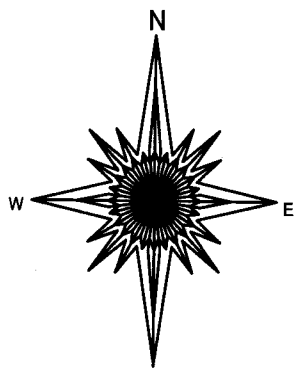

20 0 20 40 60

( )= recorded as

□ = found iron bar

○ = found iron pipe

● = set iron pipe

■ = set iron bar

SCALE 1" = 20'

JOB # 14-185

TAX ID # JLCB 01393

BASIS OF BEARING OF THIS PLAT: THE EAST LINE OF LARCH RD WAS ASSUMED TO BEAR S 00°29'30" W.

I hereby certify that I have surveyed the above- described property and the above map is a is a true representation thereof and shows the size and location of the property, its exterior boundaries, the location and dimensions of all structures thereon, fences, apparant easements and roadways and visible encroachments if any.

This survey is made for the present owners of the property, and those who purchase, mortgage, or guarantee the title thereto, within one year from the date hereof.

DATED THIS 19TH DAY OF AUGUST, 2014.

RECEIVED
OCT 7 2014
By Jan

WISCONSIN
JEFFREY L. KIMPS S-2436 LAKE GENEVA. WIS.
LAND SURVEYOR

JEFFREY L KIMPS S - 2436
Wisconsin Registered Land Surveyor
(original if signed in red)

JLCB 01393 217-3998