PREPARED FOR:
CHRIS KAYSER
KEEFE REAL ESTATE, INC.
751 GENEVA PARKWAY
LAKE GENEVA, WI. 53147


SURVEY ADDRESS:
N3174 TAMARACK RD.


PLAT OF SURVEY

-OF-

LOTS 10173 THROUGH 10177, INCLUSIVE, BLOCK 185 IN LAKE COMO BEACH FIFTH MAP, IN THE TOWN OF GENEVA, COUNTY OF WALWORTH, STATE OF WISCONSIN.

LYNCH & ASSOCIATES
ENGINEERING CONSULTANTS, LLC.
5482 S. WESTRIDGE DR.
NEW BERLIN, WI 53151
(262) 248-3697

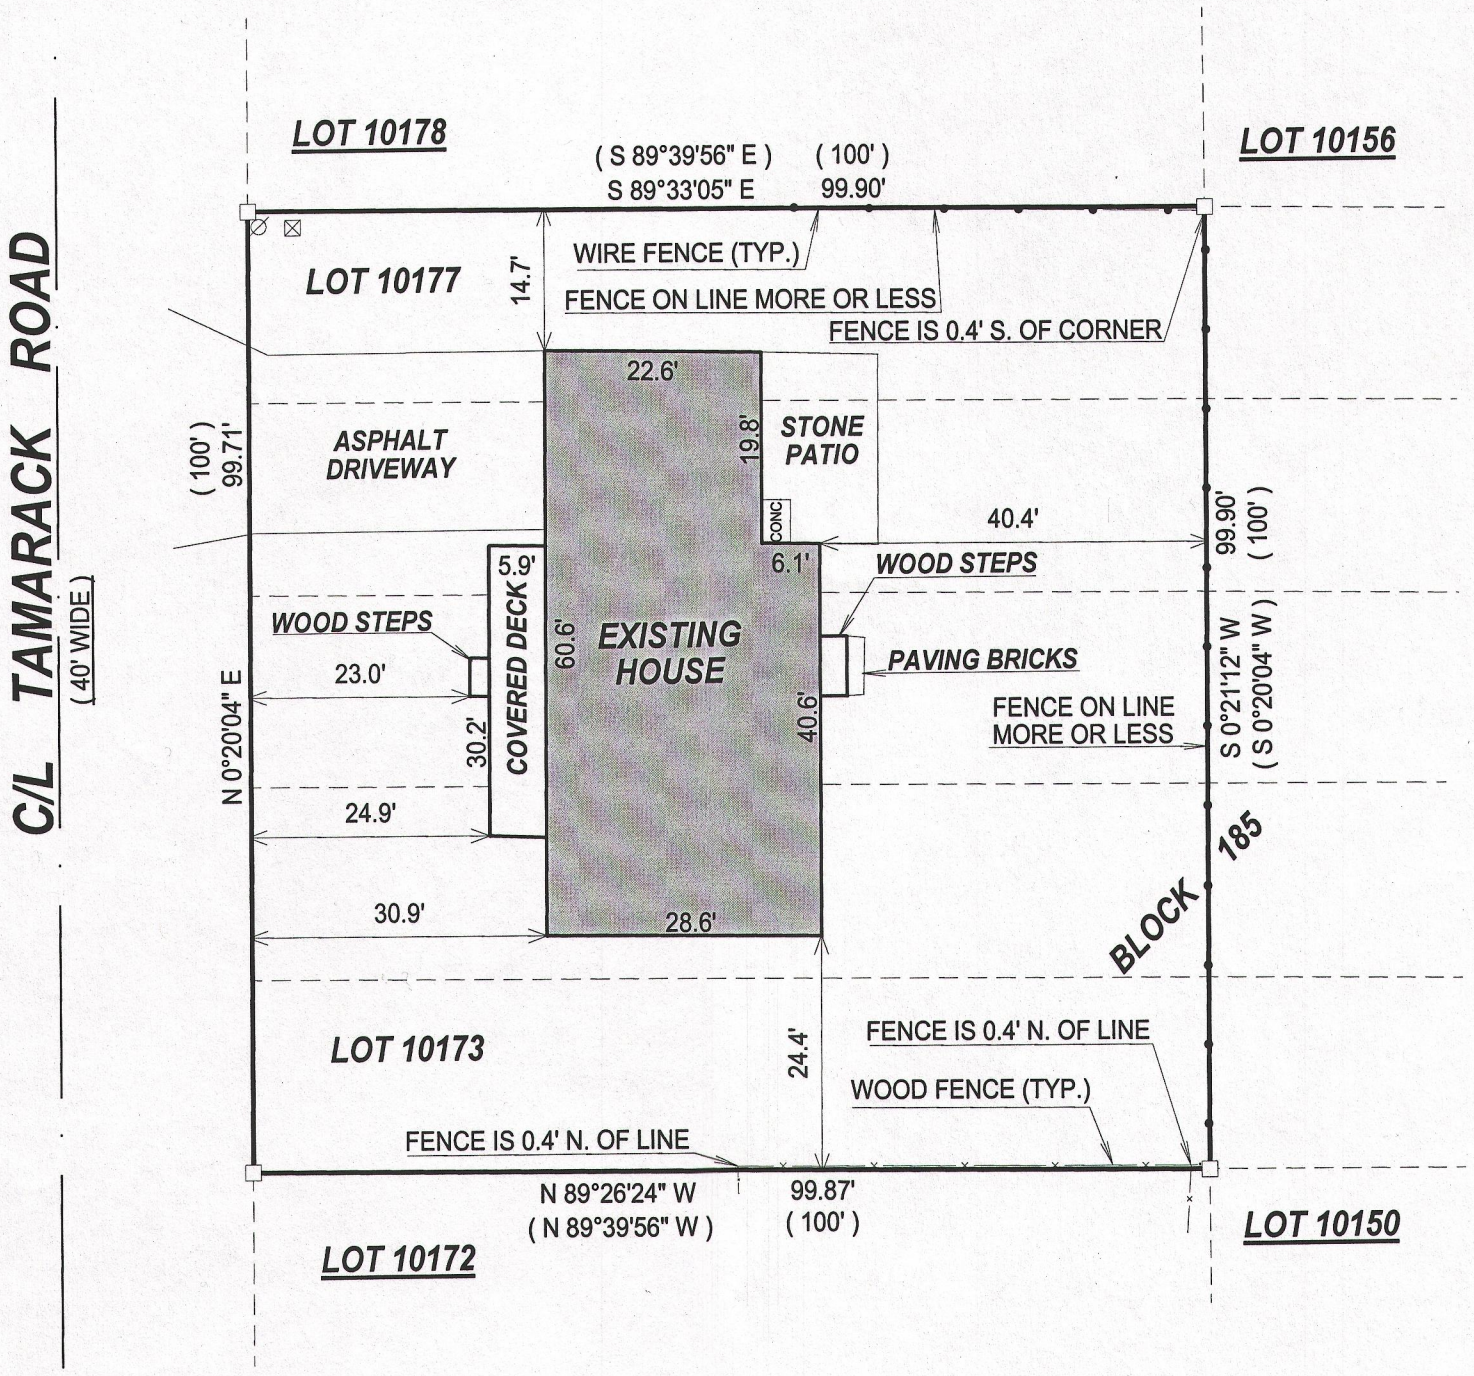

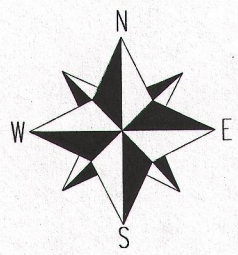

BEARINGS HEREON REFERENCED TO THE FIFTH MAP OF LAKE COMO BEACH SUBDIVISION.

LEGEND

- □ *FOUND 5/8" IRON ROD*
- (XX) *RECORDED AS*
- ⊠ *UTILITY PEDISTAL*
- ∅ *POWER POLE*

SCALE 1" = 20'

0 20 40 60 80 100

RECEIVED
NOV 20 2014
By gle

NOTE:
No title commitment or reults of a title search were provided to this office pertaining to this survey. This Plat Of Survey may not reflect easements of record, encumbrances, restrictions, ownership, title evidence, or other facts that a current and accurate title search may disclose.

I have surveyed the above-described property and the above map is a true representation thereof and shows the size and location of the property, its exterior boundaries, the location and dimensions of all structures thereon, fences apparent easements and roadways and visible encroachments. if any.

This survey is made for the exclusive use of the present owners of the property, and also those who puchase, mortgage,or insure the title therto within one (1) year from date hereof; and as to them I warrant the accuracy of said survey map.

WISCONSIN
KENNETH B. MEHRING
S-2838
WATERFORD WIS.
LAND SURVEYOR

DATED THIS 20th DAY OF AUGUST, 2014

KENNETH B. MEHRING S - 2838
Wisconsin Registered Land Surveyor
(original if signed in red)

JOB # 14-601
TAX ID # JLCB02198A

JLCB-02198A

217-4011