
PREPARED FOR
PAMALA HANSON - MILLER

PLAT OF SURVEY

- OF -

LOT 2 OF WALWORTH COUNTY CERTIFIED SURVEY MAP No. 160 RECORDED IN VOLUME 1, PAGE 160 OF CERTIFIED SURVEYS, AT THE WALWORTH COUNTY REGISTER OF DEEDS, BEING A PART OF THE NE 1/4 OF THE NW 1/4 OF SECTION 35, TOWN 2 NORTH , RANGE 17 EAST, TOWN OF GENEVA, COUNTY OF WALWORTH AND STATE OF WISCONSIN. TOGETHER WITH A NON - EXCLUSIVE EASEMENT FOR INGRESS AND EGRESS AS SHOWN ON SAID CERTIFIED SURVEY No. 160.

PATHFINDER SURVEYING INC.
(formerly)
J.K. SURVEYING INC.
P.O BOX 322
LAKE GENEVA, WI. 53147
WWW.PATHFINDERSURVEYING.NET
262-248-8303

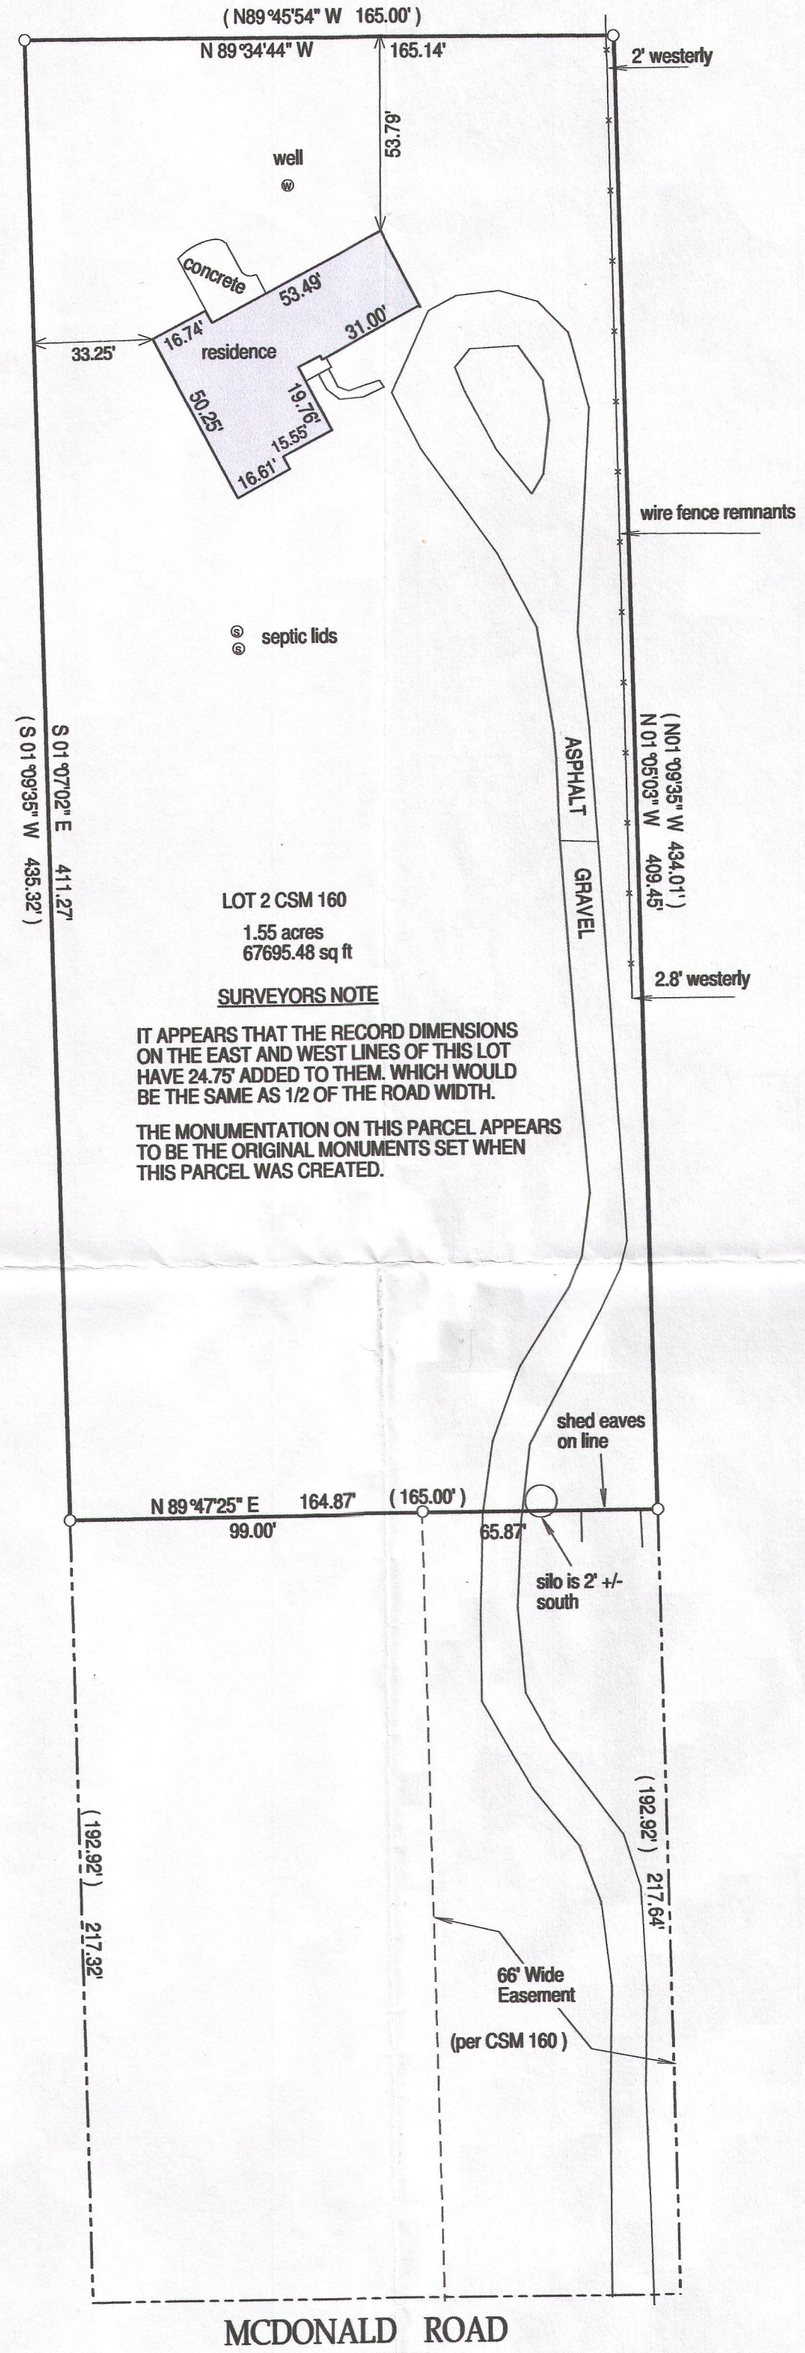

( )= recorded as
□ = found iron bar
○ = found iron pipe
● = set iron pipe
■ = set iron bar

SCALE 1" = 40'

JOB # 14-238

TAX ID # JA16000002

40 0 40 80 120 160

BASIS OF BEARING OF THIS PLAT: THE SOUTH LINE OF LOT 2 OF CSM 160 WAS ASUMED TO BEAR N89°47'25" E AS RECORDED.

I hereby certify that I have surveyed the above- described property and the above map is a is a true representation thereof and shows the size and location of the property, its exterior boundaries, the location and dimensions of all structures thereon, fences, apparant easements and roadways and visible encroachments if any.

This survey is made for the present owners of the property, and those who purchase, mortgage, or guarantee the title thereto, within one year from the date hereof.

DATED THIS 5TH DAY OF OCTOBER, 2014.

RECEIVED
JAN 21 2015
By Jan

WISCONSIN
JEFFREY L. KIMPS S-2436 LAKE GENEVA. WIS.
LAND SURVEYOR

JEFFREY L KIMPS S - 2436
Wisconsin Registered Land Surveyor
(original if signed in red)

JA 160-2

217-4042