




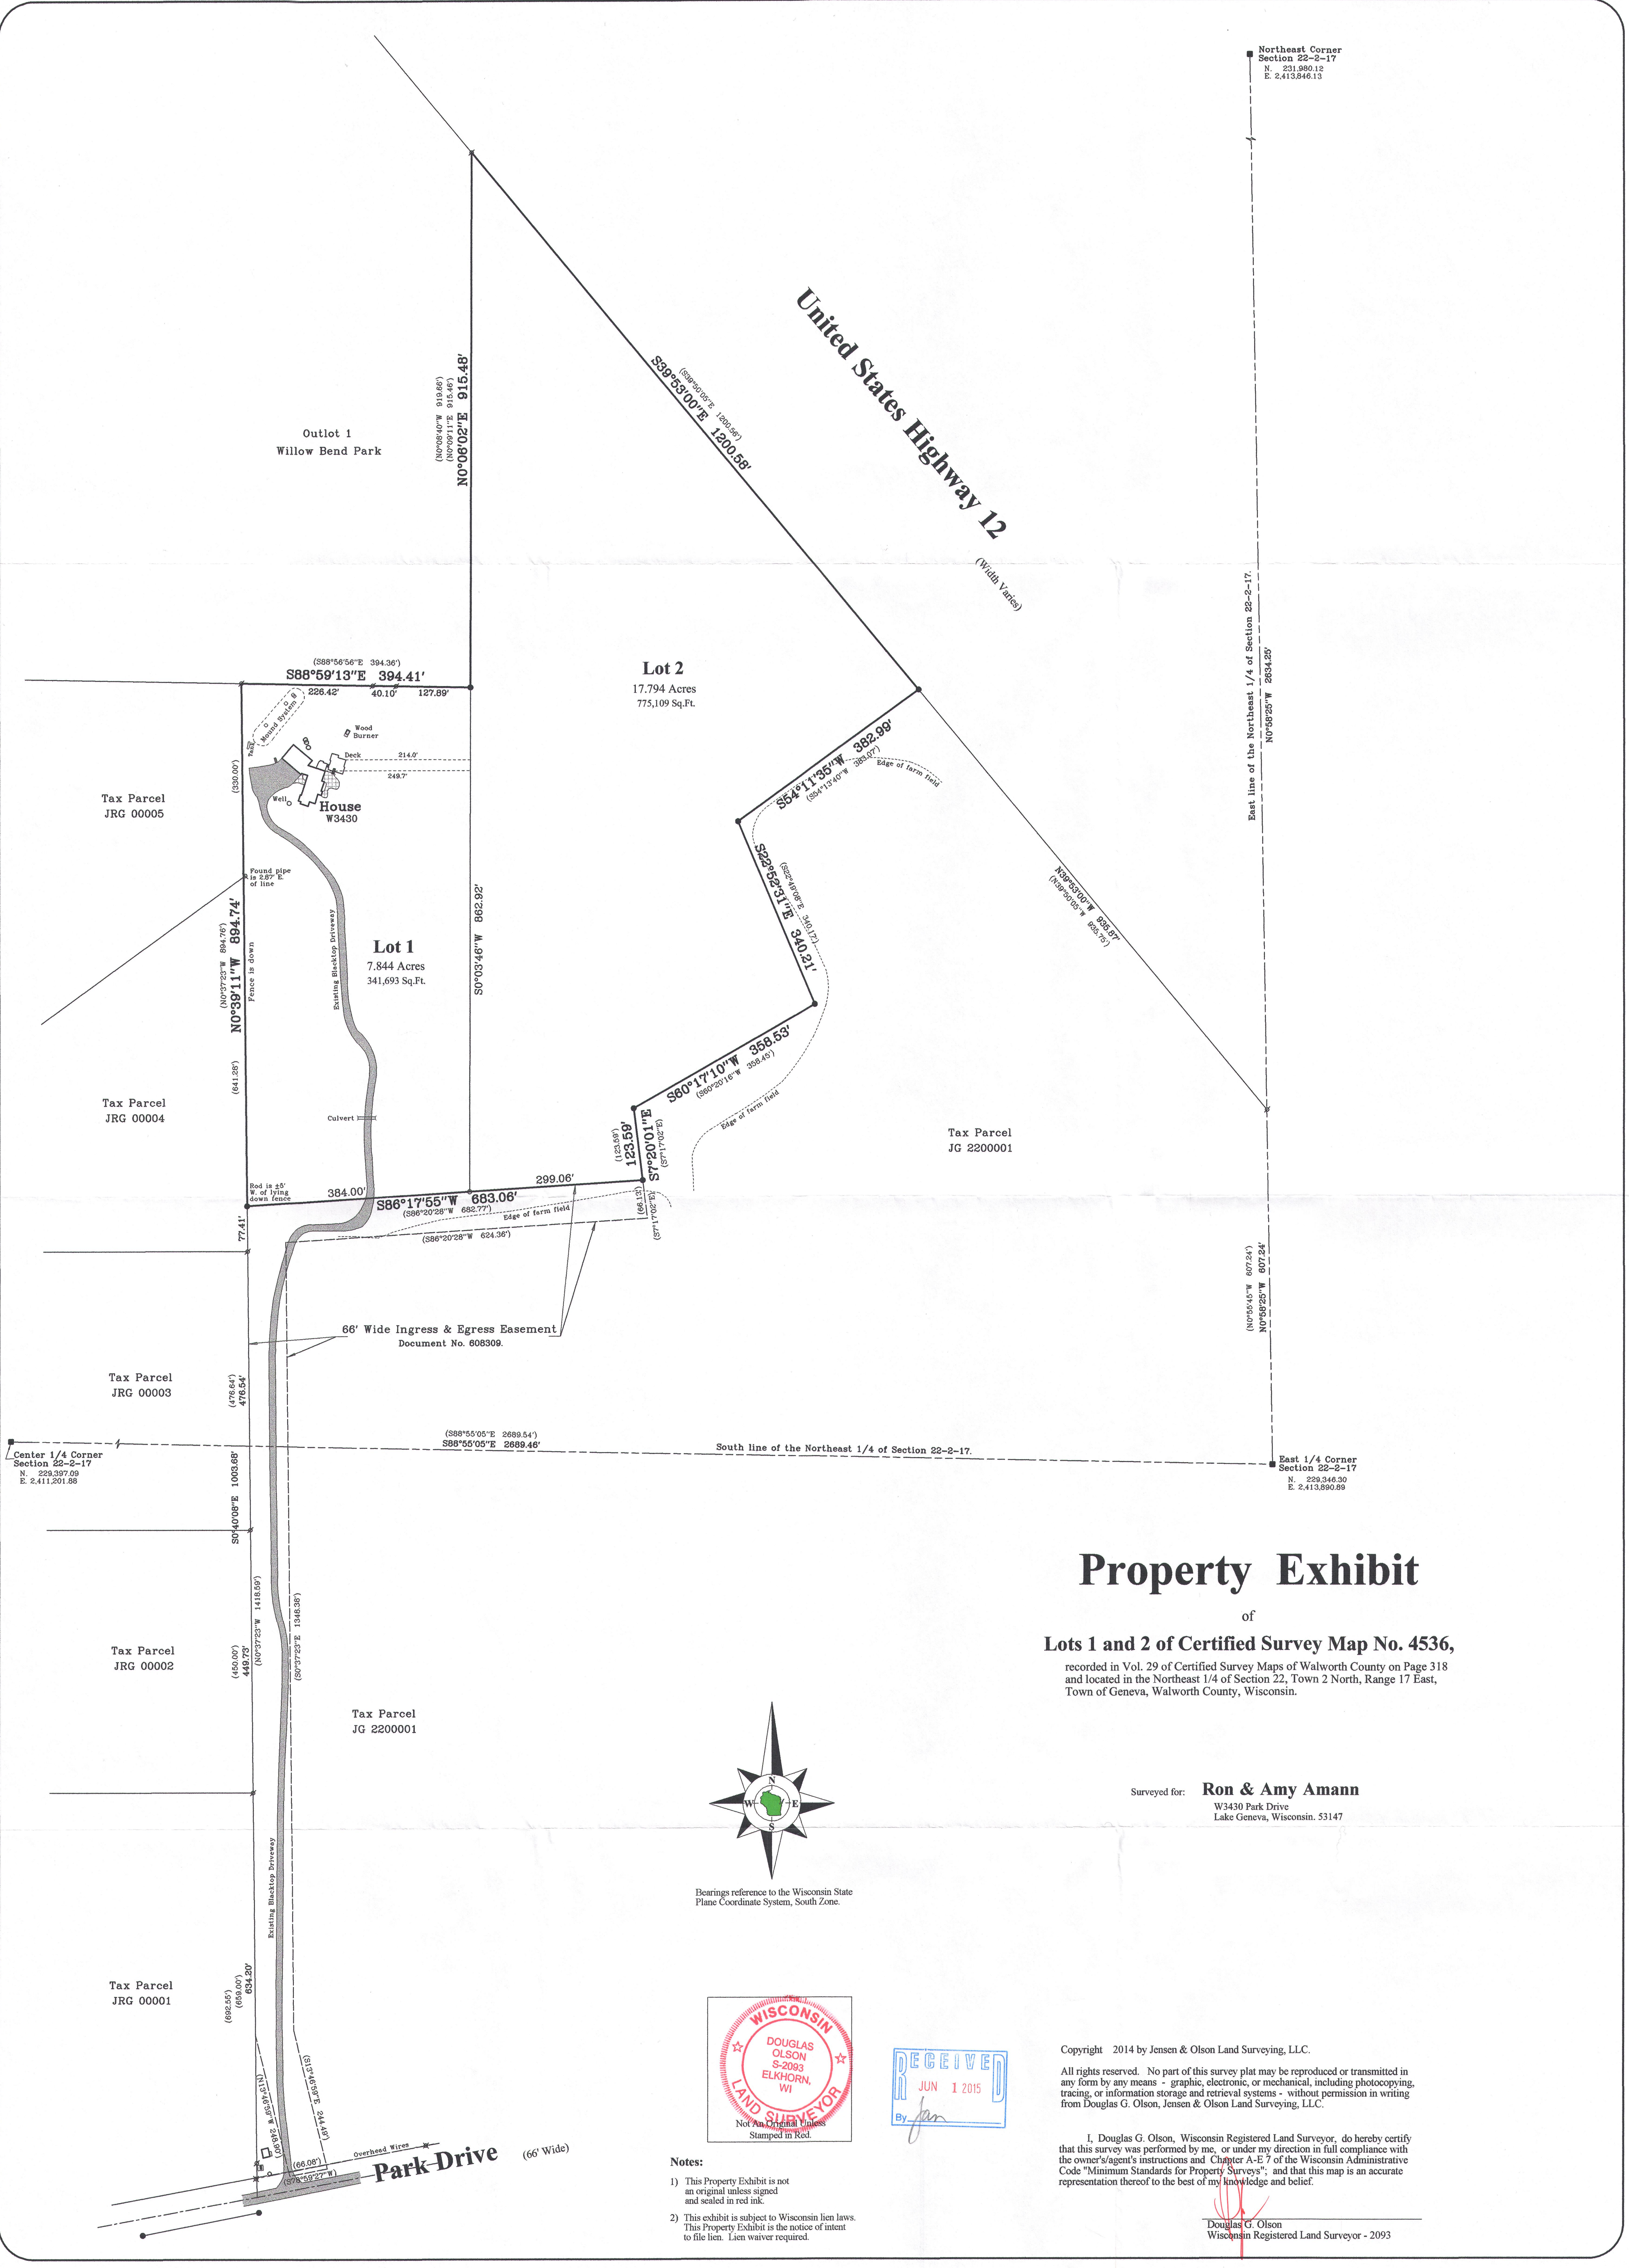


Property Exhibit
of
Lots 1 and 2 of Certified Survey Map No. 4536,
recorded in Vol. 29 of Certified Survey Maps of Walworth County on Page 318
and located in the Northeast 1/4 of Section 22, Town 2 North, Range 17 East,
Town of Geneva, Walworth County, Wisconsin.

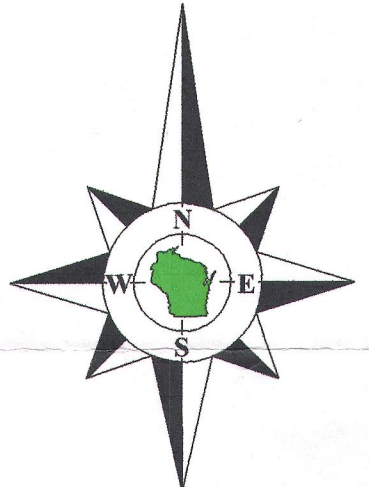

Bearings reference to the Wisconsin State
Plane Coordinate System, South Zone.

Surveyed for: **Ron & Amy Amann**
W3430 Park Drive
Lake Geneva, Wisconsin. 53147

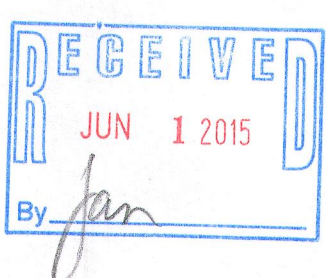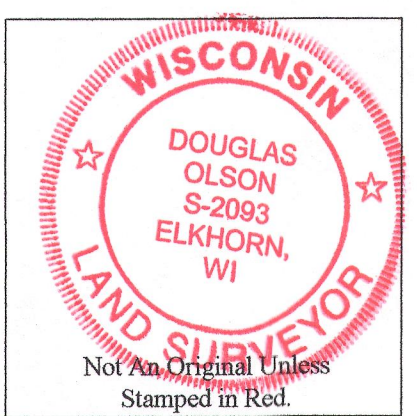

- Notes:**
- 1) This Property Exhibit is not an original unless signed and sealed in red ink.
 - 2) This exhibit is subject to Wisconsin lien laws. This Property Exhibit is the notice of intent to file lien. Lien waiver required.

Copyright 2014 by Jensen & Olson Land Surveying, LLC.
All rights reserved. No part of this survey plat may be reproduced or transmitted in any form by any means - graphic, electronic, or mechanical, including photocopying, tracing, or information storage and retrieval systems - without permission in writing from Douglas G. Olson, Jensen & Olson Land Surveying, LLC.

I, Douglas G. Olson, Wisconsin Registered Land Surveyor, do hereby certify that this survey was performed by me, or under my direction in full compliance with the owner's/agent's instructions and Chapter A-E 7 of the Wisconsin Administrative Code "Minimum Standards for Property Surveys"; and that this map is an accurate representation thereof to the best of my knowledge and belief.

Douglas G. Olson
Wisconsin Registered Land Surveyor - 2093

2014.017	Sheet 1 of 1 Sheets	 Jensen & Olson Land Surveying, LLC 45 South Wisconsin Street * P.O. Box 322 * Elkhorn, Wisconsin. 53121 Telephone: (262) 723-3434 * Facsimile: (262) 723-8044 Email: jensen.olson@elknet.net	Scale in Feet 1" = 100' 	Survey date: March 24, 2014. Revisions: No. 1 - Recorded CSM
	Drawing Name:			
	Job Reference Number 2014.017			
Legend - Found County Section Corner - Found Iron Pipe - Found Iron Rod - Set Iron Pipe, 1" dia. - Recorded Information - Utility Pole - Utility Pedestal - Concrete Cover - Septic Vent - Asphalt Surface - Concrete Surface - Brick Pavers				

JA4536-1
JA4536-2 217-4078