
PREPARED FOR:
William & Michelle Ziegler
6320 w. Peterson Ave.
Chicago, Il. 60646


PLAT OF SURVEY

-OF-

LOTS 10443, 10444, 10445, 10446 AND 10447 IN BLOCK 189,
LAKE COMO BEACH FIFTH MAP, SECTION 28, T2N, R17E,
TOWN OF GENEVA, WALWORTH COUNTY, WISCONSIN.

LYNCH & ASSOCIATES
ENGINEERING CONSULTANTS, LLC.
405 SKYLINE DRIVE, SUITE C
LAKE GENEVA, WI 53147
(262) 248-3697

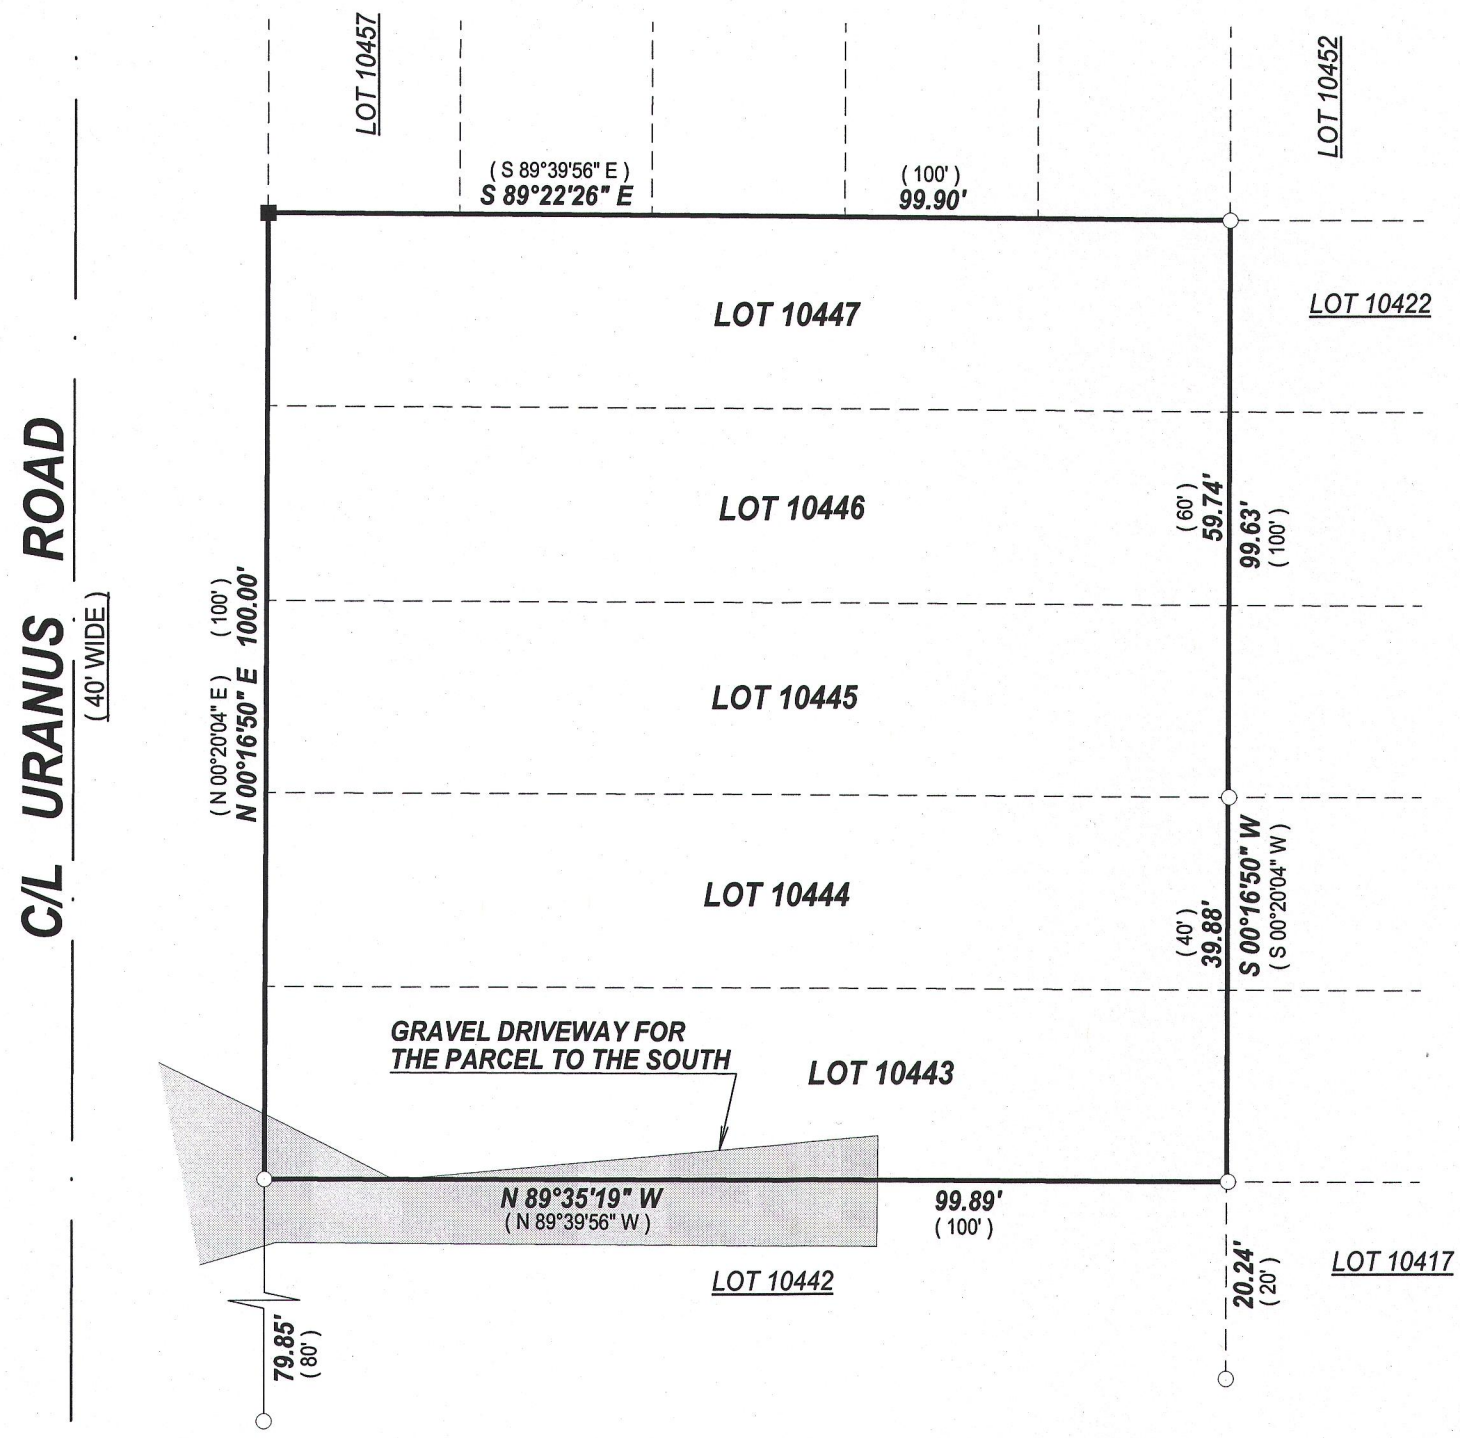

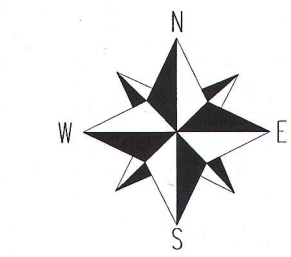

BEARINGS HEREON REFERENCED TO THE WISCONSIN COUNTY COORDINATE SYSTEM, WALWORTH COUNTY ZONE.

SCALE 1" = 20'

0 20 40 60

LEGEND

- ○ FOUND 1" IRON PIPE
- □ FOUND 5/8" IRON BAR
- ■ SET 5/8" O.D. X 18" IRON BAR 1.13#/L.F.
- (XX) RECORDED AS

RECEIVED
JUL 1 2015
By

NOTE:
No title commitment or reults of a title search were provided to this office pertaining to this survey. This Plat Of Survey may not reflect easements of record, encumbrances, restrictions, ownership, title evidence, or other facts that a current and accurate title search may disclose.

I have surveyed the above-described property and the above map is a true representation thereof and shows the size and location of the property, its exterior boundaries, the location and dimensions of all structures thereon, fences apparent easements and roadways and visible encroachments. if any.

This survey is made for the exclusive use of the present owners of the property, and also those who puchase, mortgage,or insure the title therto within one (1) year from date hereof; and as to them I warrant the accuracy of said survey map.

WISCONSIN
KENNETH B. MEHRING
S-2838
WATERFORD WIS.
LAND SURVEYOR

DATED THIS 8th DAY OF MAY, 2015

KENNETH B. MEHRING S - 2838
Wisconsin Professional Land Surveyor
(original if signed in red)

JOB # 15-568
TAX ID # JLCB 02263

JLCB-02263 217-4092