PREPARED FOR
TYLER MEYER
SHOREWEST REALTY
DELAVAN WI.

# PLAT OF SURVEY

- OF -

*PATHFINDER SURVEYING INC.*
*( formerly )*
*J.K. SURVEYING INC.*
*P.O BOX 322*
*LAKE GENEVA, WI. 53147*
*WWW.PATHFINDERSURVEYING.NET*
*262-248-8303*

UNIT 38-28, GENEVA NATIONAL CONDONINIUM No. 38, LOCATED
IN TOWN 2 NORTH, RANGE 17 EAST, WALWORTH COUNTY, WISCONSIN.

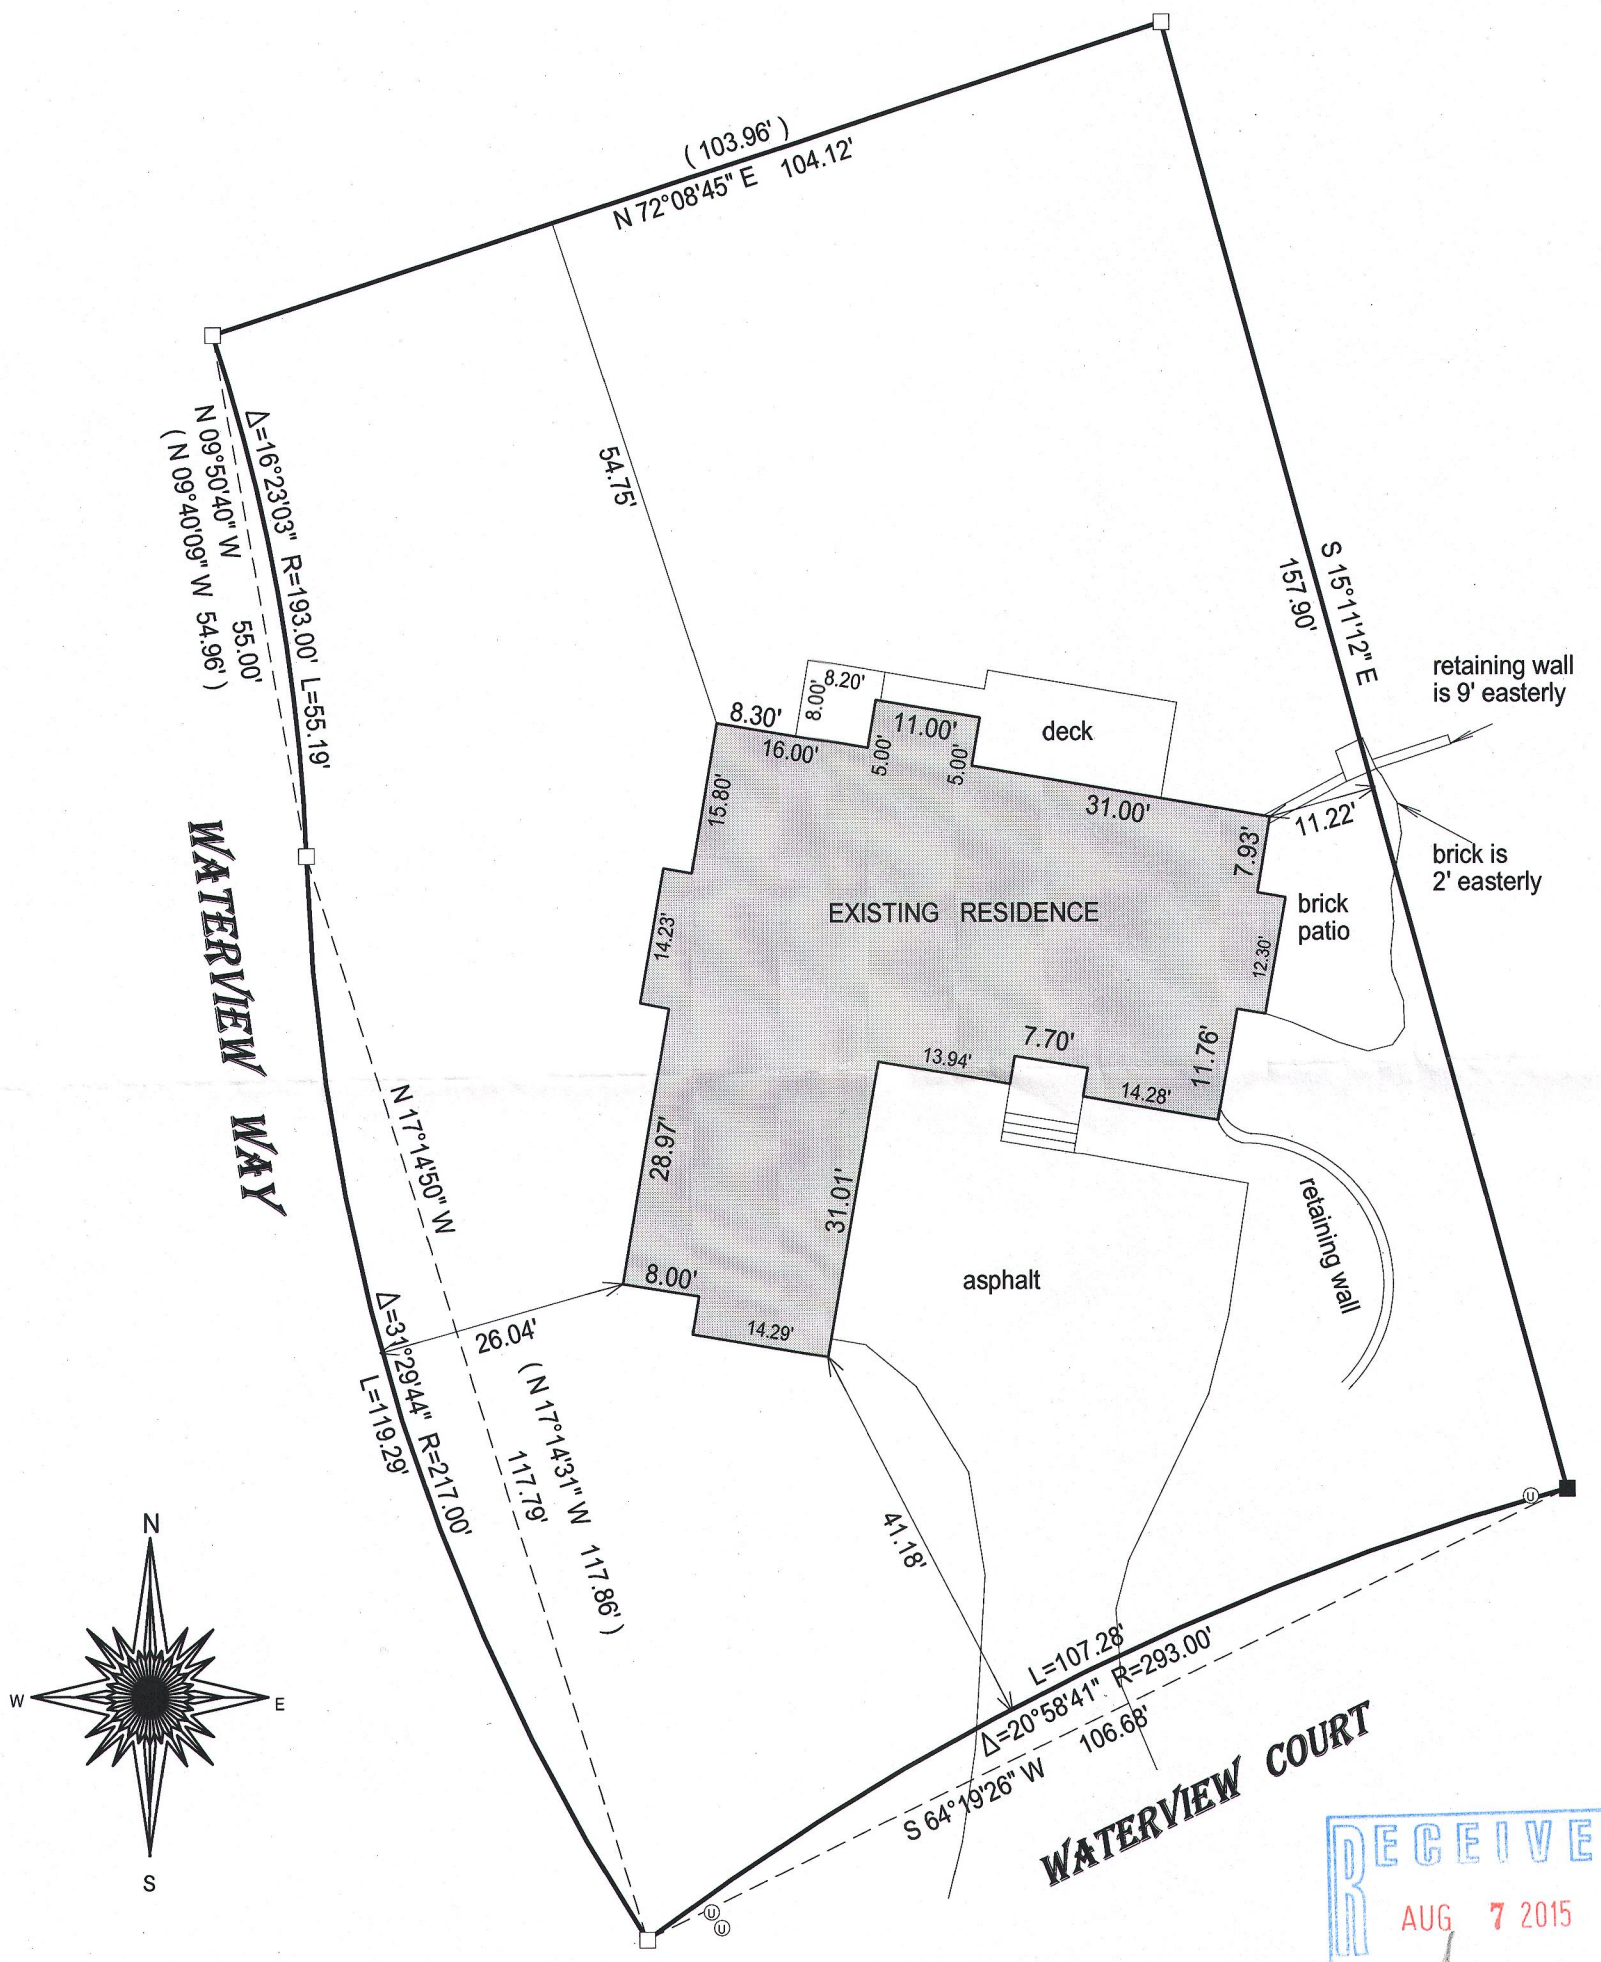


RECEIVED
AUG 7 2015
By

( )= recorded as

□ = found iron bar

○ = found iron pipe

● = set iron pipe

■ = set iron bar

SCALE 1" = 20'

JOB # 15-73

TAX ID # JGN 3800028

20 0 20 40 60 80

BASIS OF BEARING OF THIS PLAT: THE CONDOMINIUM PLAT OF RECORD.

I hereby certify that I have surveyed the above- described property and the above map is a is a true representation thereof and shows the size and location of the property, its exterior boundaries, the location and dimensions of all structures thereon, fences, apparant easements and roadways and visible encroachments if any.

This survey is made for the present owners of the property, and those who purchase, mortgage, or guarantee the title thereto, within one year from the date hereof.

DATED THIS 31ST DAY OF MARCH, 2015.

WISCONSIN
JEFFREY L. KIMPS
S-2436
LAKE GENEVA. WIS.
LAND SURVEYOR

JEFFREY L KIMPS S-2436
Wisconsin Registered Land Surveyor
*( original if signed in red )*

JGN 38-28 217-4104