
PREPARED FOR
JOHN MITCHEL
3251 WALNUT RD.
LAKE GENEVA, WI.

PLAT OF SURVEY

- OF -

LOTS 3987 THRU 3991 AND 3997 THRU 4002, BLOCK 69, LAKE COMO BEACH, A SUBDIVISION LOCATED IN TOWN 2 NORTH, RANGE 17 EAST, WALWORTH COUNTY, WISCONSIN.

PATHFINDER SURVEYING INC.
(formerly)
J.K. SURVEYING INC.
P.O BOX 322
LAKE GENEVA, WI. 53147
WWW.PATHFINDERSURVEYING.NET
262-248-8303

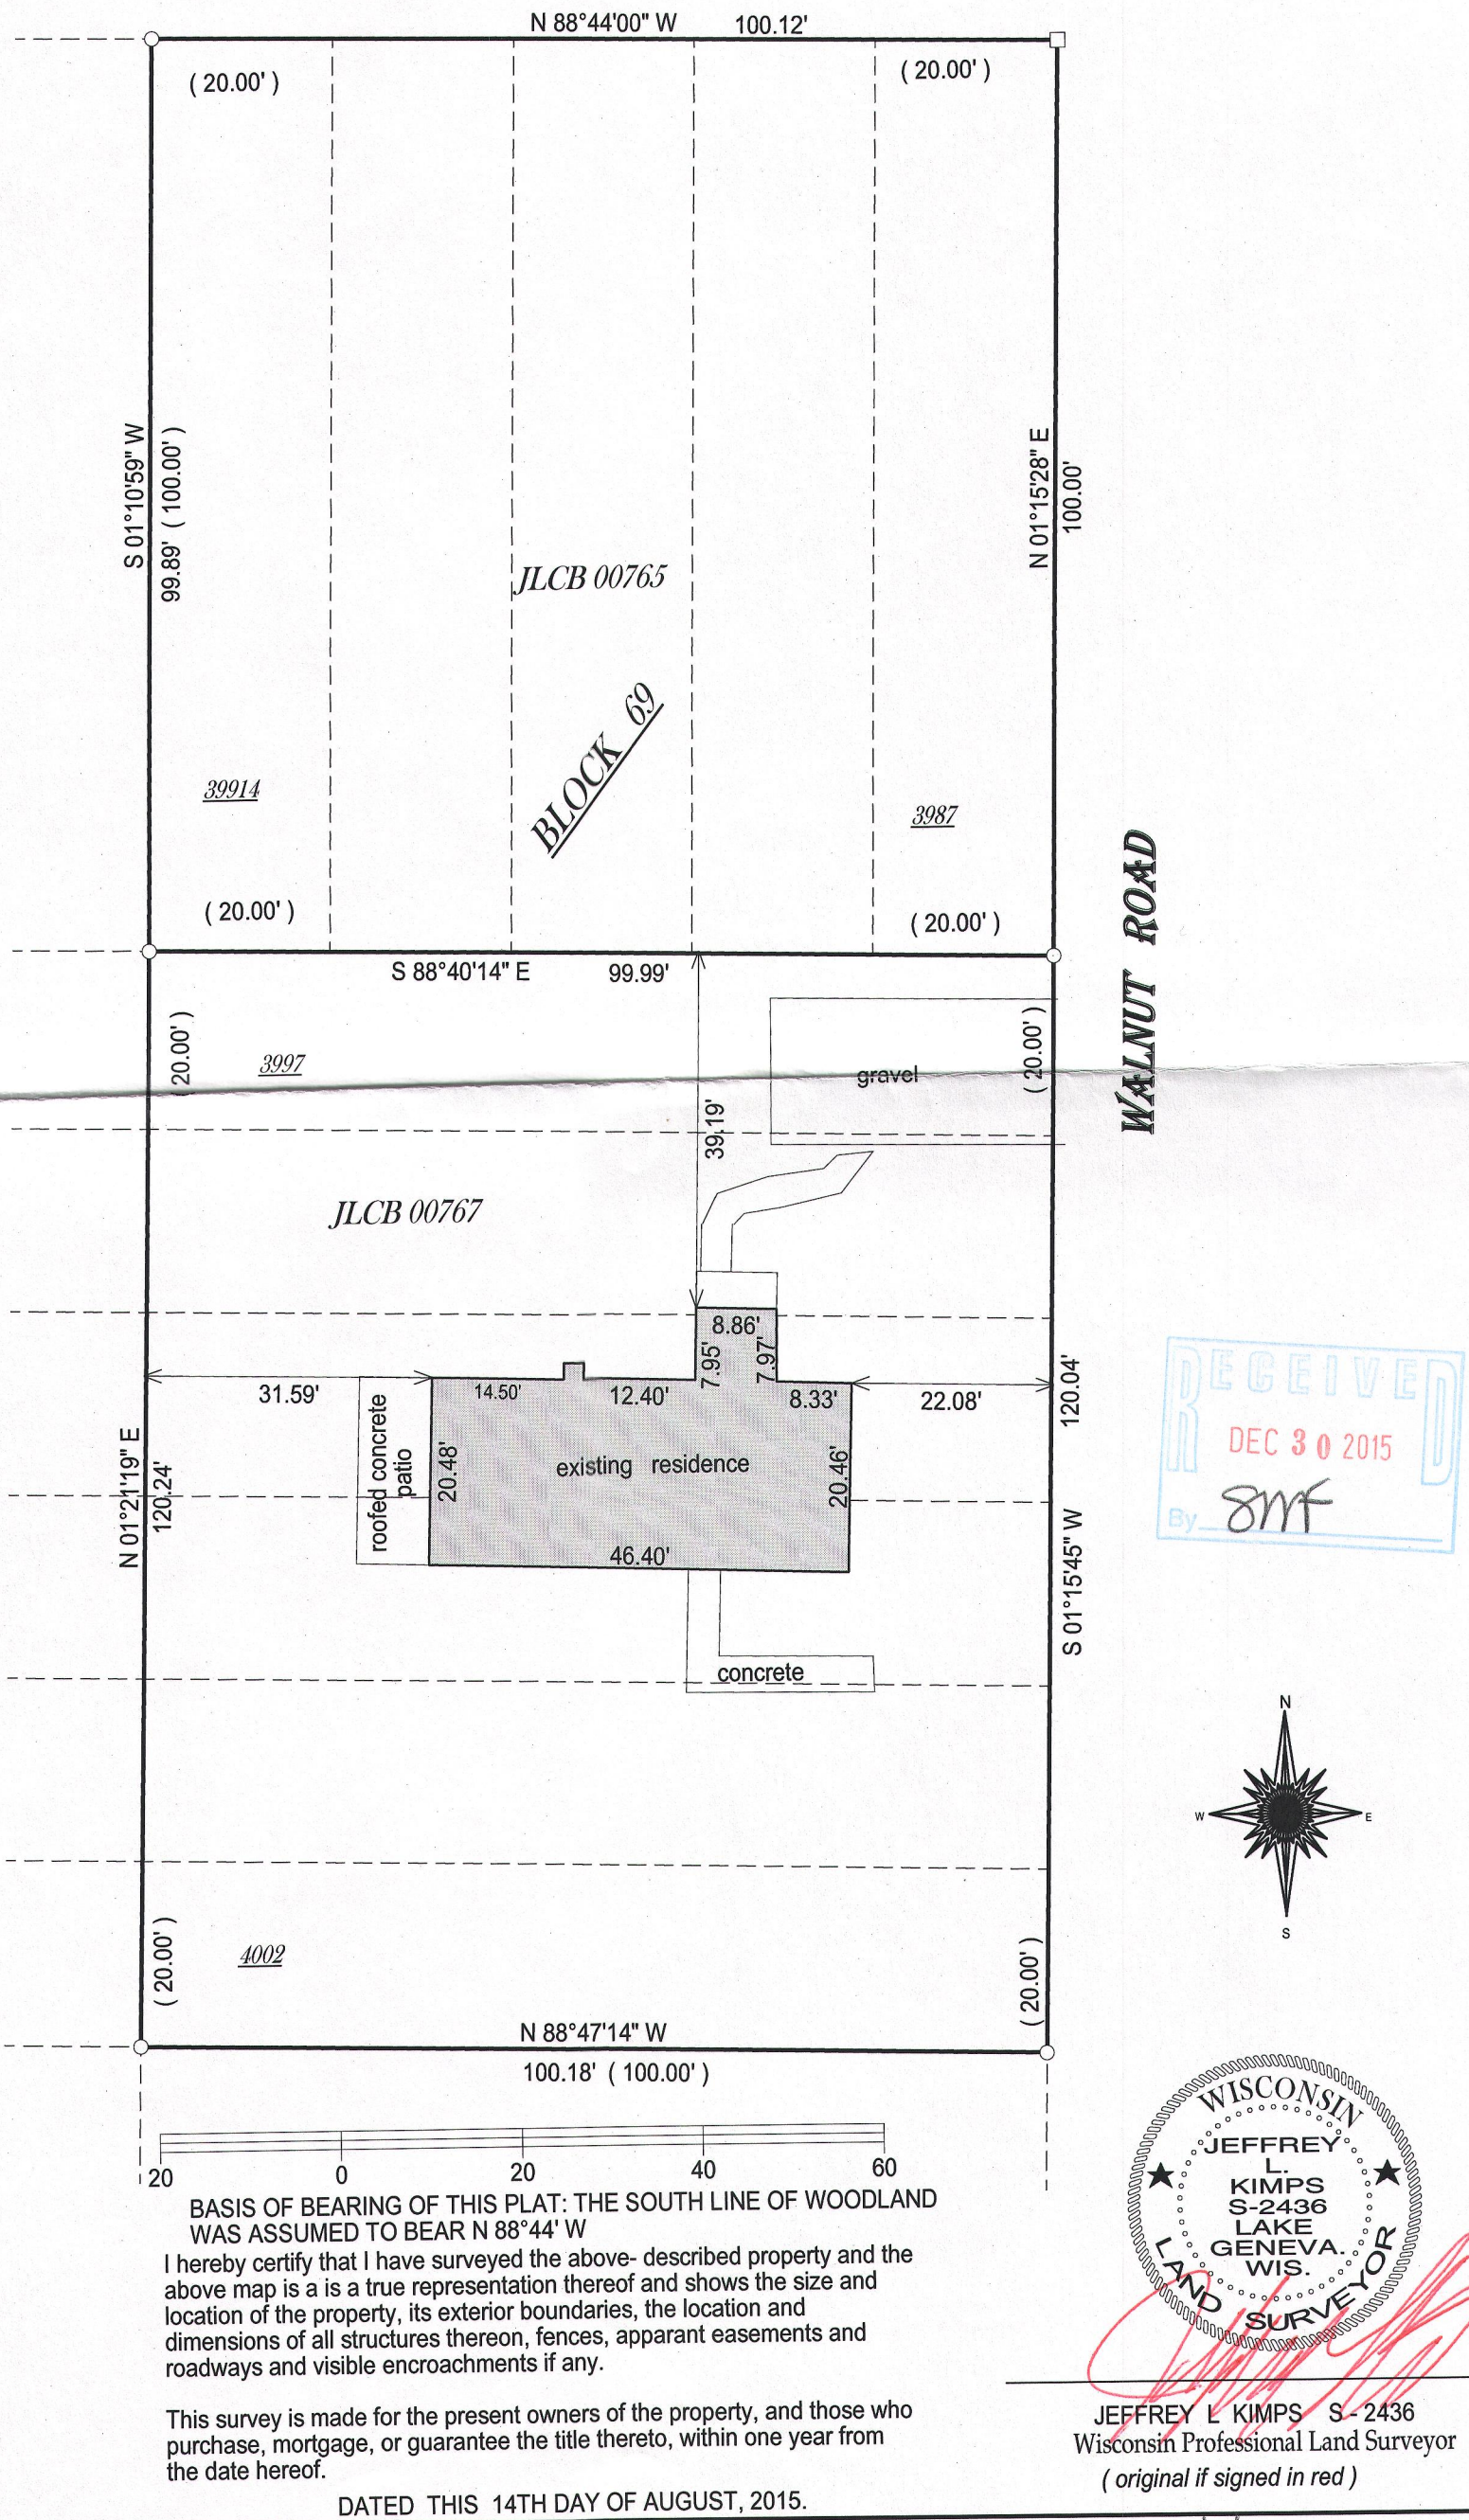

( )= recorded as

□ = found iron bar

○ = found iron pipe

● = set iron pipe

■ = set iron bar

SCALE 1" = 20'

JOB # 15-259

TAX ID #
JLCB 00765 / 00767

BASIS OF BEARING OF THIS PLAT: THE SOUTH LINE OF WOODLAND WAS ASSUMED TO BEAR N 88°44' W

I hereby certify that I have surveyed the above- described property and the above map is a is a true representation thereof and shows the size and location of the property, its exterior boundaries, the location and dimensions of all structures thereon, fences, apparant easements and roadways and visible encroachments if any.

This survey is made for the present owners of the property, and those who purchase, mortgage, or guarantee the title thereto, within one year from the date hereof.

DATED THIS 14TH DAY OF AUGUST, 2015.

RECEIVED
DEC 30 2015
By SMF

WISCONSIN
JEFFREY L. KIMPS S-2436 LAKE GENEVA. WIS.
LAND SURVEYOR

JEFFREY L KIMPS S - 2436
Wisconsin Professional Land Surveyor
(original if signed in red)