


JAN 28 2016



JCN 19-5 JCN 19-6

217 4186

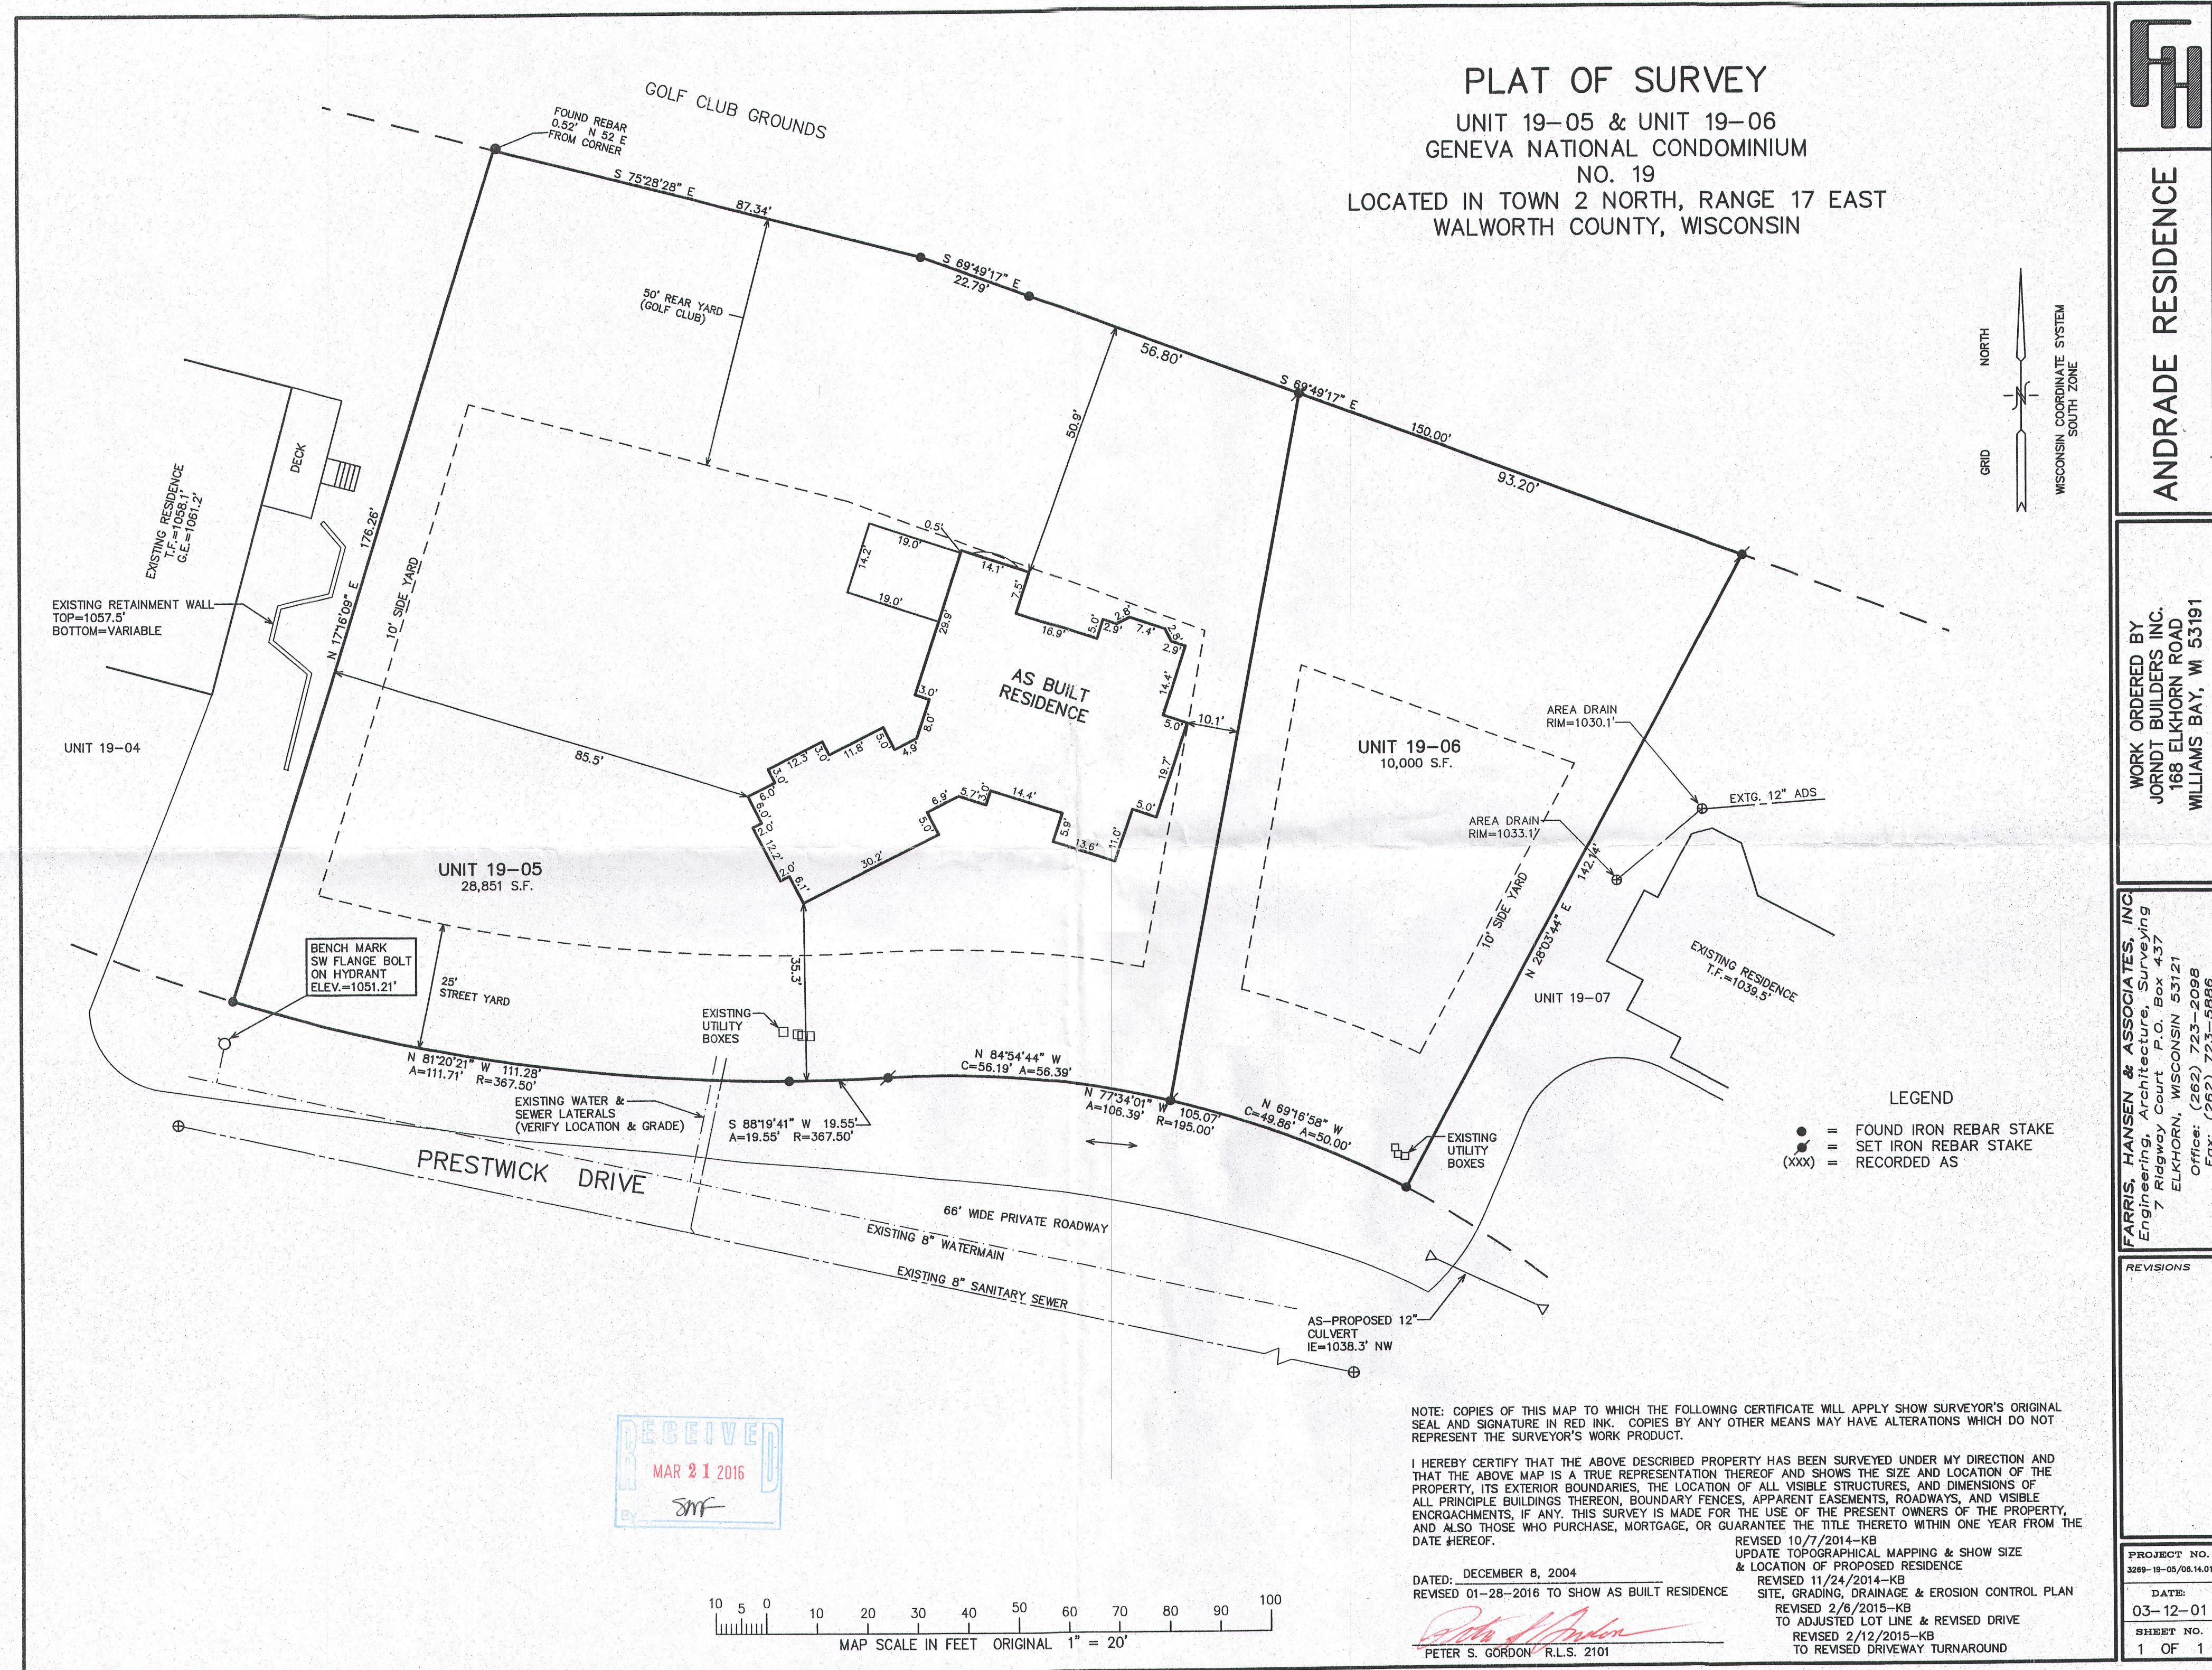

**ANDRADE RESIDENCE**

WORK ORDERED BY  
JORDNT BUILDERS INC.  
188 ELKHORN ROAD  
WILLIAMS BAY, WI 53191

**FARRIS, HANSEN & ASSOCIATES, INC.**  
Engineering, Architecture, Surveying  
7 Ridgeway Court P.O. Box 437  
ELKHORN, WISCONSIN 53121  
Office: (262) 723-2098  
Fax: (262) 723-5886

REVISIONS