
PREPARED FOR:
LAKE GENEVA AREA REALTY
101 BROAD ST
LAKE GENEVA, WI.


PATHFINDER SURVEYING INC.
P.O BOX 322
LAKE GENEVA, WI. 53147
WWW.PATHFINDERSURVEYING.NET
262-248-8303


PLAT OF SURVEY

- OF -

LOT 3 OF WALWORTH COUNTY CERTIFIED SURVEY MAP No. 3915, AS RECORED IN VOLUME 24 OF CERTIFIED SURVEYS, ON PAGE 43 AT THE WALWORTH COUNTY REGISTER OF DEEDS, LOCATED IN THE NE 1/4 AND NW 1/4 OF THE SW 1/4 OF SECTION 14, TOWN 2 NORTH, RANGE 17 EAST, TOWN OF GENEVA, COUNTY OF WALWORTH AND STATE OF WISCONSIN.

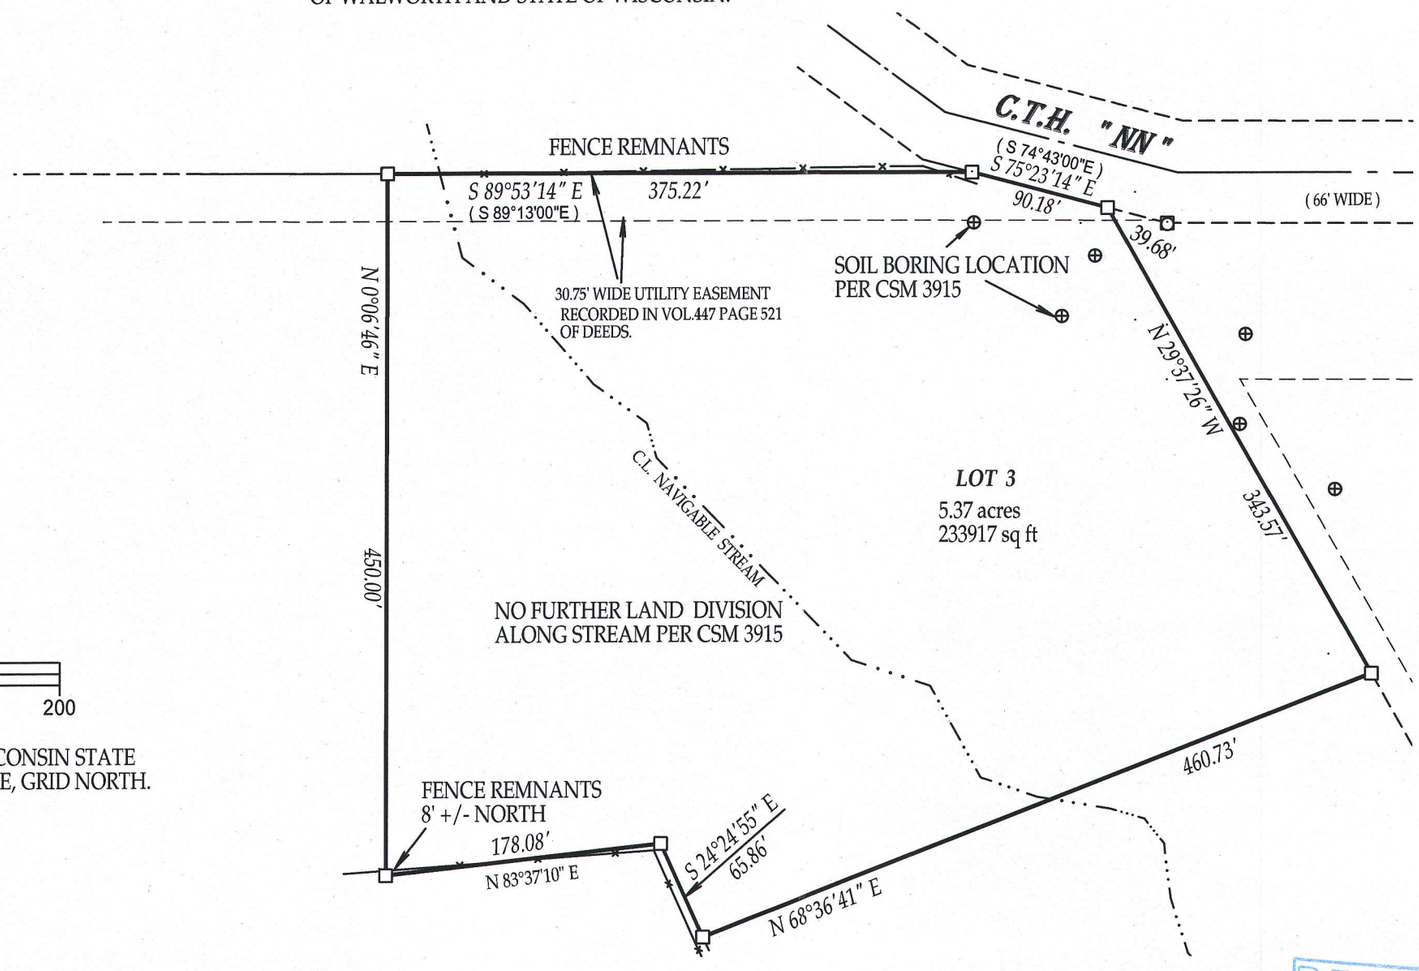

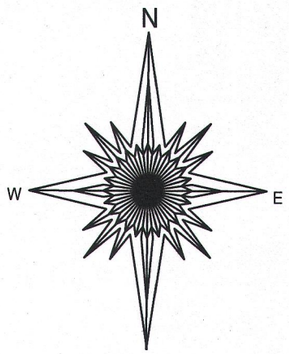

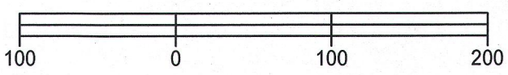

BASIS OF BEARING OF THIS PLAT: THE WISCONSIN STATE PLANE COORDINATE SYSTEM, SOUTH ZONE, GRID NORTH.

( )= recorded as

□ = found iron bar

○ = found iron pipe

● = set iron pipe

■ = set iron bar

SCALE 1" = 100'

JOB # 16-60

TAX ID # JA391500003

"I hereby certify that I have surveyed the above described property and that the above map is a true representation thereof and shows the size and location of all visible structures, apparent easements and encroachments if any."
This survey is made for the present owners of the property, and those who purchase, mortgage, or guarantee the title thereto, within one year from the date hereof.

DATED THIS 18TH DAY OF MARCH, 2016.

RECEIVED
MAY 10 2016
By

WISCONSIN
JEFFREY L. KIMPS
S-2436
LAKE GENEVA. WIS.
LAND SURVEYOR

JEFFREY L. KIMPS S-2436
Wisconsin Professional Land Surveyor
(original if signed in red)

JA 3915-3 217-4197