


PLAT OF SURVEY
LOTS 5538 THROUGH 5545 OF BLOCK 99 OF LAKE COMO BEACH SUBDIVISION
LOCATED IN THE SOUTHEAST 1/4 OF THE NORTHEAST 1/4 OF SECTION 28, TOWN 2 NORTH, RANGE 17 EAST, WALWORTH COUNTY, WISCONSIN

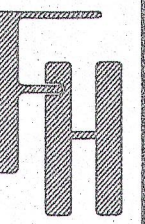

WORK ORDERED BY -
MARIA KURAWSKI
N3158 EVERGREEN ROAD
LAKE GENEVA, WI 53147

FARRIS, HANSEN & ASSOCIATES, INC.
ENGINEERING - ARCHITECTURE - SURVEYING
7 RIDGWAY COURT P.O. BOX 437
ELKHORN, WISCONSIN 53121
OFFICE: (262) 723-2098 FAX: (262) 723-5886


REVISIONS

PROJECT NO.
9538



DATE:
06/17/2016

SHEET NO.
1 OF 1

ASSIGNED THE EASTERLY BOUNDARY OF
LANDS SURVEYED S 00°20'04" W

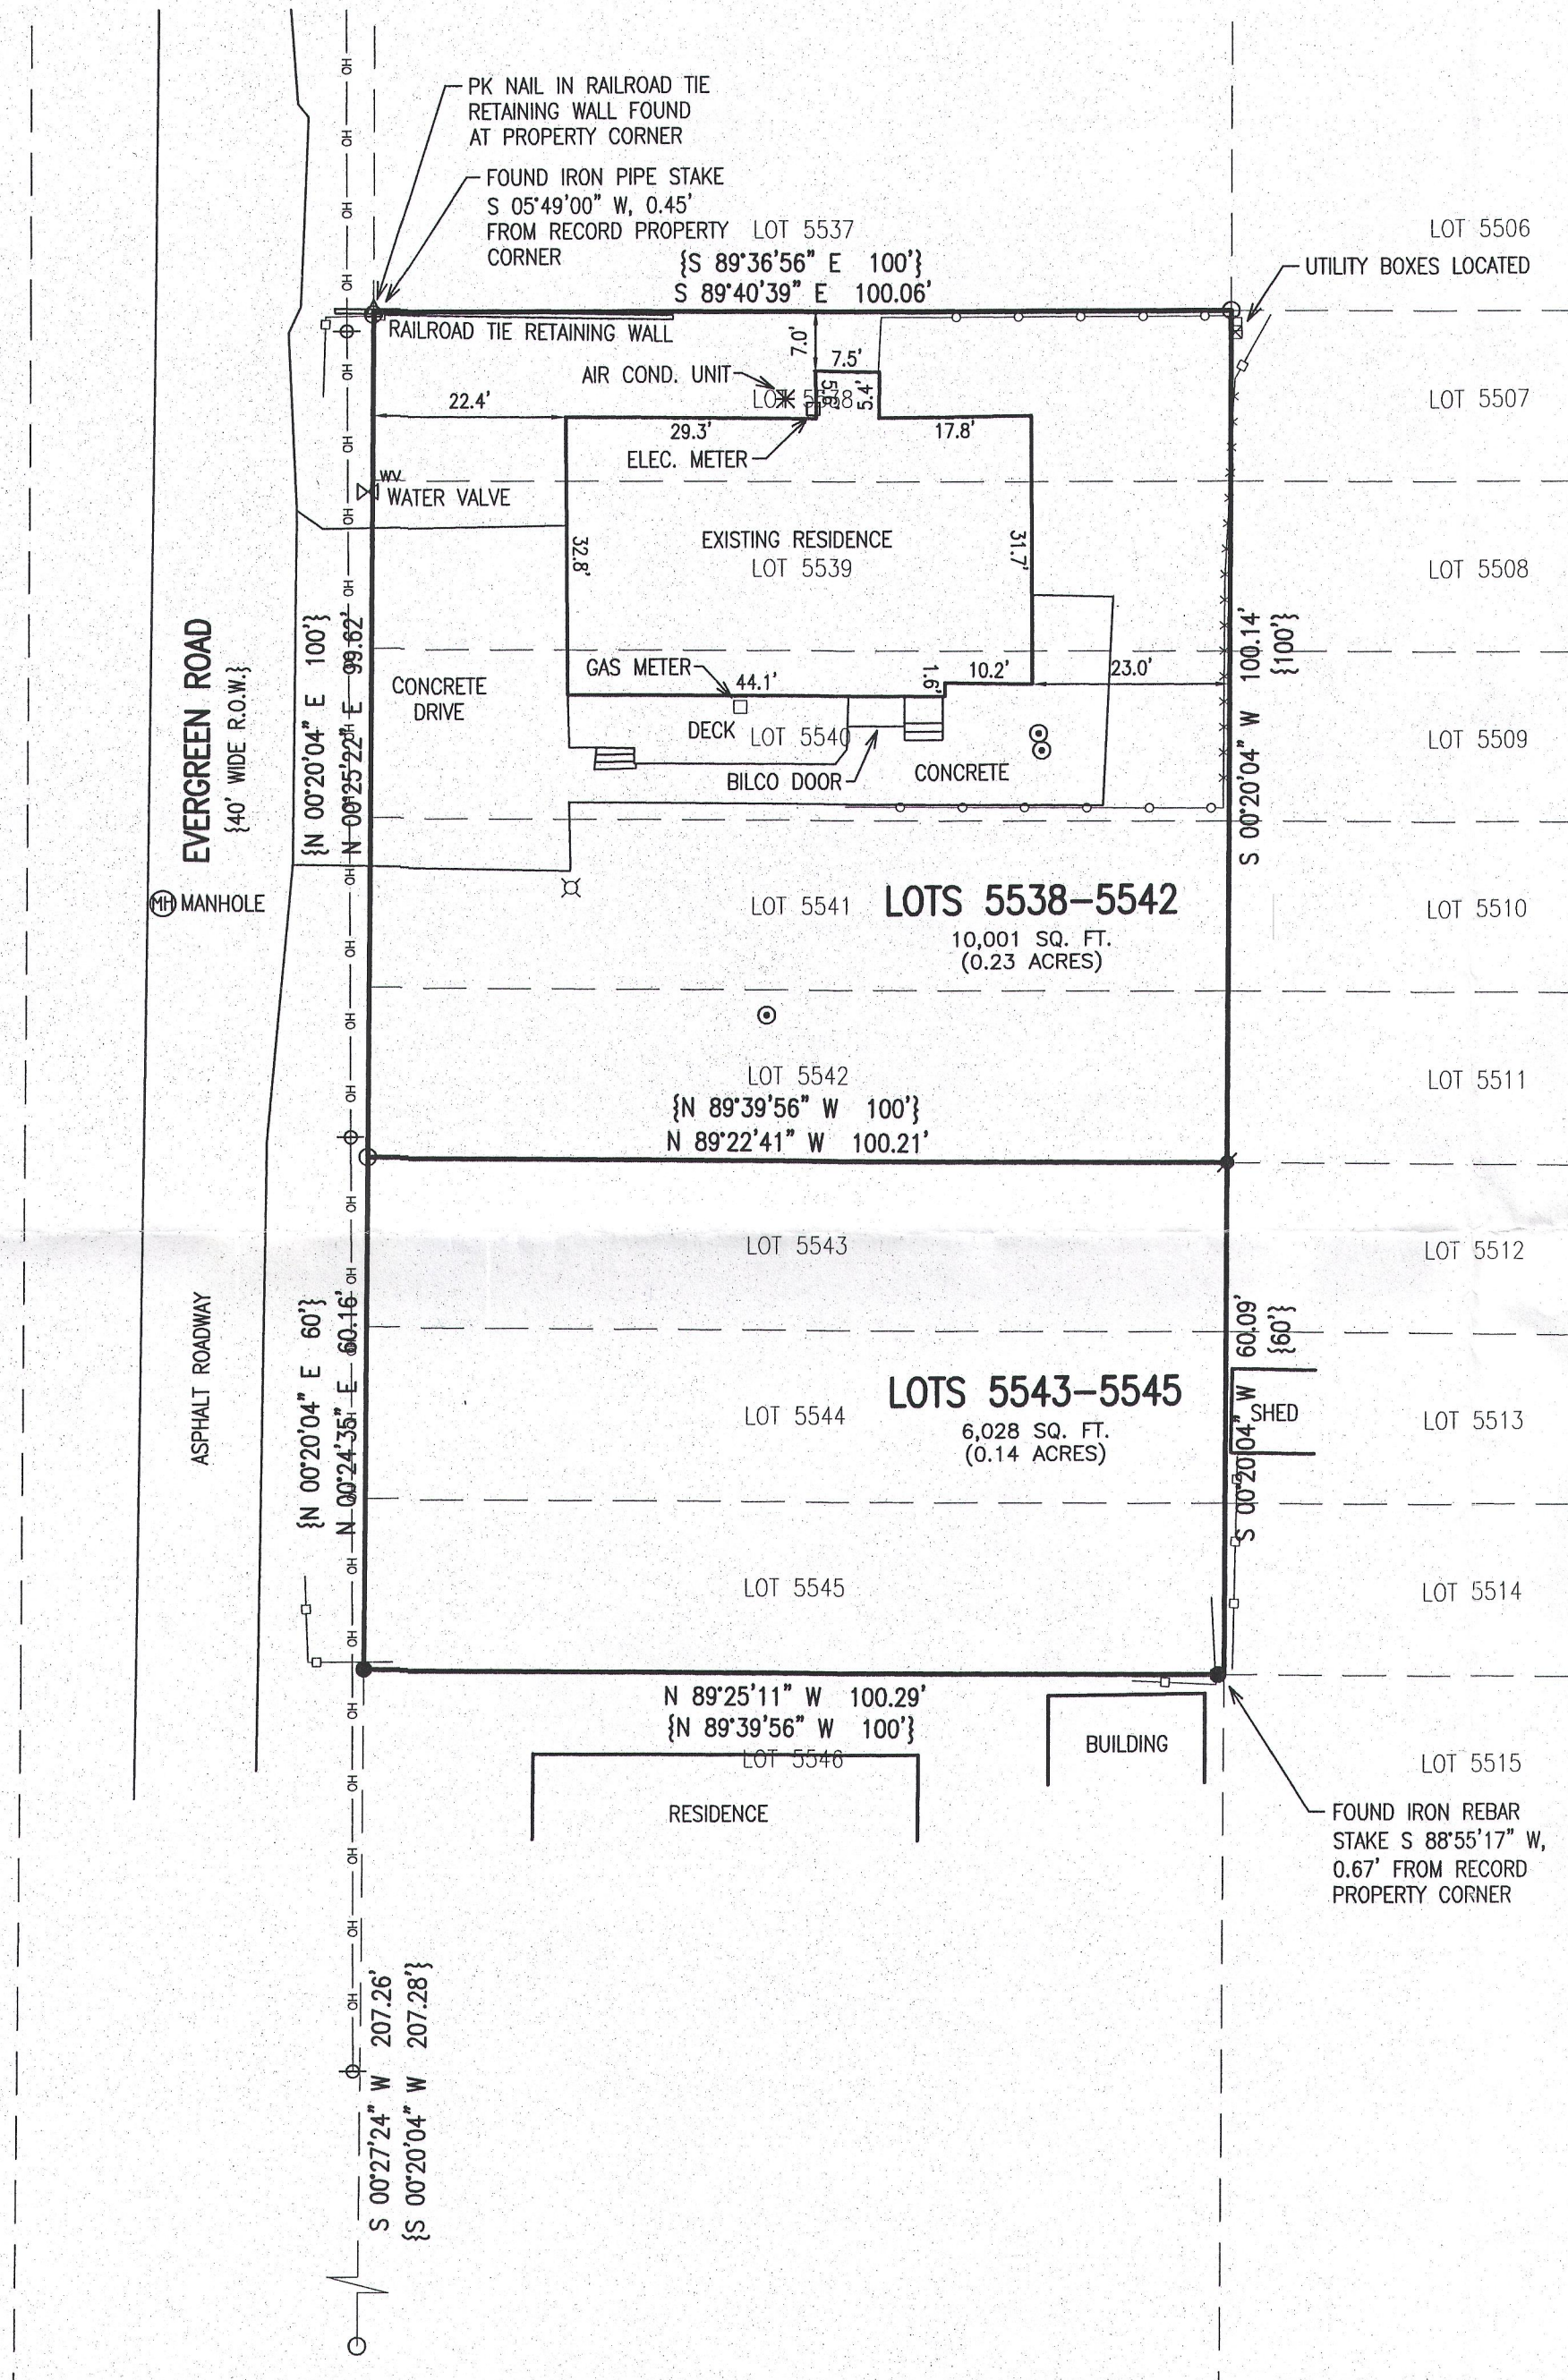

- LEGEND
- = FOUND IRON PIPE STAKE
 - = FOUND IRON REBAR STAKE
 - △ = FOUND PK NAIL
 - ⦿ = SET IRON REBAR STAKE, 3/4" DIA.
 - = WOOD FENCE LOCATED
 - x—x—x— = WIRE FENCE LOCATED
 - = CHAINLINK FENCE LOCATED
 - ⊕ = UTILITY POLE LOCATED
 - OH— = OVERHEAD WIRES
 - ⋈ = LIGHT POLE LOCATED
 - ⊙ = CLEANOUT LOCATED
 - {XXX} = RECORDED AS

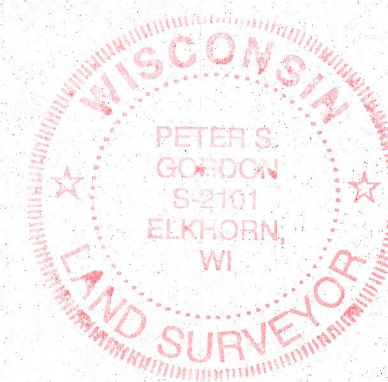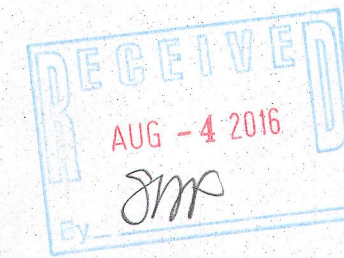

NOTE: COPIES OF THIS MAP TO WHICH THE FOLLOWING CERTIFICATE WILL APPLY SHOW THE SURVEYOR'S ORIGINAL SEAL AND SIGNATURE IN RED INK. COPIES BY ANY OTHER MEANS MAY HAVE ALTERATIONS WHICH DO NOT REPRESENT THE SURVEYOR'S WORK PRODUCT.

I HEREBY CERTIFY THAT THE ABOVE DESCRIBED PROPERTY HAS BEEN SURVEYED UNDER MY DIRECTION AND THAT THE ABOVE MAP IS A TRUE REPRESENTATION THEREOF AND SHOWS THE SIZE AND LOCATION OF THE PROPERTY AND ITS EXTERIOR BOUNDARIES. THIS SURVEY IS MADE FOR THE USE OF THE PRESENT OWNERS OF THE PROPERTY, AND ALSO THOSE WHO PURCHASE, MORTGAGE, OR GUARANTEE THE TITLE THERETO WITHIN ONE YEAR FROM THE DATE HEREOF.

DATED: 6/17/2016

Peter S. Gordon
PETER S. GORDON P.L.S. 2101

MAP SCALE IN FEET - ORIGINAL 1"=20'

X:\PROJECTS\9538\ACAD\9538 Survey.dwg

JLCB 1124 JLCB 1125

217.4221