
FARRIS, HANSEN & ASSOCIATES, INC.

ENGINEERING – ARCHITECTURE – SURVEYING
7 RIDGWAY COURT – P.O. BOX 437 – ELKHORN, WISCONSIN 53121
PHONE: (262) 723–2098 FAX: (262) 723–5886

PLAT OF SURVEY

LOTS 5341 THRU 5347 BLOCK 95
LAKE COMO BEACH SUBDIVISION
LOCATED IN SEC.'S 21 & 28
T2N, R17 E, WALWORTH COUNTY, WI.

– WORK ORDERED BY –
ALICE WINN.
W3804 LAKEVIEW DRIVE
LAKE GENEVA, WI. 53147

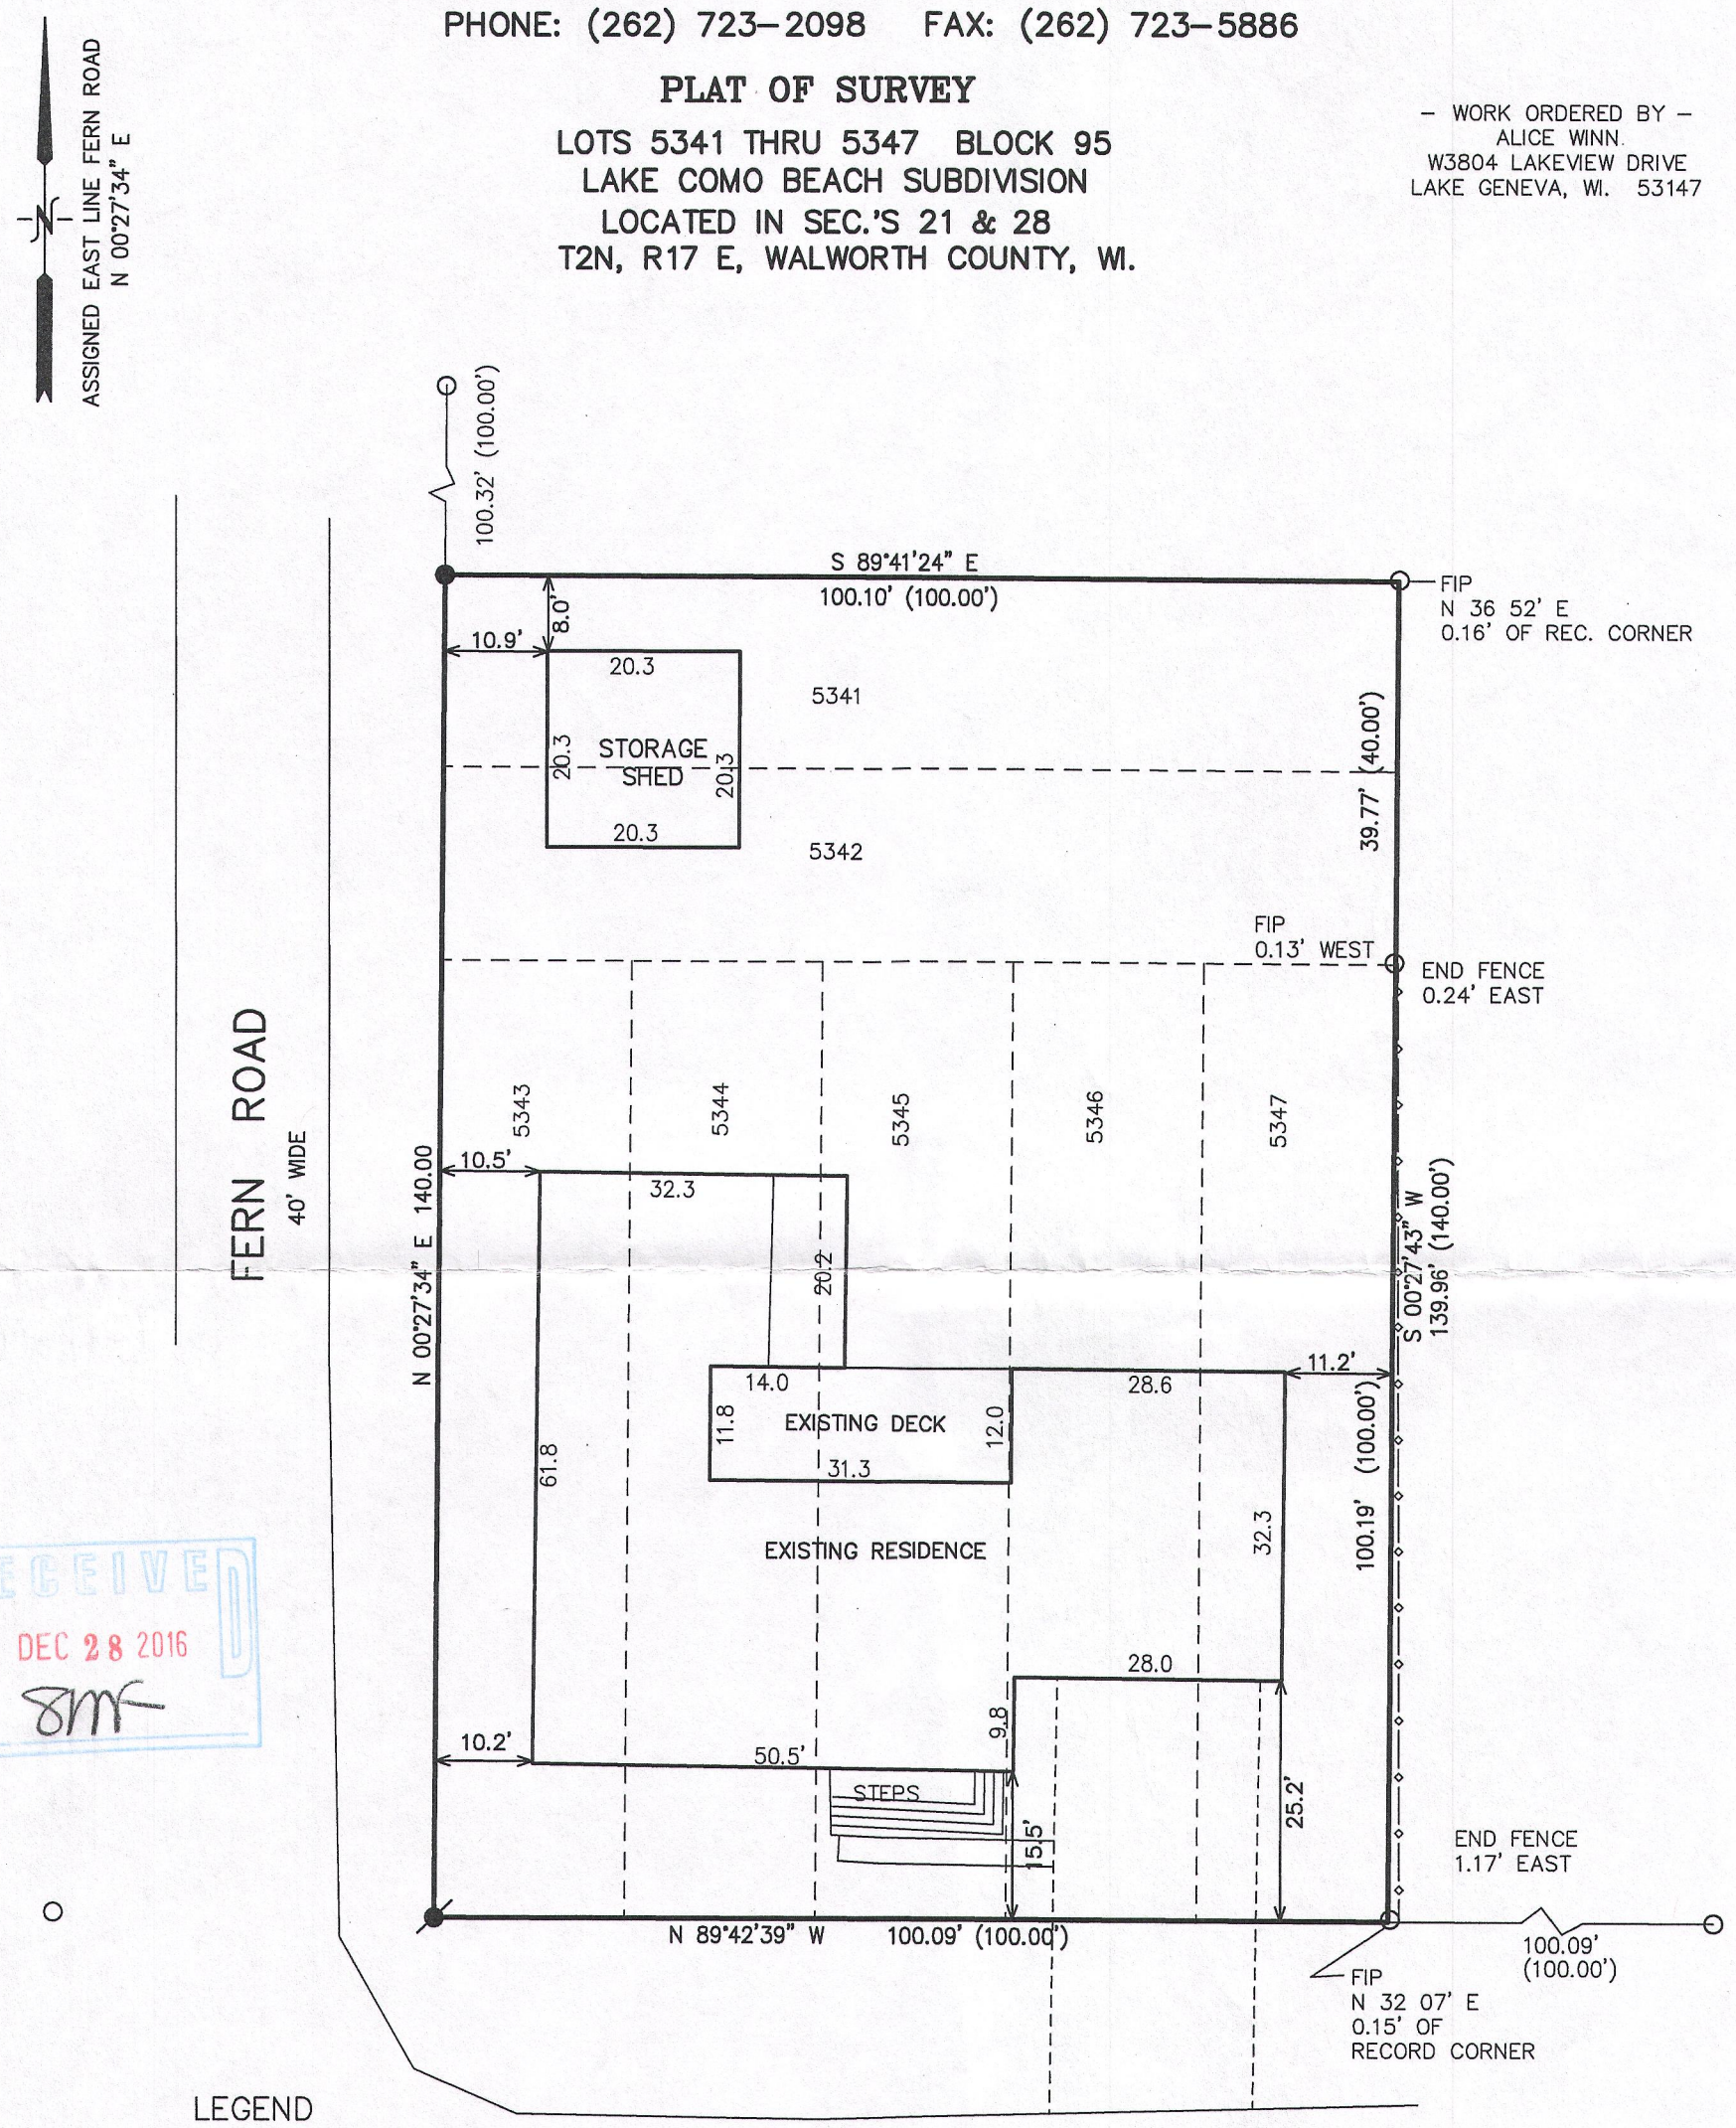

LINCOLN DRIVE (AKA LAKEVIEW)
40' WIDE

LEGEND
○ = FOUND IRON PIPE STAKE
● = FOUND IRON REBAR STAKE
⦿ = FOUND IRON PIPE STAKE
(XXX) = RECORDED AS

10 5 0 10 20 30 40 50 60 70 80 90 100
MAP SCALE IN FEET ORIGINAL 1" = 20'

NOTE: COPIES OF THIS MAP TO WHICH THE FOLLOWING CERTIFICATE WILL APPLY SHOW SURVEYOR'S ORIGINAL SEAL AND SIGNATURE IN RED INK. COPIES BY ANY OTHER MEANS MAY HAVE ALTERATIONS WHICH DO NOT REPRESENT THE SURVEYOR'S WORK PRODUCT.

I HEREBY CERTIFY THAT THE ABOVE DESCRIBED PROPERTY HAS BEEN SURVEYED UNDER MY DIRECTION AND THAT THE ABOVE MAP IS A TRUE REPRESENTATION THEREOF AND SHOWS THE SIZE AND LOCATION OF THE PROPERTY AND ITS EXTERIOR BOUNDARIES. THIS SURVEY IS MADE FOR THE USE OF THE PRESENT OWNERS OF THE PROPERTY, AND ALSO THOSE WHO PURCHASE, MORTGAGE, OR GUARANTEE THE TITLE THERETO WITHIN ONE YEAR FROM THE DATE HEREOF.

REVISED: 8/10/2007–KB
ADJUST PROPOSED ADDITONS

DATED: MAY 30, 2006

PETER S. GORDON R.L.S. 2101

REVISED 11–04–2016
TO SHOW EXISTING
IMPROVEMENTS

WISCONSIN
PETER S. GORDON
S-2101
ELKHORN, WI
LAND SURVEYOR

PROJECT: 7070
DATE: 05–30–2006
SHEET 1 OF 1

RECEIVED
DEC 28 2016
By SMF

11/7/2016 X:\Projects\7070\DCAD\ASBUILT2016

NOV 07 2016 JLCB-1077

217-4261