


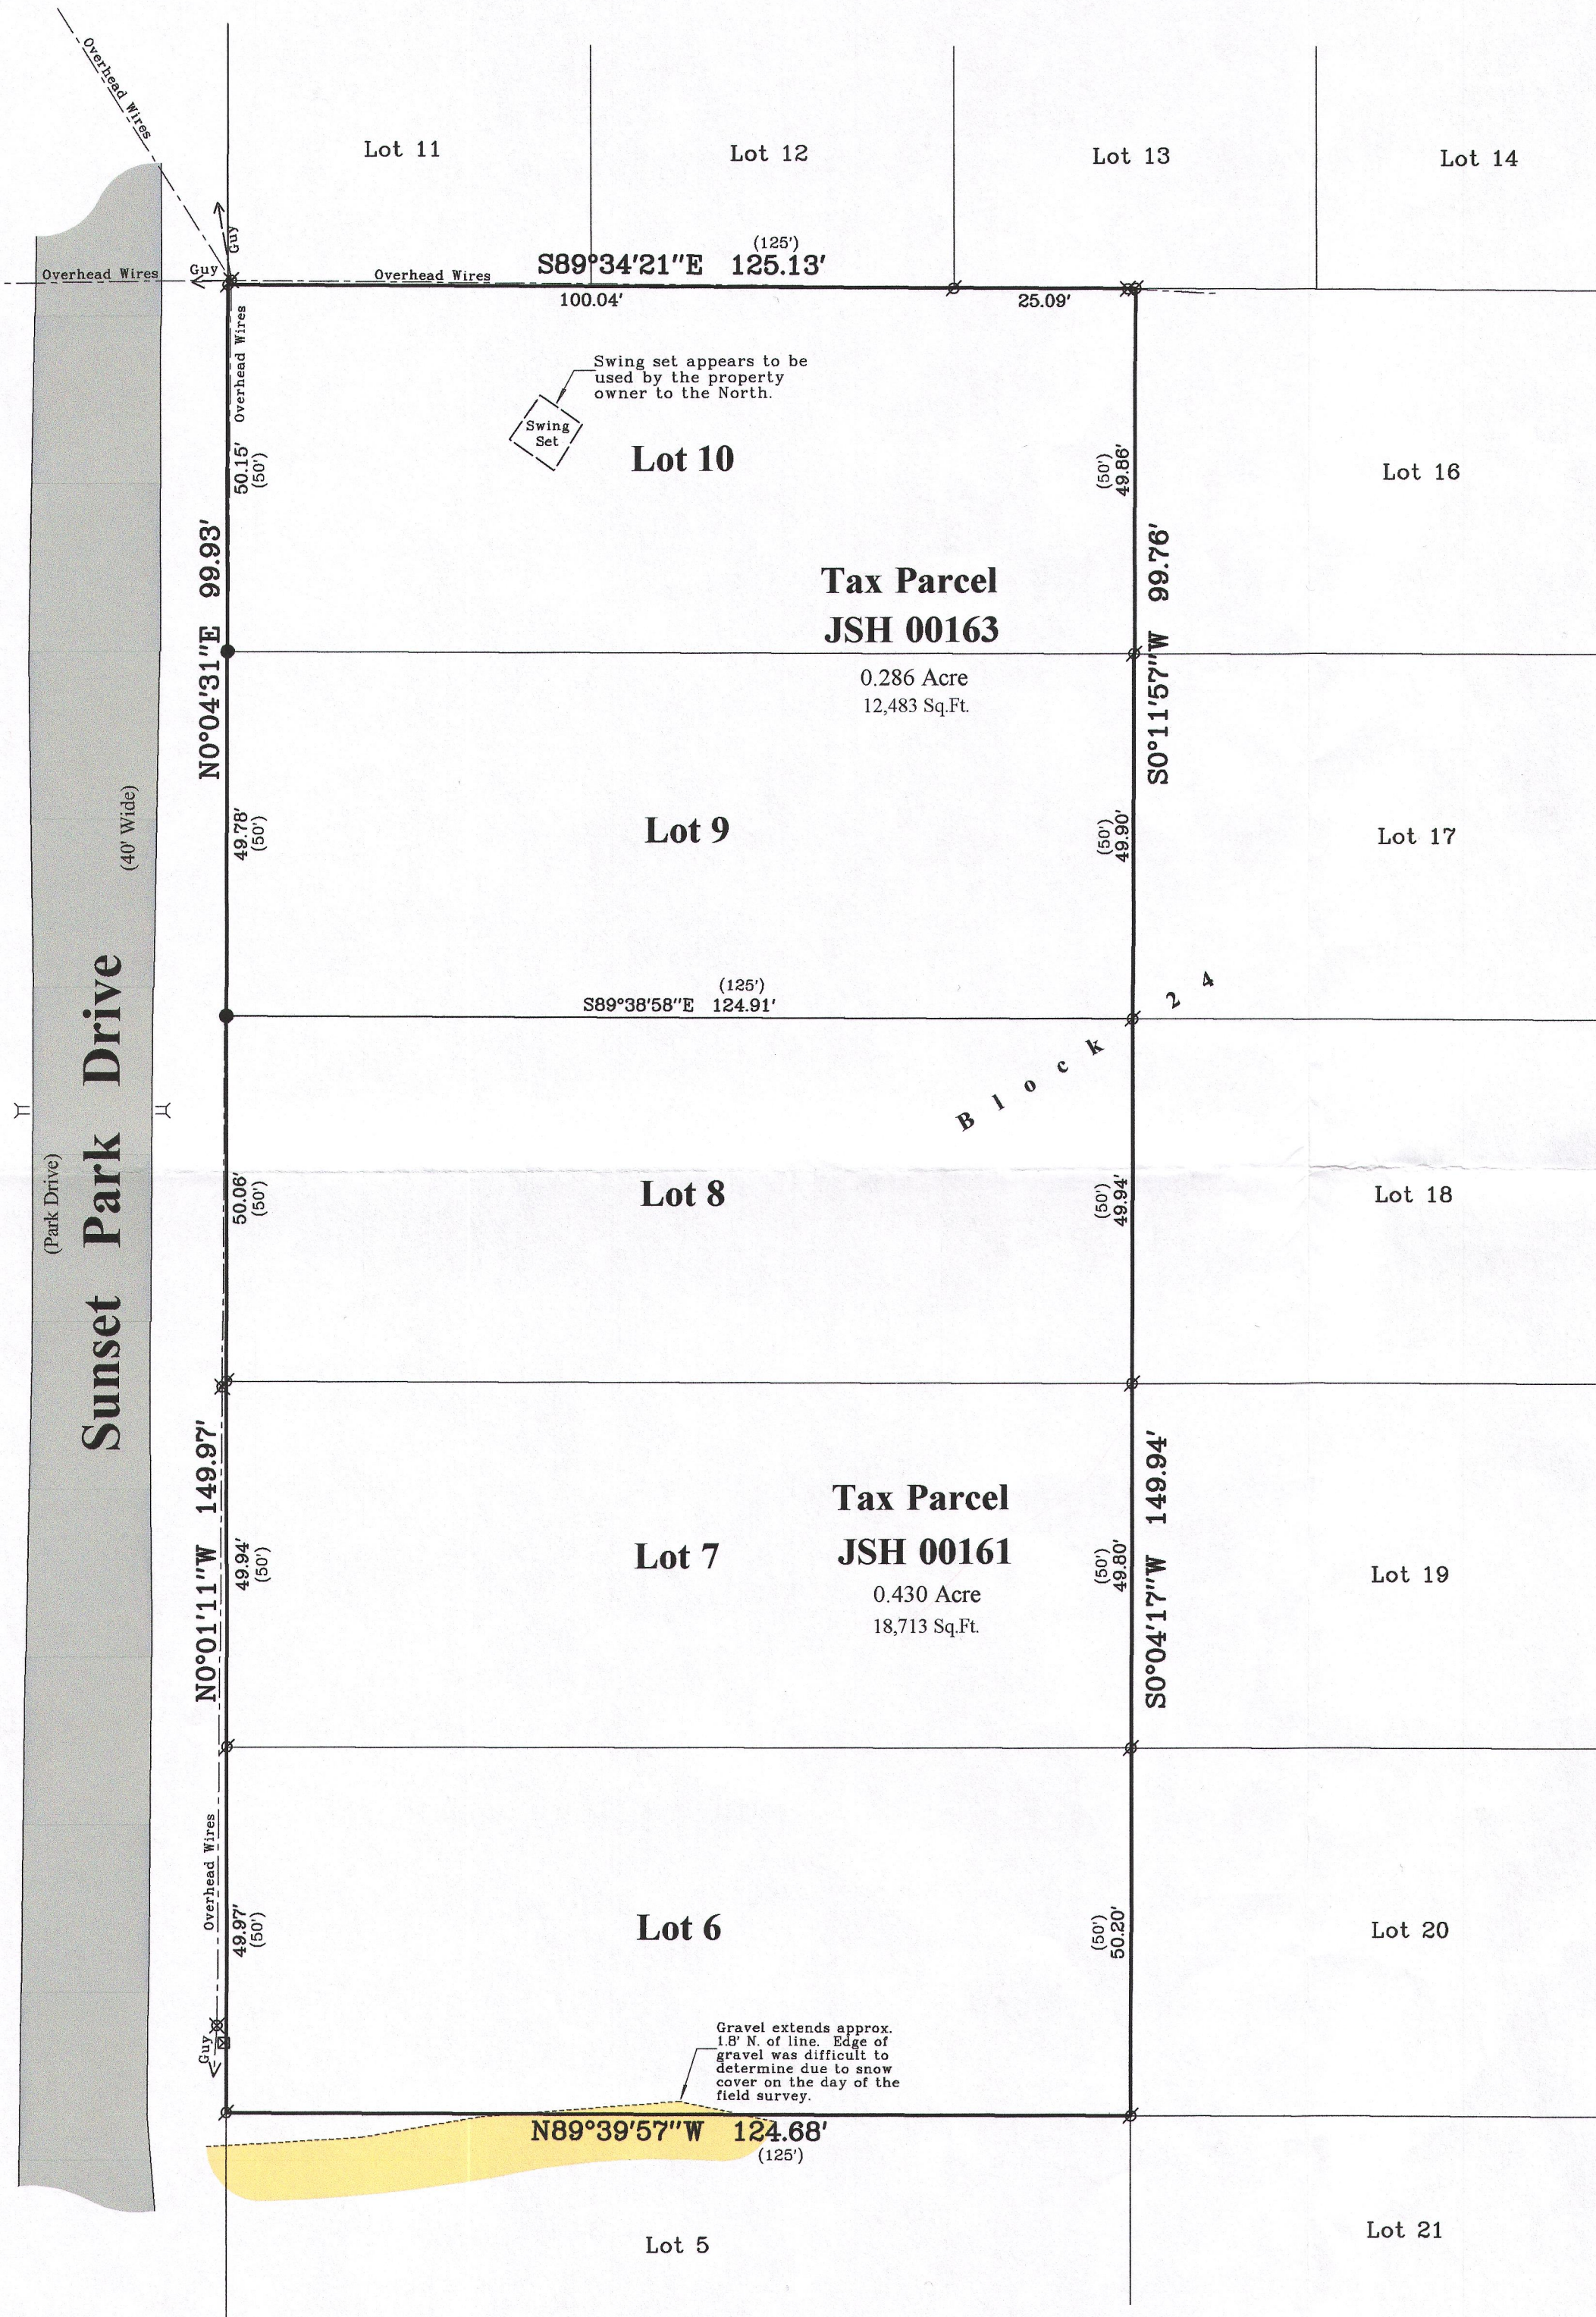

Plat of Survey


of

Lots 6 through 10 of Block 24 of Sunset Hills (Unit "B"),


a subdivision located in the Southwest 1/4 of Section 33,
Town 2 North, Range 17 East, Town of Geneva,
Walworth County, Wisconsin.

Surveyed for: **RE/MAX Geneva Realty, Ltd.**

101 Broad Street, Suite 102
Lake Geneva, Wisconsin 53147

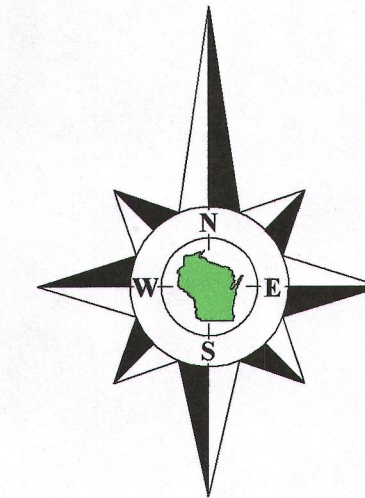

Bearings reference to prior
surveys of record.

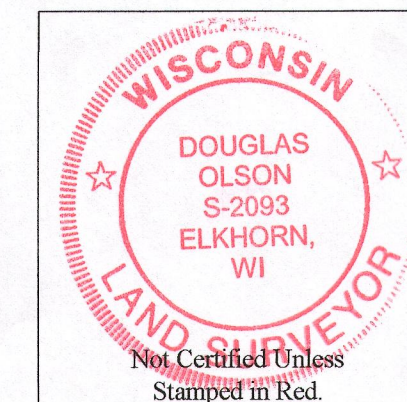

Notes:

- 1) This survey plat is not certified unless signed and sealed in red ink.
- 2) This survey is subject to Wisconsin lien laws. This Plat of Survey is the notice of intent to file lien. Lien waiver required.

Copyright 2017 by Olson Land Surveying, LLC.


All rights reserved. No part of this survey plat may be reproduced or transmitted in any form by any means - graphic, electronic, or mechanical, including photocopying, tracing, or information storage and retrieval systems - without permission in writing from Douglas G. Olson, Olson Land Surveying, LLC.

I hereby certify that I have surveyed the above described property and the map hereon is correct to the best of my professional knowledge and belief and shows the size and location of the property, its exterior boundaries, the location and dimensions of all visible structures thereon, boundary fences, apparent easements and roadways and visible encroachments, if any.

This survey is made for the exclusive use of the present owners of the property, and also those who purchase, mortgage or guarantee title thereto, within one year from the date hereof.

Douglas G. Olson
Wisconsin Professional Land Surveyor - 2093

Survey Date: January 9, 2017.
Revisions:

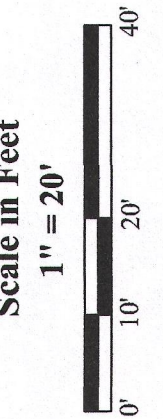

Olson Land Surveying, LLC
45 South Wisconsin Street * P.O. Box 322 * Elkhorn, Wisconsin. 53121
Telephone: (262) 723-3434 * Facsimile: (262) 723-8044
Email: doug@olsonsurveying.com



Legend
Found Iron Pipe
Found Iron Rod
Recorded Information
Utility Pole
Utility Pedestal
Asphalt Surface
Gravel Surface

Sheet 1 of 1 Sheets
Drawing Name
Job Reference Number
2016.140

2016.140

J84-161
J84-163

217-4289