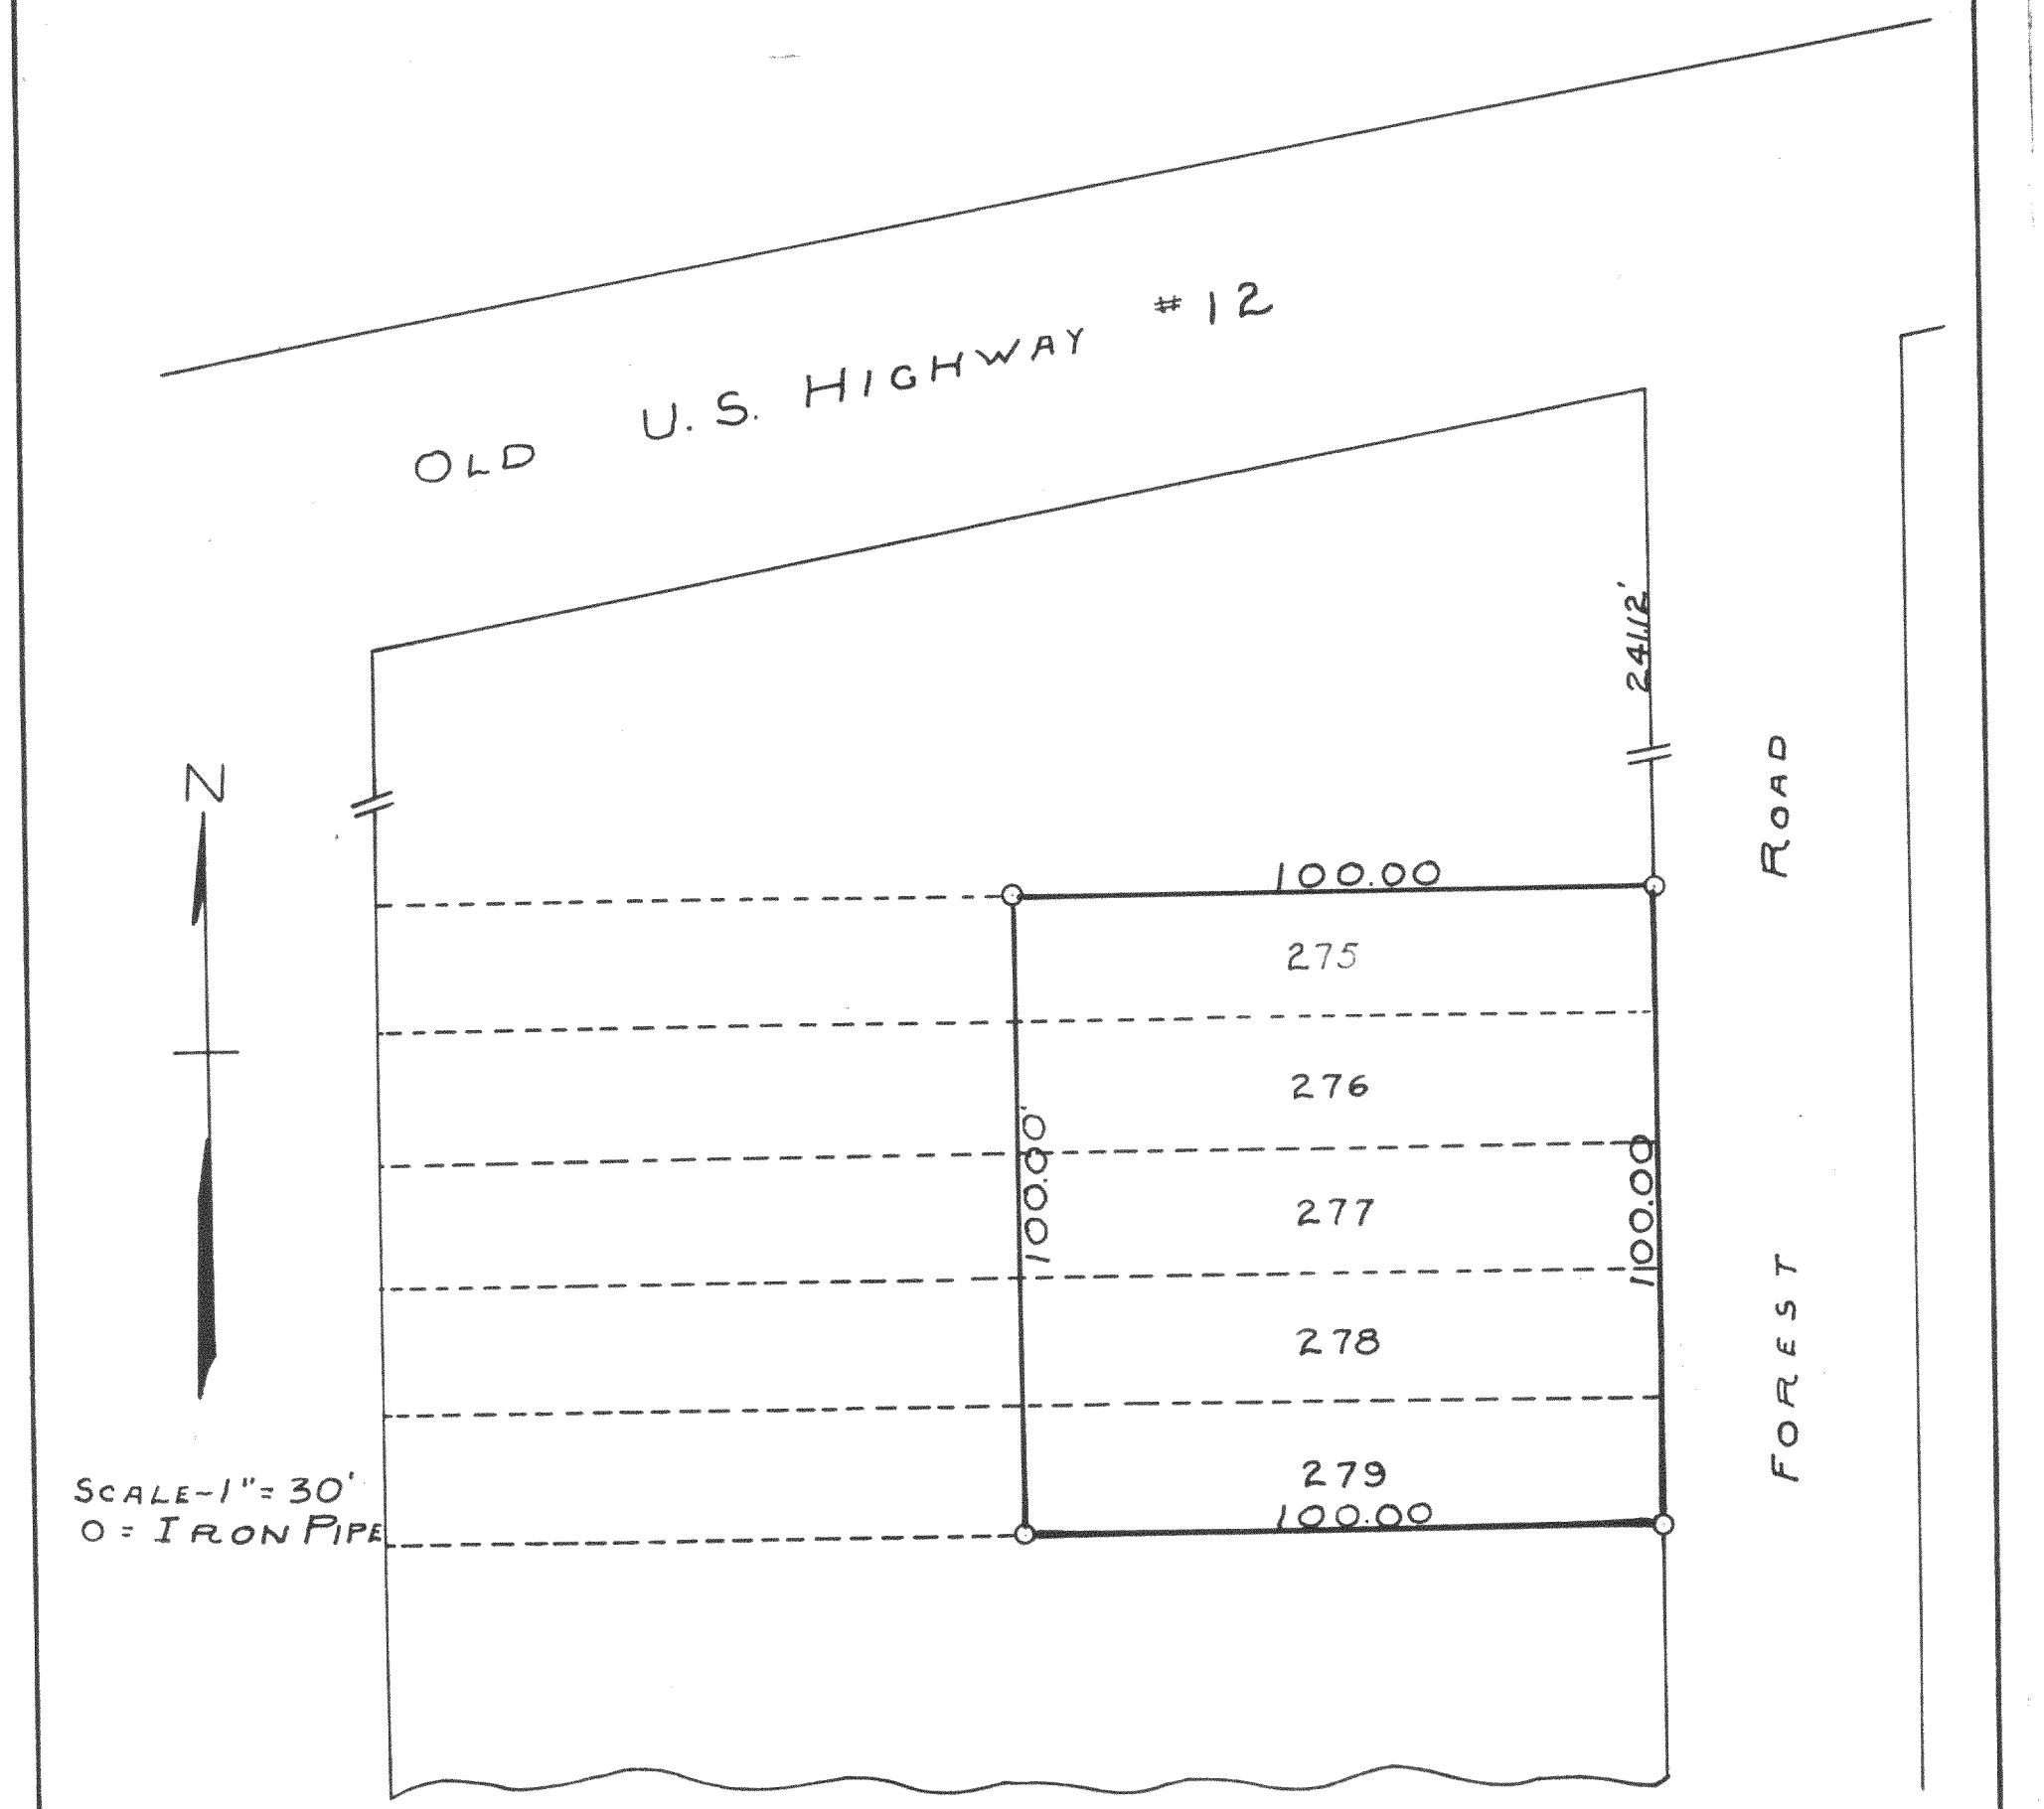


PLAT OF SURVEY OF LOTS 275-279 BLOCK 7
OF LAKE COMO BEACH SUBDIVISION LOCATED
IN SECTION 22, T2NR17E WALWORTH COUNTY
WISCONSIN
MARCH 4, 1949

Floyd L. Jensen
COUNTY SURVEYOR

JLCB-38R

217-43.1